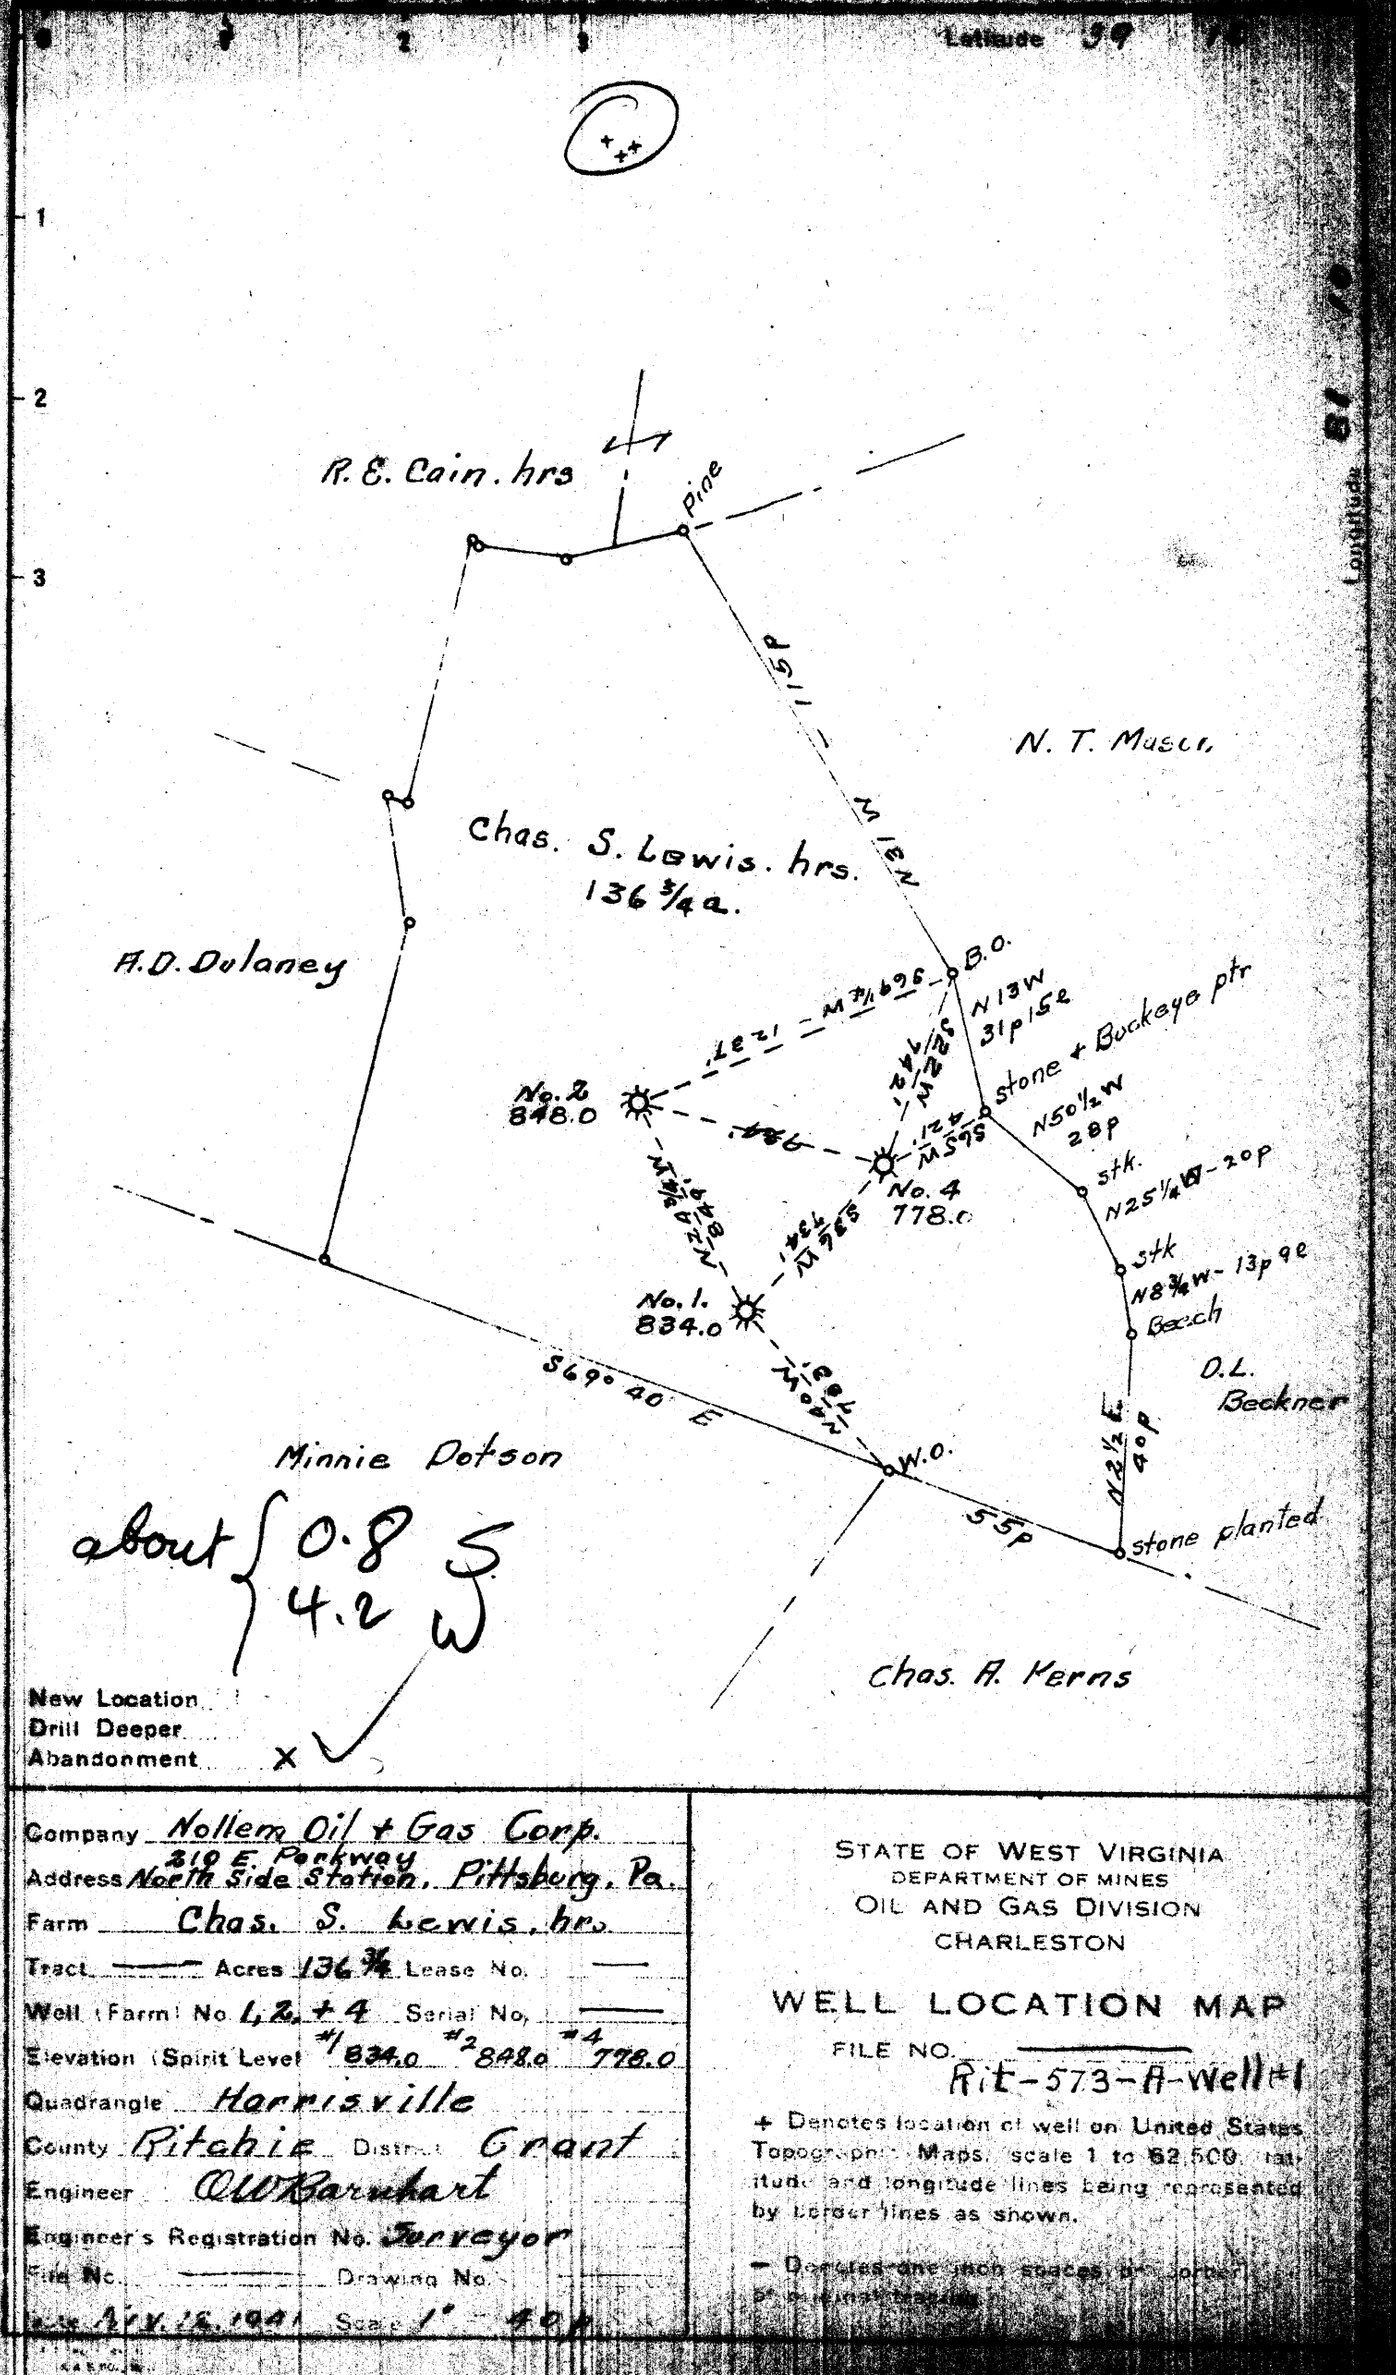

Company Nollem Oil + Gas Corp.
Address 210 E. Parkway North Side Station, Pittsburg, Pa.
Farm Chas. S. Lewis. hrs.
Tract —— Acres 136 3/4 Lease No. ——
Well (Farm) No. L.2. + 4 Serial No. ——
Elevation (Spirit Level) #1 834.0 #2 848.0 #4 778.0
Quadrangle Harrisville
County Ritchie District Grant
Engineer A.W. Barnhart
Engineer's Registration No. Surveyor
File No. —— Drawing No.
Date Nov. 12, 1941 Scale 1" = 400'

STATE OF WEST VIRGINIA
DEPARTMENT OF MINES
OIL AND GAS DIVISION
CHARLESTON

WELL LOCATION MAP

FILE NO. Rit-573-A-Well #1

+ Denotes location of well on United States Topographic Maps, scale 1 to 62,500, latitude and longitude lines being represented by border lines as shown.

— Denotes one inch spaces on border lines of 5' or minute spacing.