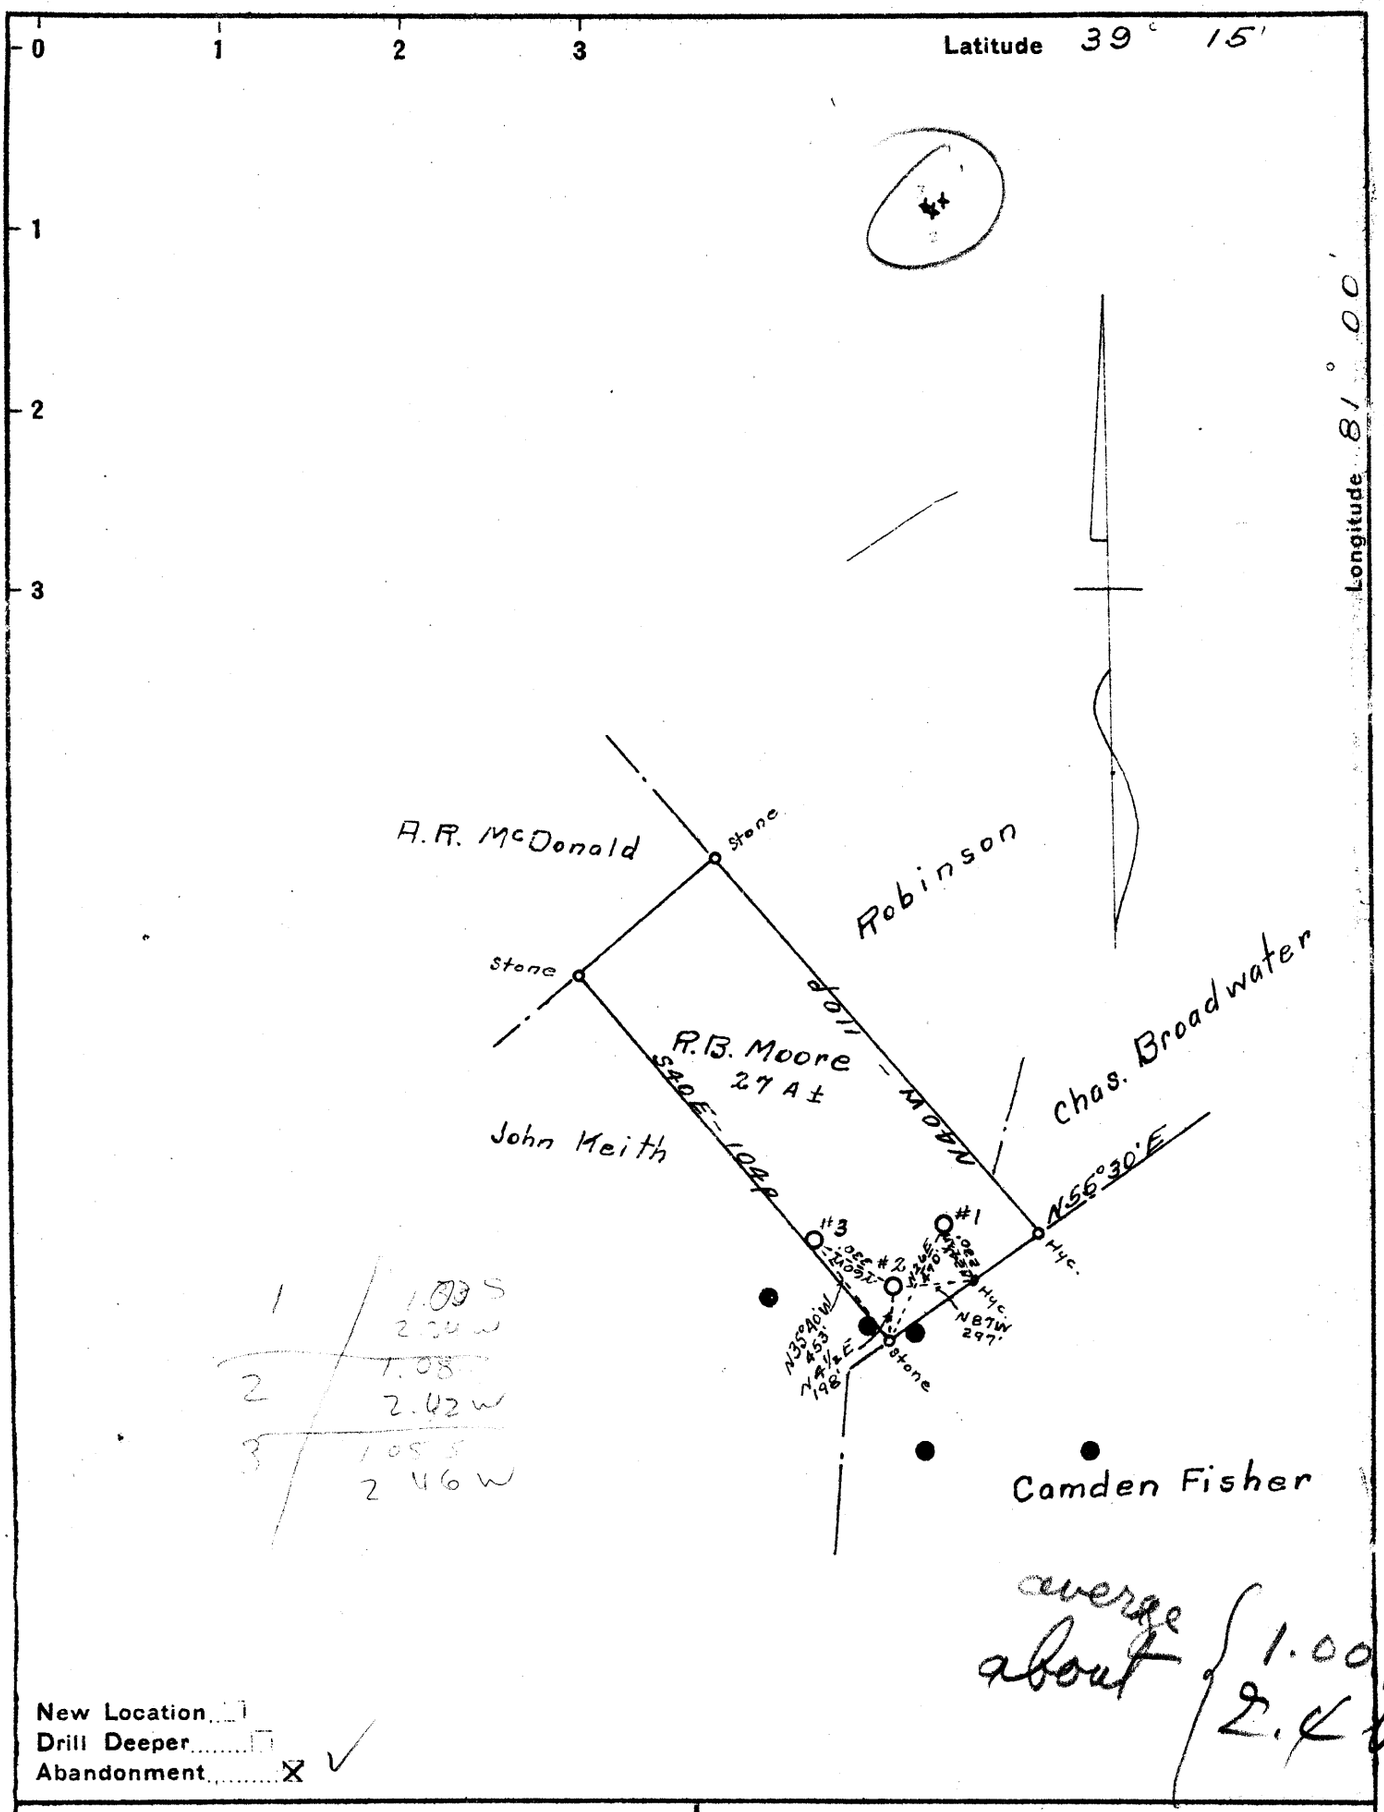

New Location ☐
Drill Deeper ☐
Abandonment X ✓

Company Reno Oil Co.
Address Sistersville, W.Va.
Farm R. B. Moore
Tract —— Acres 27± Lease No. ——
Well (Farm) No. 1-2 + 3 Serial No. ——
Elevation (Spirit Level) #1-895 #2 861 #3 875
Quadrangle Harrisville
County Ritchie District Clay
Engineer O.W. Barnhart
Engineer's Registration No. Surveyor
File No. —— Drawing No. ——
Date Sept. 20, 1941 Scale 1" = 40 poles

STATE OF WEST VIRGINIA
DEPARTMENT OF MINES
OIL AND GAS DIVISION
CHARLESTON

WELL LOCATION MAP

FILE NO. ——
RIT-576 - 577 - 578 - A
#1 #2 #3

+ Denotes location of well on United States Topographic Maps, scale 1 to 62,500, latitude and longitude lines being represented by border lines as shown.

— Denotes one inch spaces on border line of original tracing.

"IMPERIAL" TRACING CLOTH
K & E CO., N. Y.