Latitude 39° 10'

Longitude 81° 05'

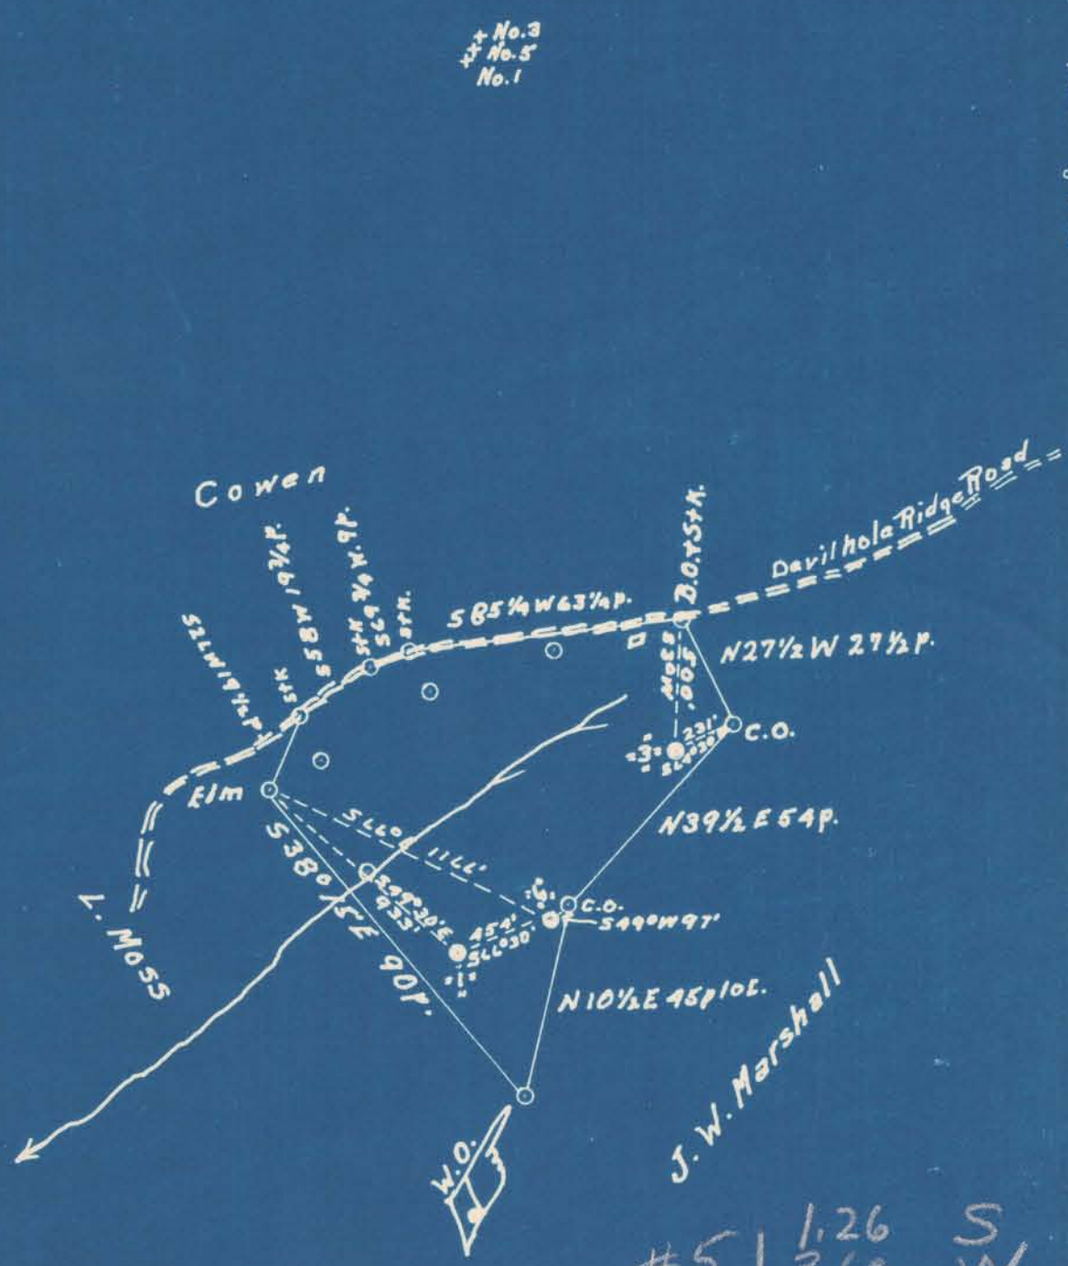

#5	1.26	S
	3.60	W
#1	1.32	S
	3.64	W
#3	1.19	S
	3.56	W

New Location ☐
Drill Deeper ☐
Abandonment ☒

Company Z. N. Conley
Address Grantsville, W.Va.
Farm E. Buck
Tract _____ Acres 30 Lease No. _____
Well (Farm) No. #1 #5 #3 Serial No. _____
Elevation (Spirit Level) #1 (995') #5 (1030') #3 (1005)
Quadrangle Harrisville
County Ritchie District Grant
Engineer Bruce Ferrell, Jr
Engineer's Registration No. _____
File No. _____ Drawing No. _____
Date May 15, 1942 Scale 40 P. = 1"

STATE OF WEST VIRGINIA
DEPARTMENT OF MINES
OIL AND GAS DIVISION
CHARLESTON

WELL LOCATION MAP

FILE NO. RIT-599-A #1

#5 - 60 P-A - #3 - 6 P-A

+ Denotes location of well on United States Topographic Maps, scale 1 to 62,500, latitude and longitude lines being represented by border lines as shown.

— Denotes one inch spaces on border line of original tracing.

"IMPERIAL" TRACING CLOTH
K & E CO., N. Y.