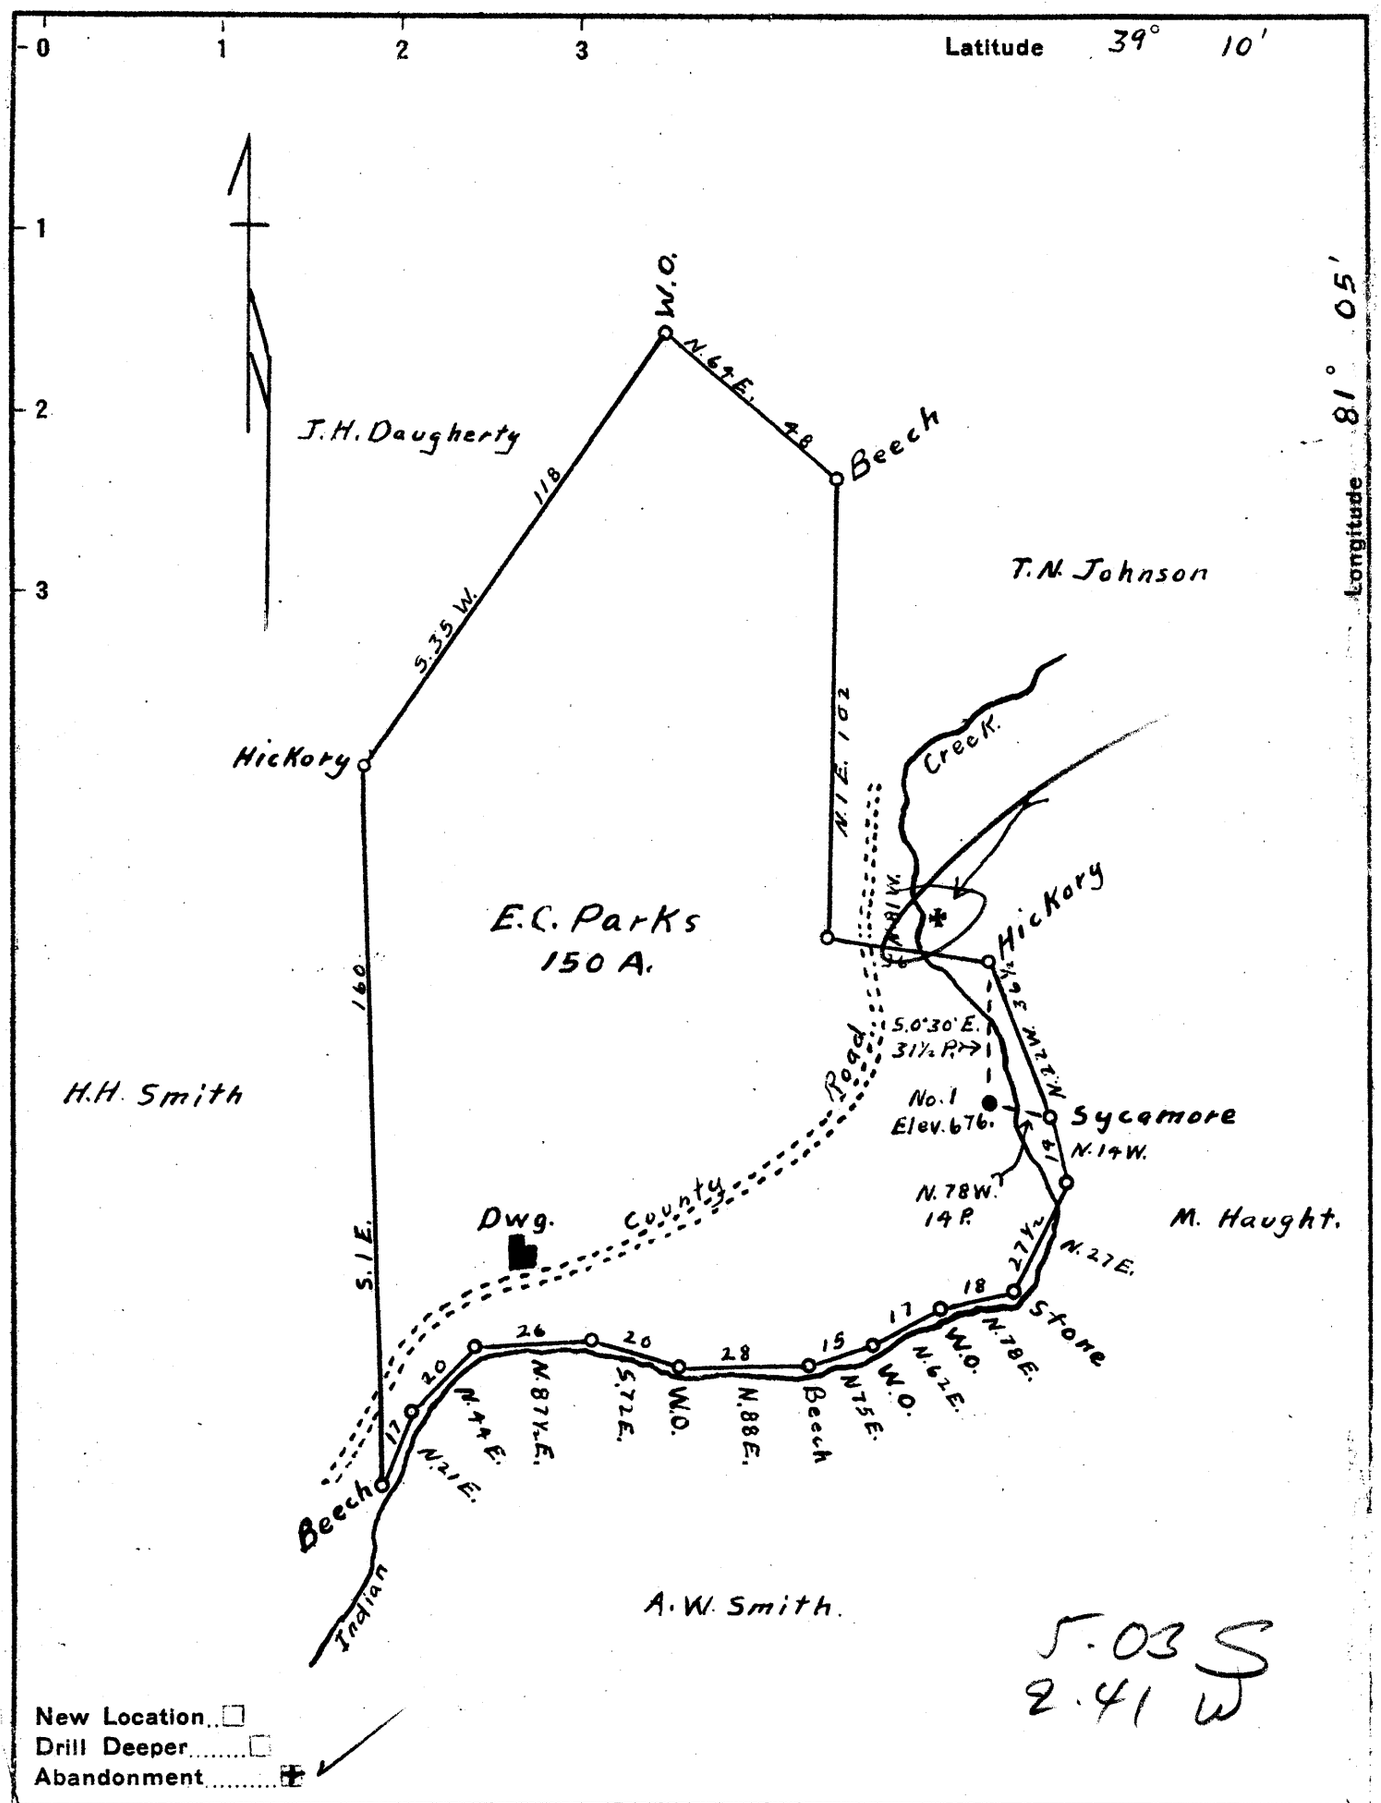

Company Z. N. Connolly
Address Grantsville, W. Va.
Farm E. C. Parks
Tract _____ Acres 150 Lease No. _____
Well (Farm) No. One Serial No. _____
Elevation (Spirit Level) 676
Quadrangle Harrisville
County Ritchie District Murphy
Engineer A. K. Westfall
Engineer's Registration No. Surveyor, Ritchie Co.
File No. _____ Drawing No. _____
Date Sept. 30, 1942 Scale 1" = 40 Poles

STATE OF WEST VIRGINIA
DEPARTMENT OF MINES
OIL AND GAS DIVISION
CHARLESTON

WELL LOCATION MAP

FILE NO. Rit-642-A

+ Denotes location of well on United States Topographic Maps, scale 1 to 62,500, latitude and longitude lines being represented by border lines as shown.

— Denotes one inch spaces on border line of original tracing.

"IMPERIAL" TRACING CLOTH
K & E CO., N. Y.