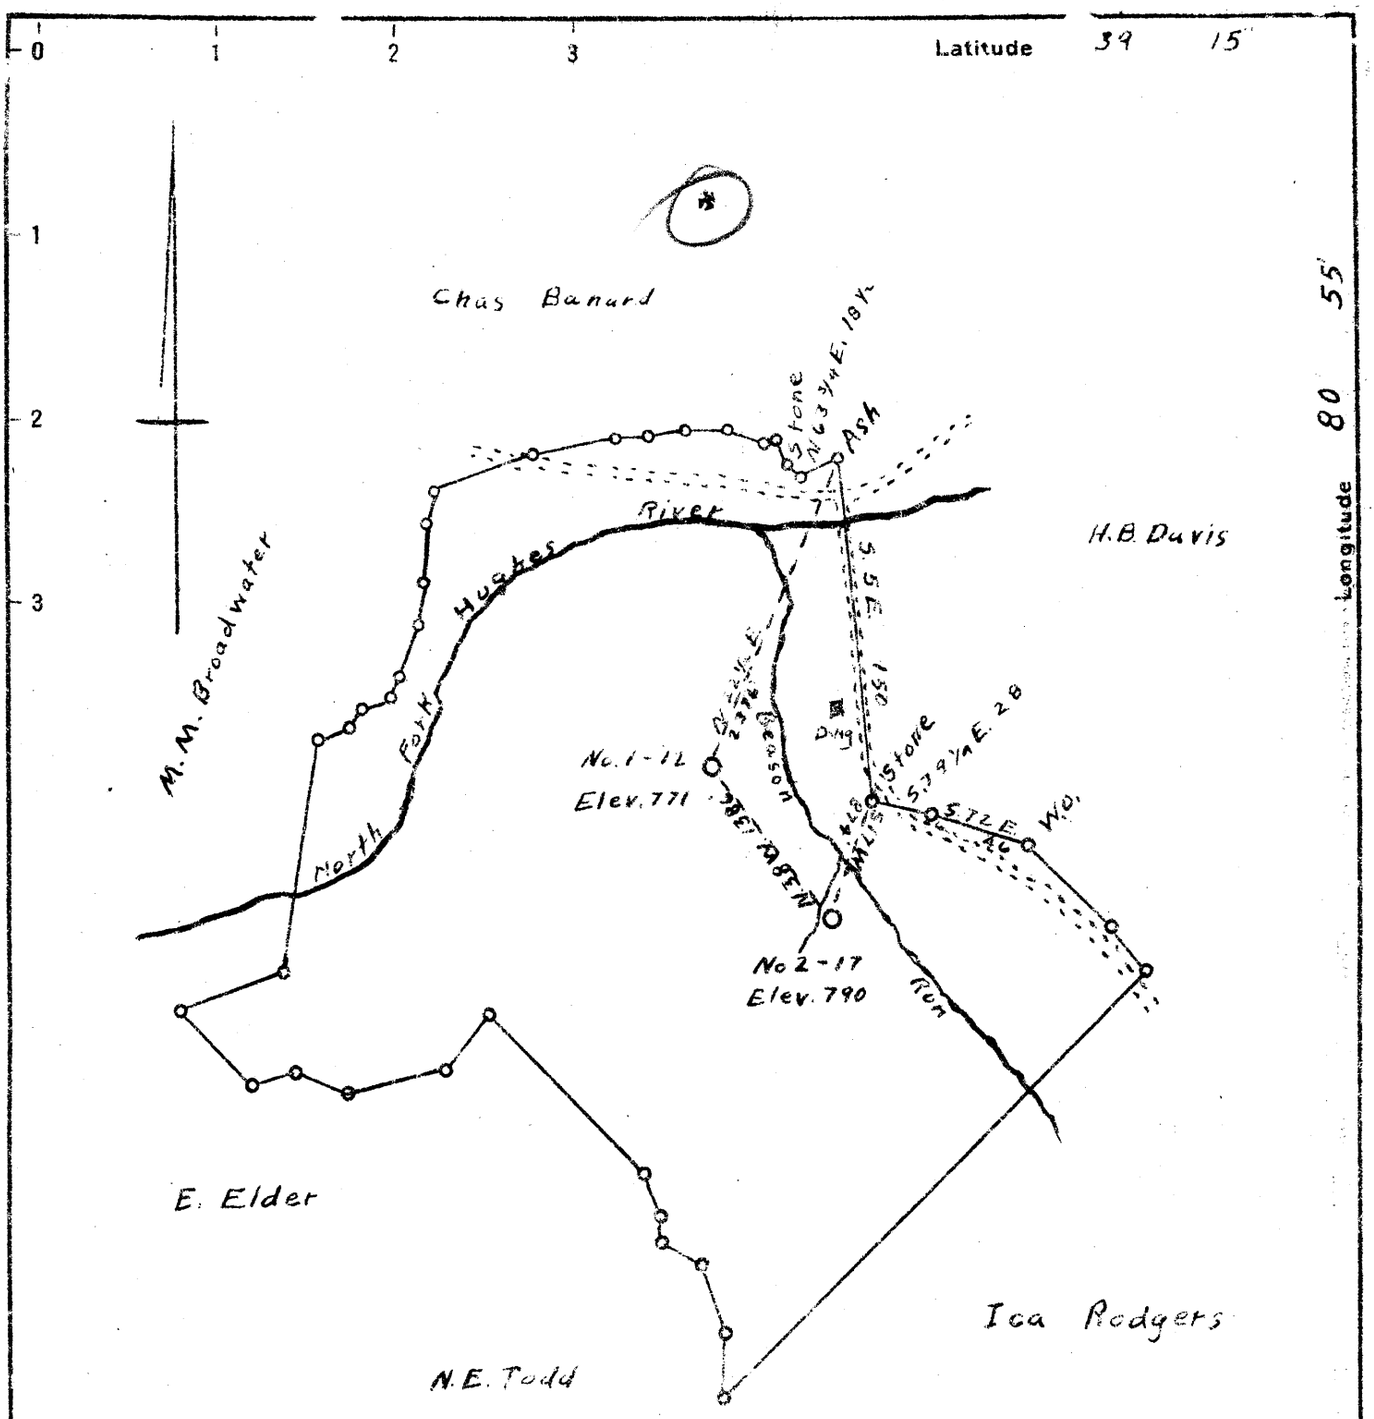


3.6 W
1.01 P

New Location
Drill Deeper
Abandonment

OCT - 9 1946

Company McCalls Drilling Co. Inc
Address 612 Keystone Bldg Pittsburgh Pa.
Farm L.C. Wilson Hrs
Tract ____ Acres 490 Lease No. ____
Well (Farm) No. 1-12 Serial No. ____
Elevation (Spirit Level) 771
Quadrangle Holbrook
County Ritchie District Clay
Engineer A.K. Westfall
Engineer's Registration No. ____
File No. ____ Drawing No. ____
Date Sept 9, 1946 Scale 1" = 80 Poles

STATE OF WEST VIRGINIA
DEPARTMENT OF MINES
OIL AND GAS DIVISION
CHARLESTON

# WELL LOCATION MAP

FILE NO. RIT-766-A

+ Denotes location of well on United States Topographic Maps, scale 1 to 62,500, latitude and longitude lines being represented by border lines as shown.

— Denotes one inch spaces on border line of original tracing.

L.C. WILSON HRS 12 — MCCALL DRLG — RIT 766-A