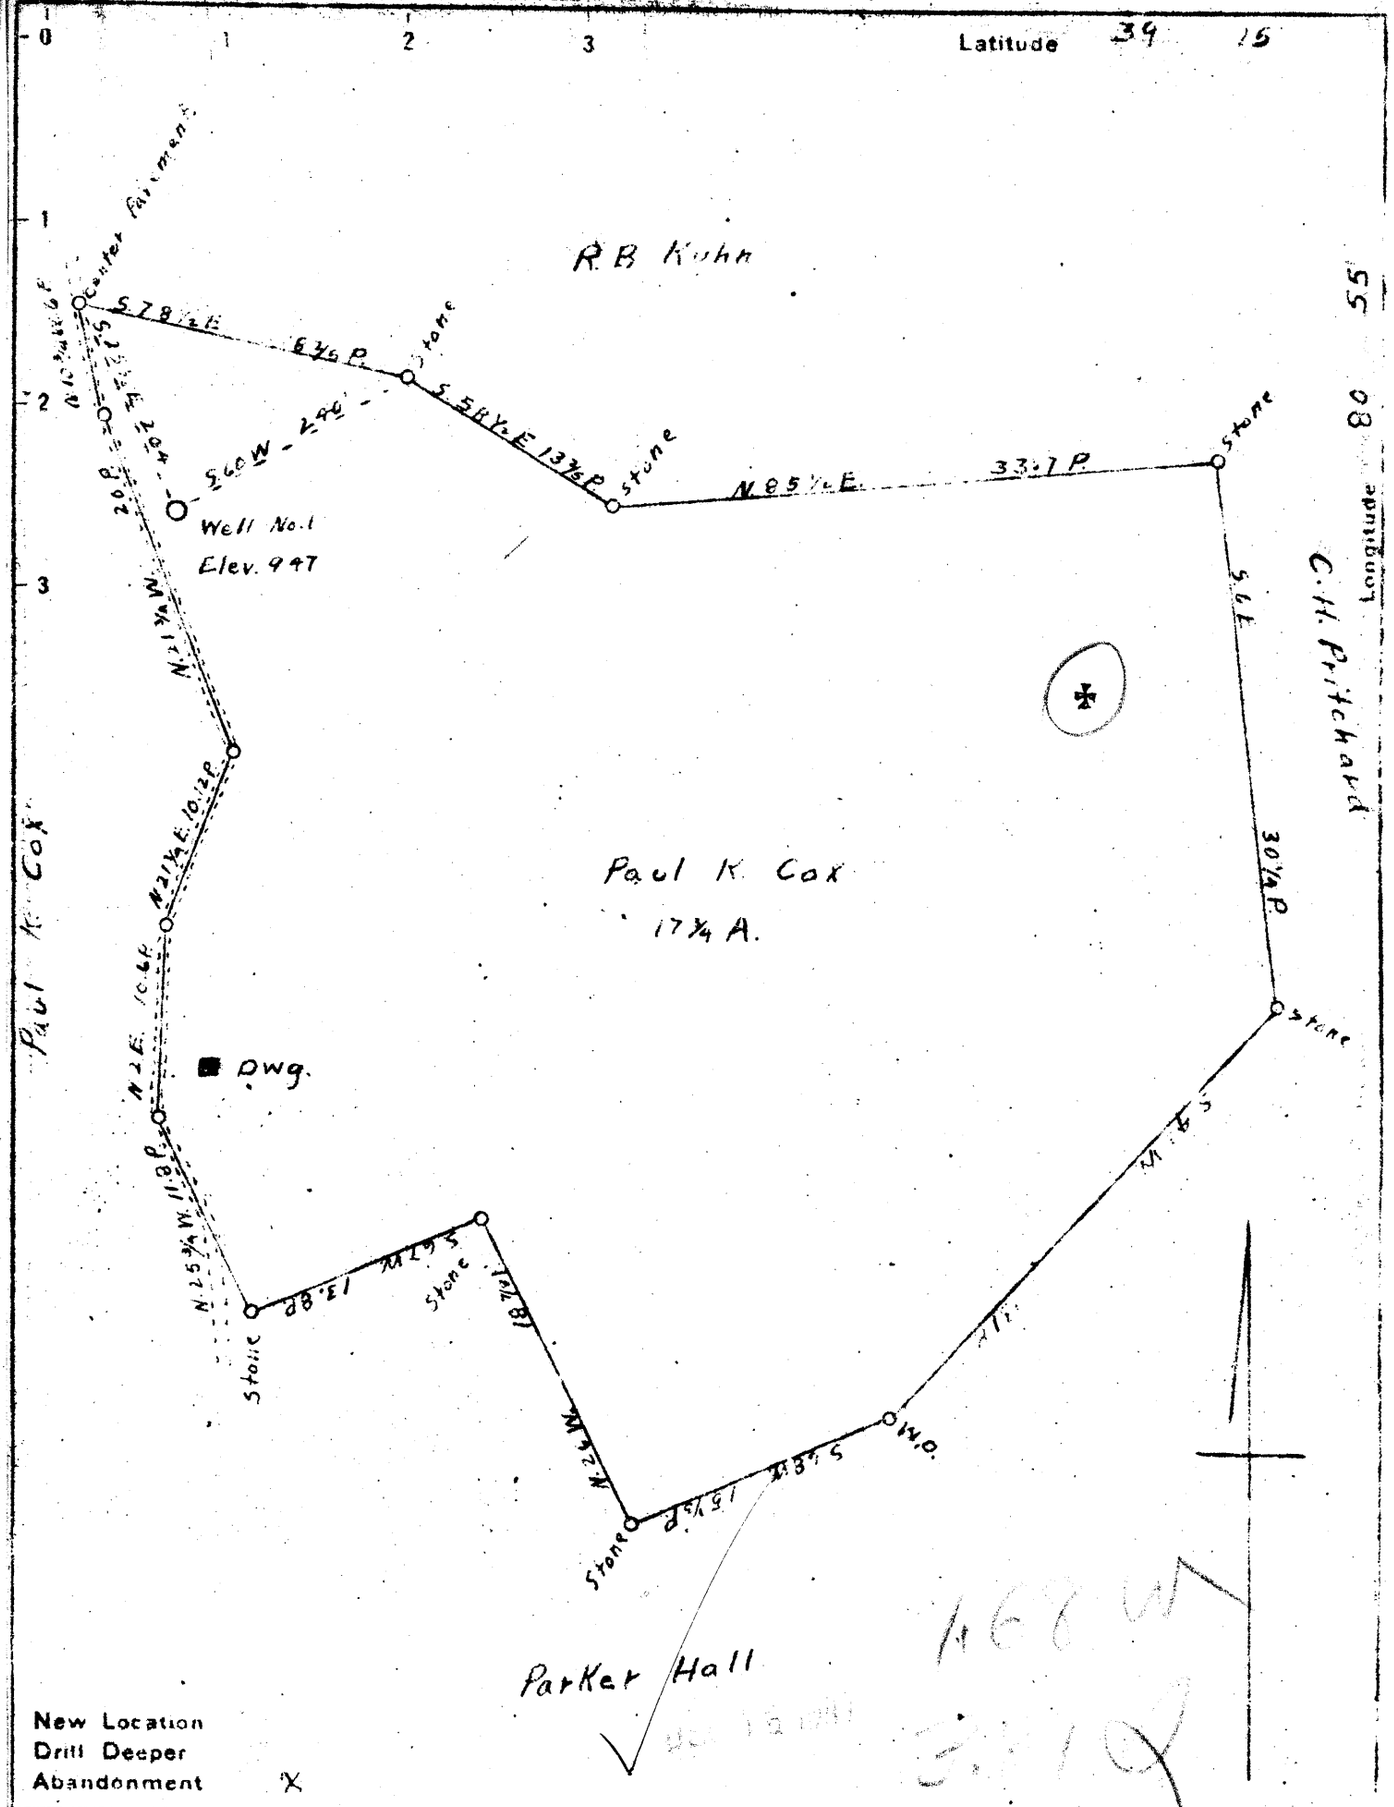

New Location
Drill Deeper
Abandonment X

Company W. H. Mossor
Address Thursday, W. Va.
Farm Paul K. Cox
Tract ____ Acres 17¾ Lease No. ____
Well (Farm) No. 1 Serial No. ____
Elevation (Spirit Level) 947
Quadrangle Holbrook
County Ritchie District Clay
Engineer A R Westfall
Engineer's Registration No. ____
File No. ____ Drawing No. ____
Date Dec 1, 1947 Scale 1" = 10 Poles

STATE OF WEST VIRGINIA
DEPARTMENT OF MINES
OIL AND GAS DIVISION
CHARLESTON

WELL LOCATION MAP

FILE NO R.t 808-A

+ Denotes location of well on United States Topographic Maps, scale 1 to 62,500, latitude and longitude lines being represented by border lines as shown.

— Denotes one inch spaces on border lines of original tracing.

PAUL K. COX NO. 1 — W. H. MOSSOR — RIT 808-A