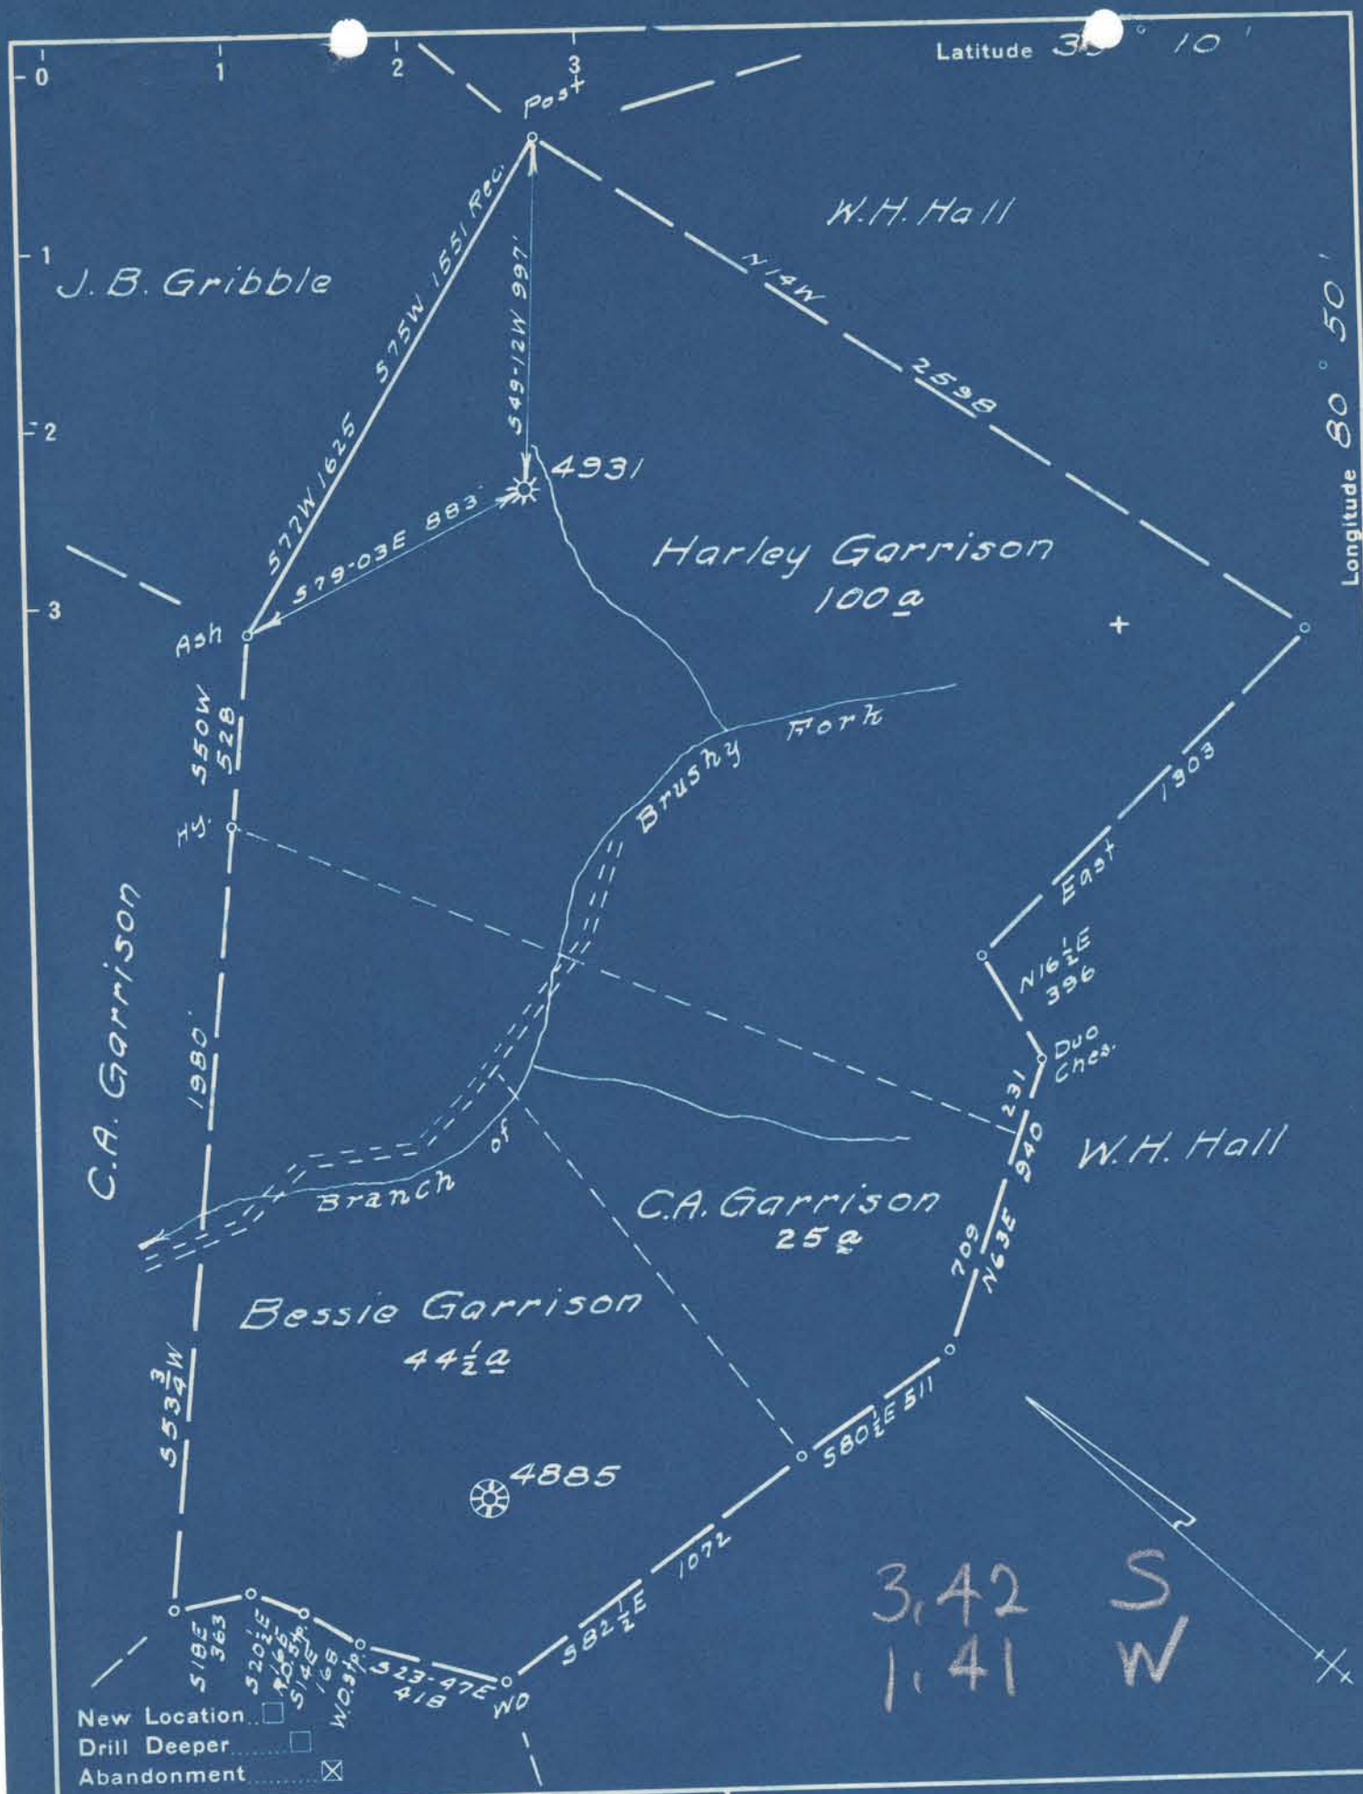

Company Pittsburgh & W.Va. Gas Co.
Address Clarksburg W.Va.
Farm Lewis Garrison
Tract ____ Acres 169½ Lease No. 7856
Well (Farm) No. Two Serial No. 4931
Elevation (Spirit Level) 989 V.A.
Quadrangle Holbrook S.E. 1'
County Ritchie District Union
Engineer James D. Jeffries
Engineer's Registration No. 1084
File No. 159/35 Drawing No. ____
Date 9-28-48 Scale 1"=500'

STATE OF WEST VIRGINIA
DEPARTMENT OF MINES
OIL AND GAS DIVISION
CHARLESTON

WELL LOCATION MAP

FILE NO. Rit-87-A

+ Denotes location of well on United States Topographic Maps, scale 1 to 62,500, latitude and longitude lines being represented by border lines as shown.

— Denotes one inch spaces on border line of original tracing.