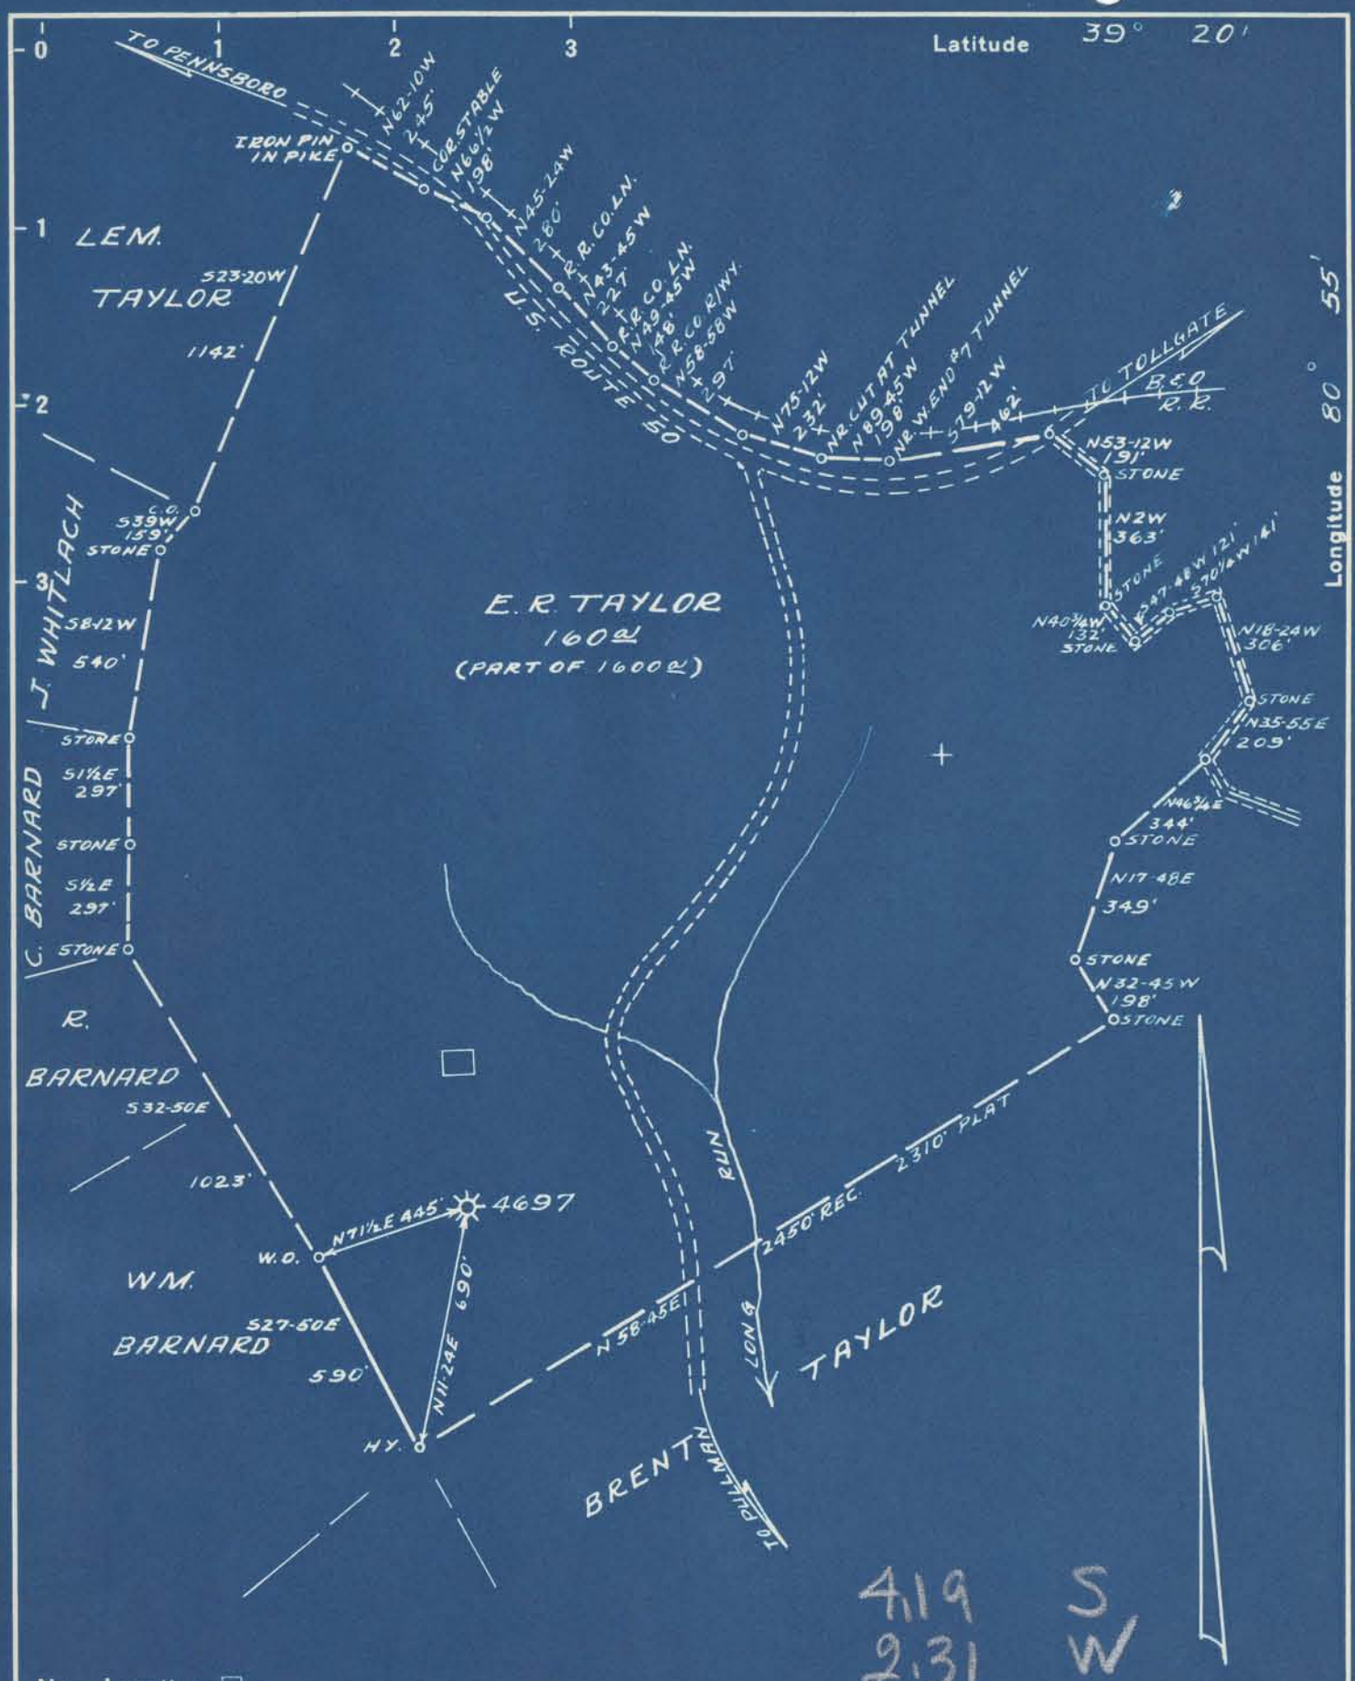

New Location ☐
Drill Deeper ☐
Abandonment ☒

Company PITTSBURGH E, W.VA. GAS CO.
Address CLARKSBURG, W.VA.
Farm E. R. TAYLOR
Tract _____ Acres 1600 Lease No. 5804
Well (Farm) No. 11 Serial No. 4697
Elevation (Spirit Level) 998' V.A.
Quadrangle WEST UNION S.W. 3d SW
County RITCHIE District CLAY
Engineer Kenneth B. Moore
Engineer's Registration No. Comm. Ry. H. Bigam 764
File No. V-161 P-1 Drawing No. _____
Date JAN 11, 1949 Scale 1" = 500'

STATE OF WEST VIRGINIA
DEPARTMENT OF MINES
OIL AND GAS DIVISION
CHARLESTON

WELL LOCATION MAP

FILE NO. R-t-913-A

+ Denotes location of well on United States Topographic Maps, scale 1 to 62,500, latitude and longitude lines being represented by border lines as shown.

— Denotes one inch spaces on border line of original tracing.

"IMPERIAL" TRACING CLOTH
K & E CO., N. Y.