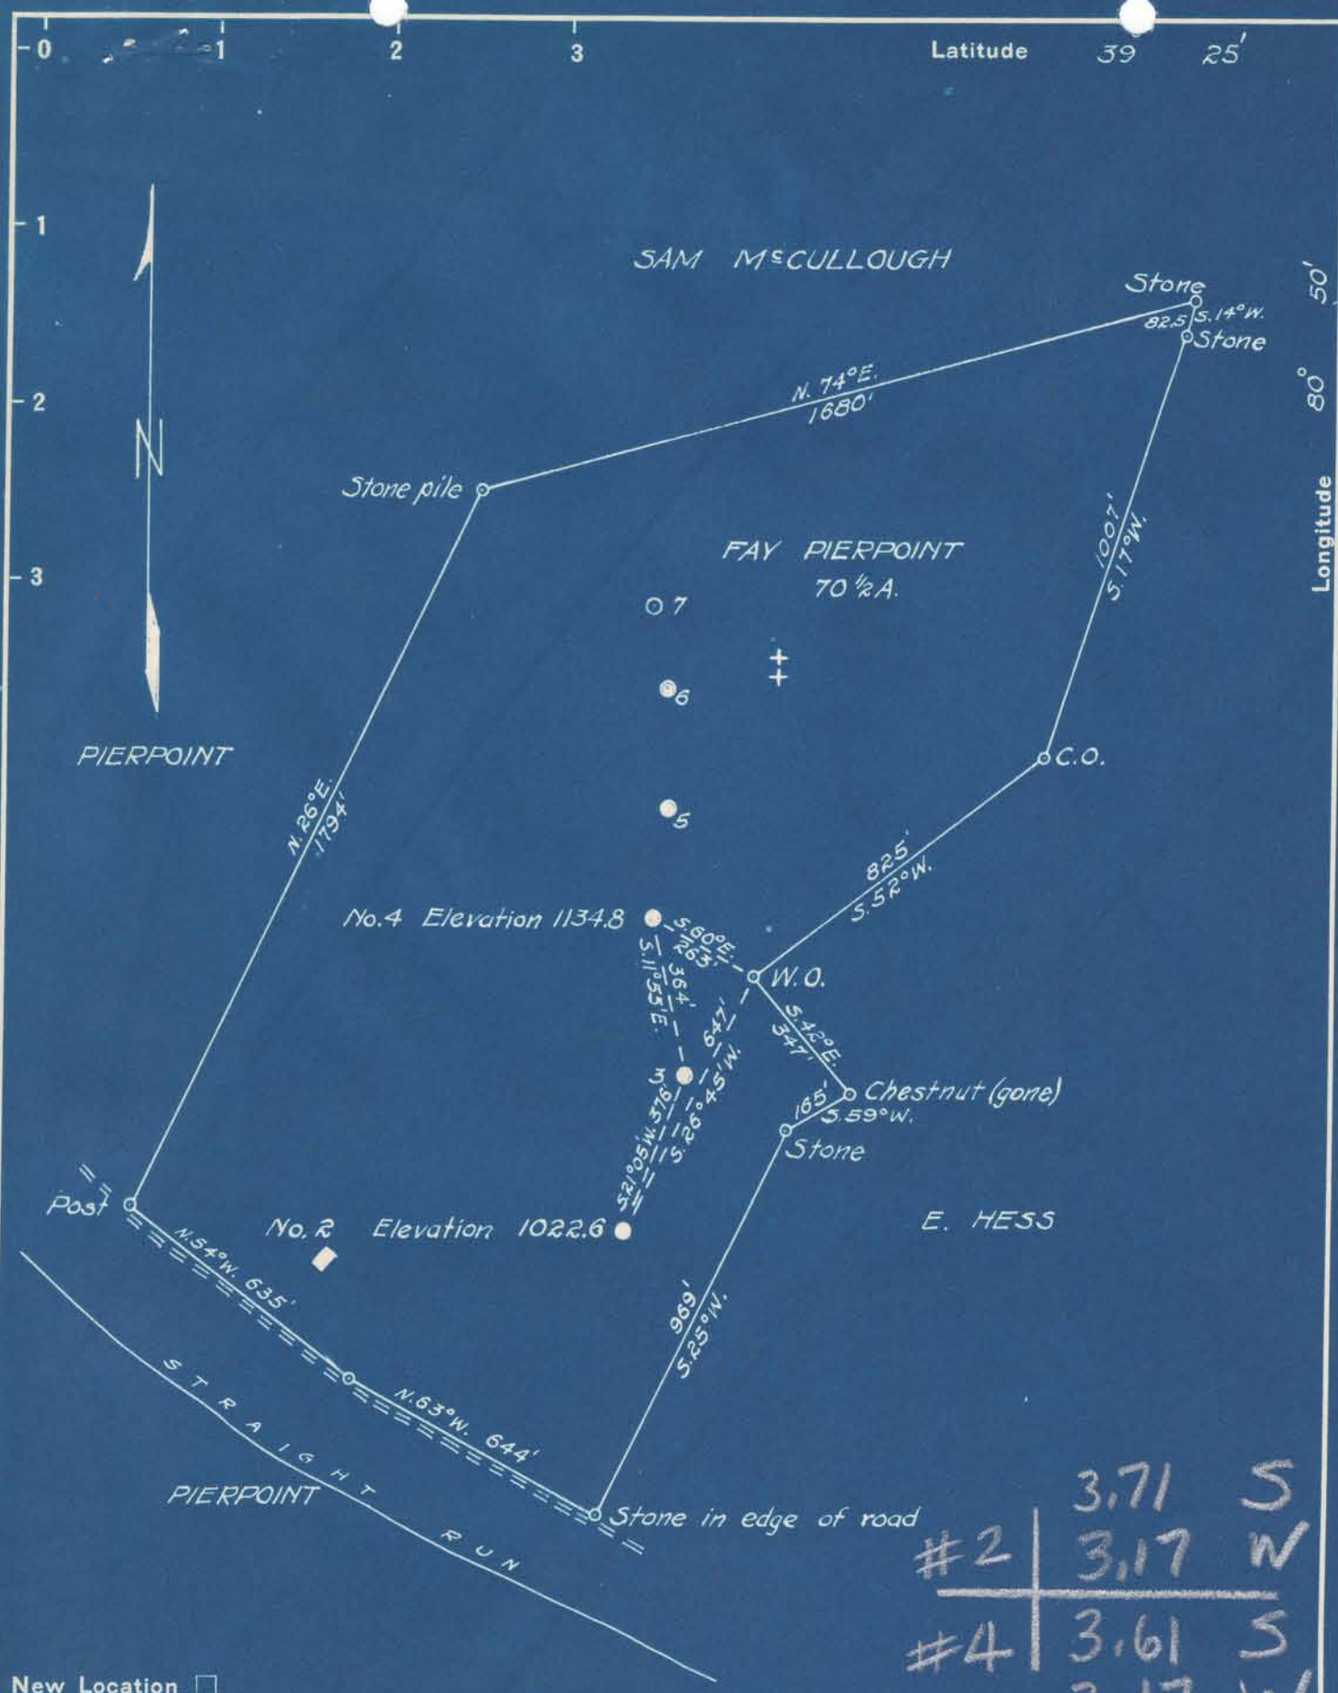

#2	3.71	S
	3.17	W
#4	3.61	S
	3.17	W

New Location ☐
Drill Deeper ☐
Abandonment ☑

Company DELBERT BACHELOR
Address MOUNTAIN, W. VA.
Farm FAY PIERPOINT
Tract _____ Acres 70 ½ Lease No. _____
Well (Farm) No. 2 & 4 Serial No. _____
Elevation (Spirit Level) 1022.6 & 1134.8
Quadrangle WEST UNION
County RITCHIE District CLAY
Engineer B. F. RINEHART
Engineer's Registration No. 648
File No. _____ Drawing No. 676-CR
Date Aug. 1, 1949 Scale 1 in. = 400 ft.

"IMPERIAL" TRACING CLOTH
K & E CO., N. Y.

STATE OF WEST VIRGINIA
DEPARTMENT OF MINES
OIL AND GAS DIVISION
CHARLESTON

WELL LOCATION MAP

FILE NO. Rit-946-A-#2
Rit-947-A-#4

+ Denotes location of well on United States Topographic Maps, scale 1 to 62,500, latitude and longitude lines being represented by border lines as shown.

— Denotes one inch spaces on border line of original tracing.