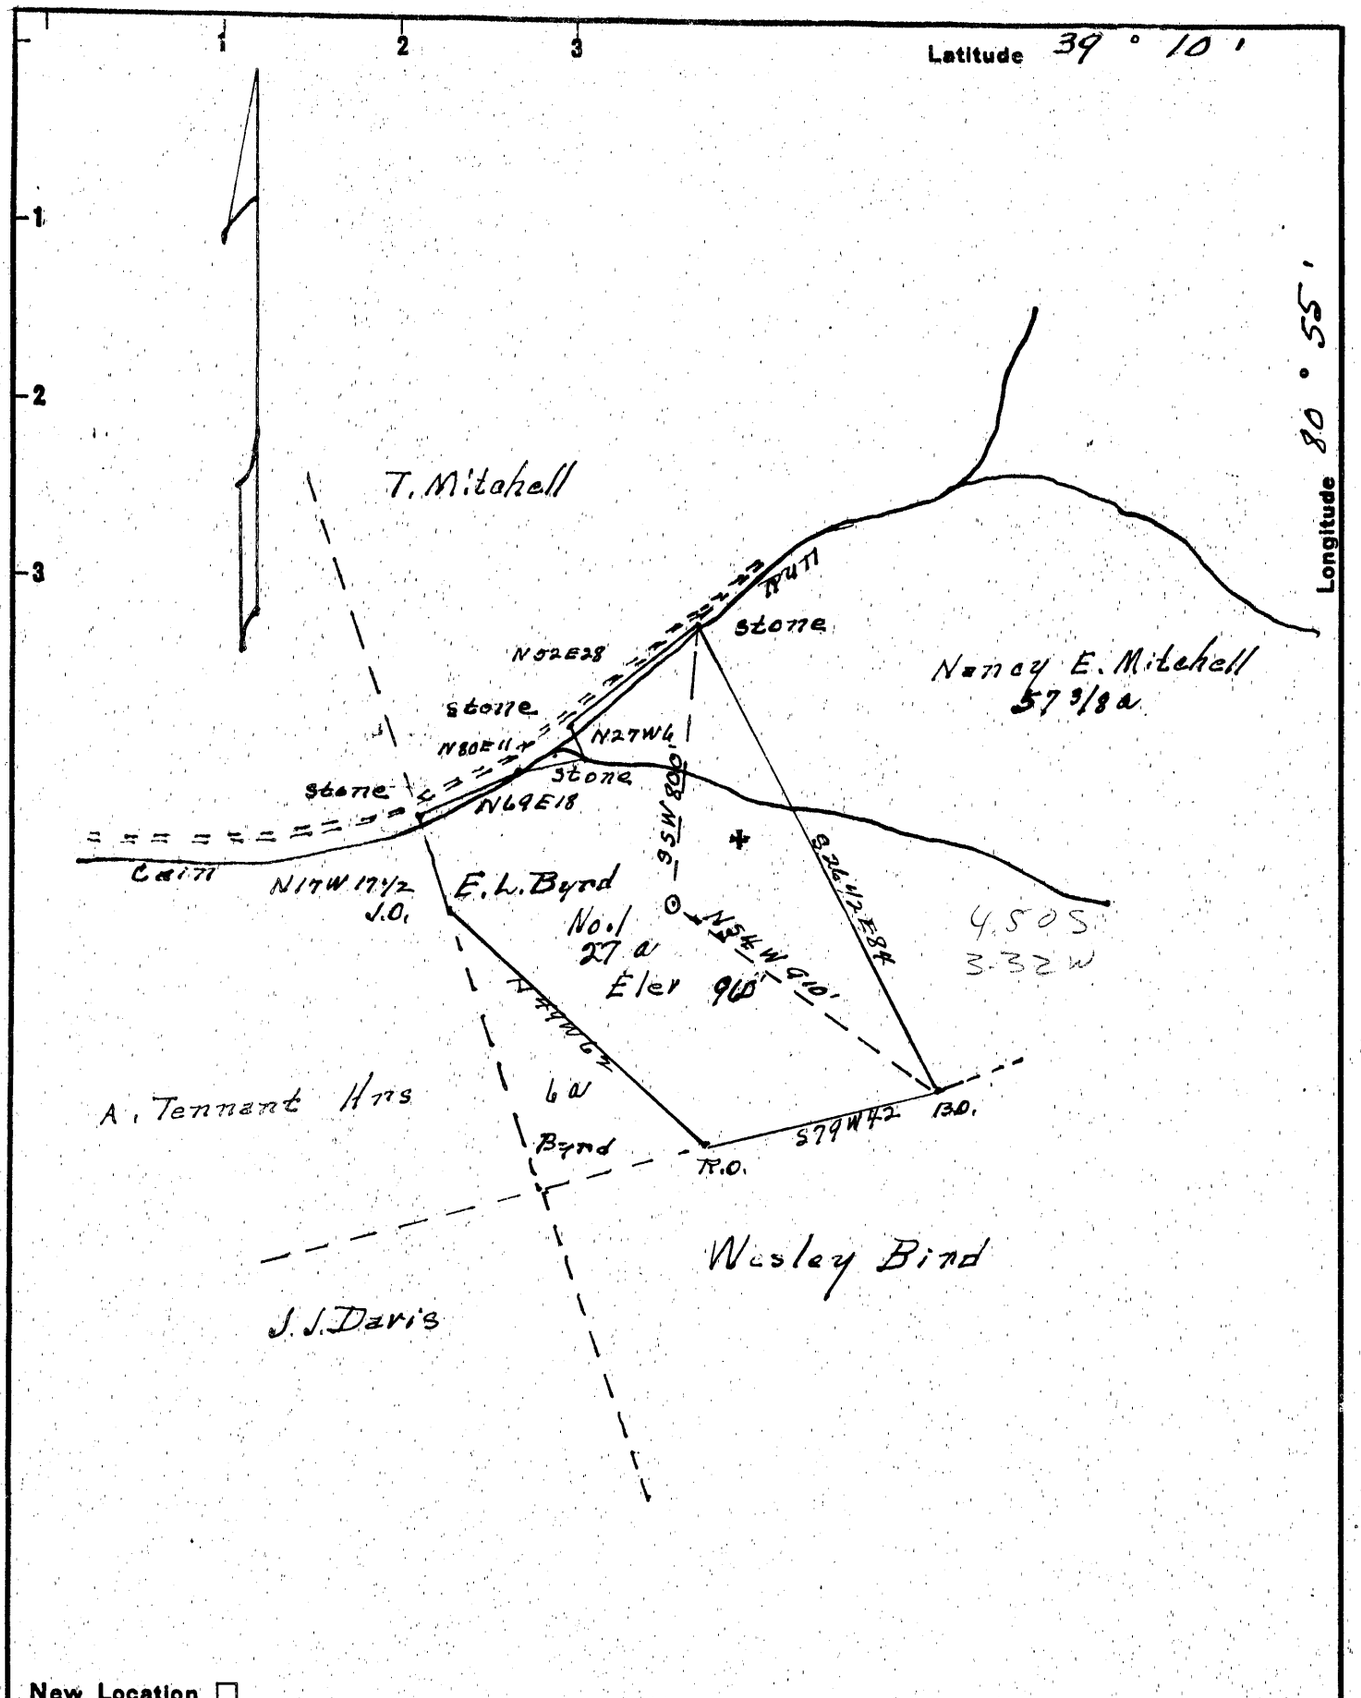

New Location..☐
Drill Deeper.....☐
Abandonment.....☒

Company Wm Cassady
Address Spencer, W.Va.
Farm E. L. BIRD
Tract _____ Acres 27a Lease No. _____
Well (Farm) No. 1 Serial No. _____
Elevation (Spirit Level) 960'
Quadrangle Holbrook
County Ritchie District Murphy
Engineer Daniel W. Mapes
Surveyed by Holly Nesbett
Engineer's Registration No. 1653
File No. _____ Drawing No. _____
Date 2/24/54 Scale 1" = 30 poles

STATE OF WEST VIRGINIA
DEPARTMENT OF MINES
OIL AND GAS DIVISION
CHARLESTON

WELL LOCATION MAP

FILE NO. R.t-1231-A

+ Denotes location of well on United States Topographic Maps, scale 1 to 62,500, latitude and longitude lines being represented by border lines as shown.

— Denotes one inch spaces on border line of original tracing.