


LATITUDE 39°15'00"

LONGITUDE 81°07'30"

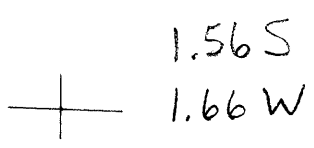

T'S OGIS topo location

7.5' loc	<u>1.56 S</u>	15' loc	_____
	<u>1.66 W</u>	(calc.)	_____

Company _____

Farm The Gregor I

Quad Cairo 7/2

County Ritchie

District Grant

WELL LOCATION MAP

File No. 085-70133

McGHEGOR NO. 1 WELL.

70133
Not located. 751
Cairo

Grant District, Ritchie County, W. Va.
N. E. of town of Cairo, north bank of river.
Elevation, 685'.

	Top.	Bottom.
Cairo Salt Sand (show oil and gas, 1486')	1481	1509
Big Injun Sand	1617	1652
Break at	1621	

McGHEGOR NO. 2 WELL.

70134
Not located. 752

Elevation, 658'.

	Top.	Bottom.
Cairo Salt Sand (show oil, 1477')	1470	1488
Big Injun Sand (show of gas & oil, 1590')	1580	
Total depth		1626