

WW-7  
8-30-06



West Virginia Department of Environmental Protection  
Office of Oil and Gas  
**WELL LOCATION FORM: GPS**

API: 47-085-\_\_\_\_\_ WELL NO.: Steel Run #8 (80628)\_\_\_\_\_

FARM NAME: Mike Ross Inc.\_\_\_\_\_

RESPONSIBLE PARTY NAME: WVDEP\_\_\_\_\_

COUNTY: Ritchie\_\_\_\_\_ DISTRICT: Grant\_\_\_\_\_

QUADRANGLE: Petroleum\_\_\_\_\_

SURFACE OWNER: Mike Ross Inc.\_\_\_\_\_

ROYALTY OWNER: W.B, Richardson agent for Carle & Cuthbert Heirs\_\_\_\_\_

UTM GPS NORTHING: 4340276.0\_\_\_\_\_

UTM GPS EASTING: 476103.0\_\_\_\_\_ Elevation 901'\_\_\_\_\_

The Responsible Party named above has chosen to submit GPS coordinates in lieu of preparing a new well location plat for a plugging permit or assigned API number on the above well. The Office of Oil and Gas will not accept GPS coordinates that do not meet the following requirements:

1. Datum: NAD 1983, Zone: 17 North, Coordinate Units: meters, Altitude: height above mean sea level (MSL) – meters.
2. Accuracy to Datum – 3.05 meters
3. Data Collection Method:

Survey grade GPS \_\_\_\_\_: Post Processed Differential \_\_\_\_\_  
Real-Time Differential \_\_\_\_\_

Mapping Grade GPS \_\_\_\_\_: Post Processed Differential \_\_\_\_\_  
Real-Time Differential \_\_\_\_\_


4. Letter size copy of the topography map showing the well location.

I the undersigned, hereby certify this data is correct to the best of my knowledge and belief and shows all the information required by law and the regulations issued and prescribed by the Office of Oil and Gas.

David Scranage\_\_\_\_\_ Inspector Specialist\_\_\_\_\_  
Signature Title

Date 7/28/2015\_\_\_\_\_

10/16/2015

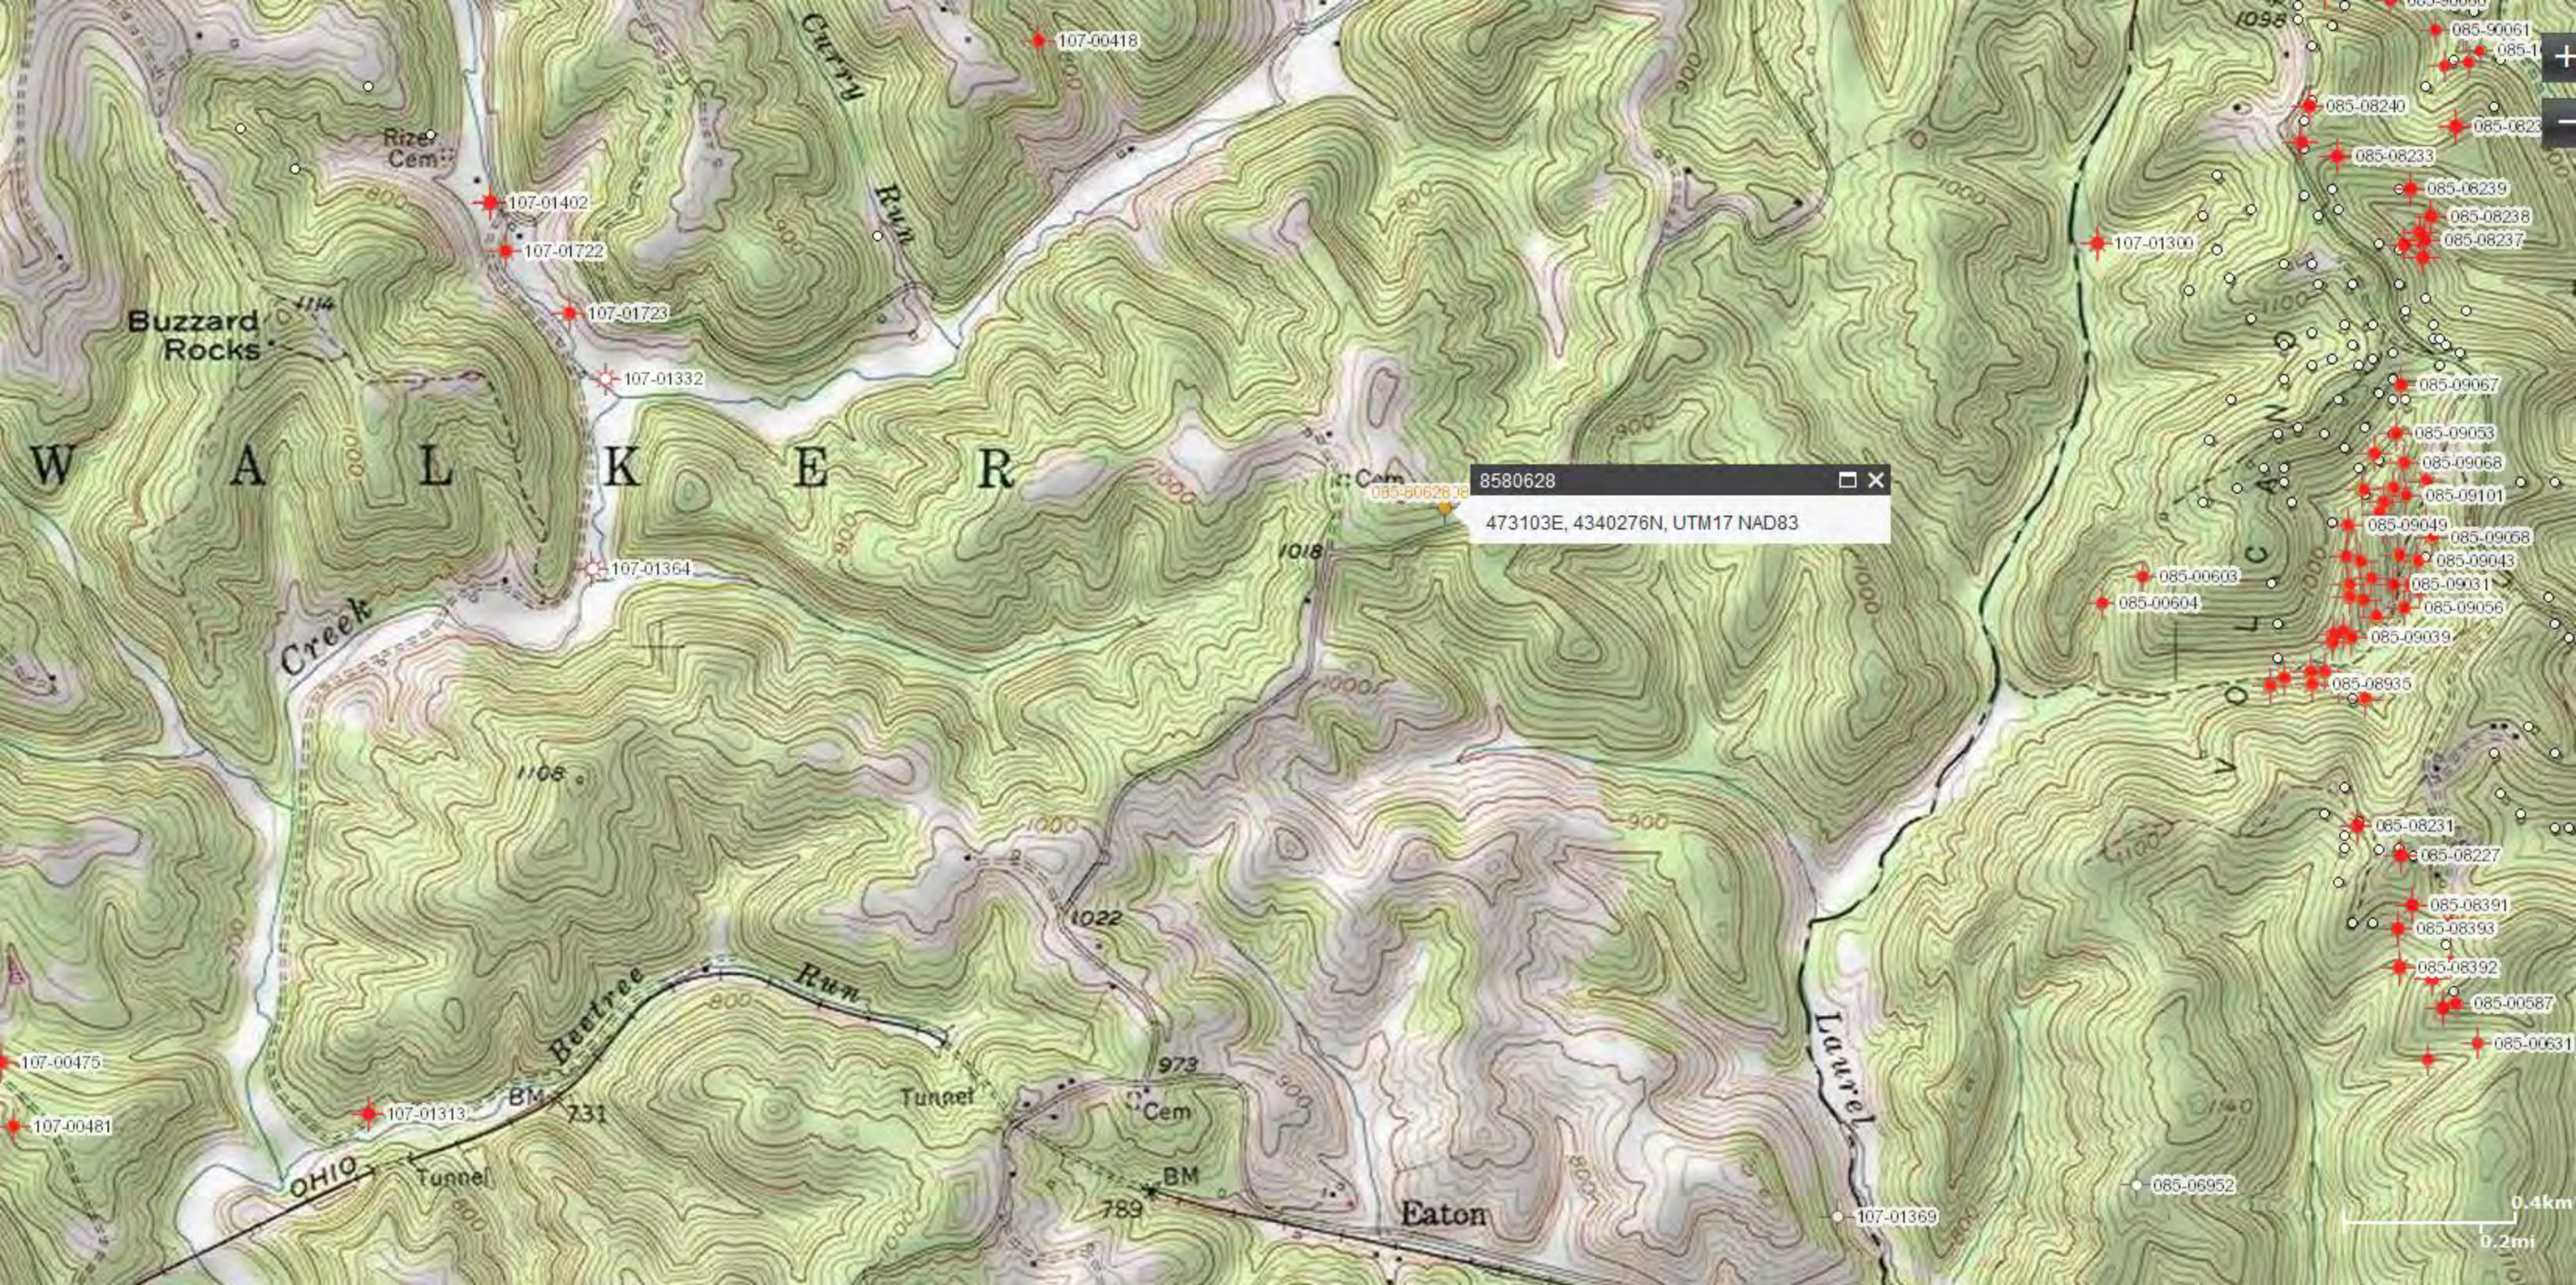

8580628  
473103E, 4340276N, UTM17 NAD83

- 107-00418
- 107-01402
- 107-01722
- 107-01723
- 107-01332
- 107-01364
- 107-01313
- 107-00475
- 107-00481
- 107-01369
- 85-90061
- 85-1
- 85-0623
- 85-08240
- 85-08233
- 85-08239
- 85-08238
- 85-08237
- 85-09067
- 85-09053
- 85-09068
- 85-09101
- 85-09049
- 85-09068
- 85-09043
- 85-09031
- 85-09056
- 85-09039
- 85-08935
- 85-08231
- 85-08227
- 85-08391
- 85-08393
- 85-08392
- 85-00587
- 85-00631
- 85-06952