

WW-7
8-30-06



West Virginia Department of Environmental Protection
Office of Oil and Gas

WELL LOCATION FORM: GPS

API: 47-095-00561 WELL NO.: 7

FARM NAME: FERRELL, J. F.

RESPONSIBLE PARTY NAME: Triad Hunter, LLC

COUNTY: TYLER DISTRICT: ELLSWORTH

QUADRANGLE: Porters Falls

SURFACE OWNER: JOHN W EDDY EST

ROYALTY OWNER: _____

UTM GPS NORTHING: 4374308.4343

UTM GPS EASTING: 511496.6722 GPS ELEVATION: 1004'

The Responsible Party named above has chosen to submit GPS coordinates in lieu of preparing a new well location plat for a plugging permit or assigned API number on the above well. The Office of Oil and Gas will not accept GPS coordinates that do not meet the following requirements:

- Datum: NAD 1983, Zone: 17 North, Coordinate Units: meters, Altitude: height above mean sea level (MSL) – meters.
 - Accuracy to Datum – 3.05 meters
 - Data Collection Method:
Survey grade GPS : Post Processed Differential _____
Real-Time Differential
- Mapping Grade GPS _____ : Post Processed Differential _____
Real-Time Differential _____

4. Letter size copy of the topography map showing the well location.


I the undersigned, hereby certify this data is correct to the best of my knowledge and belief and shows all the information required by law and the regulations issued and prescribed by the Office of Oil and Gas.

Signature *Mark Han*

Operations Manager
Title

2/5/19
Date

RECEIVED
Office of Oil and Gas
FEB 25 2019
WV Department of
Environmental Protection

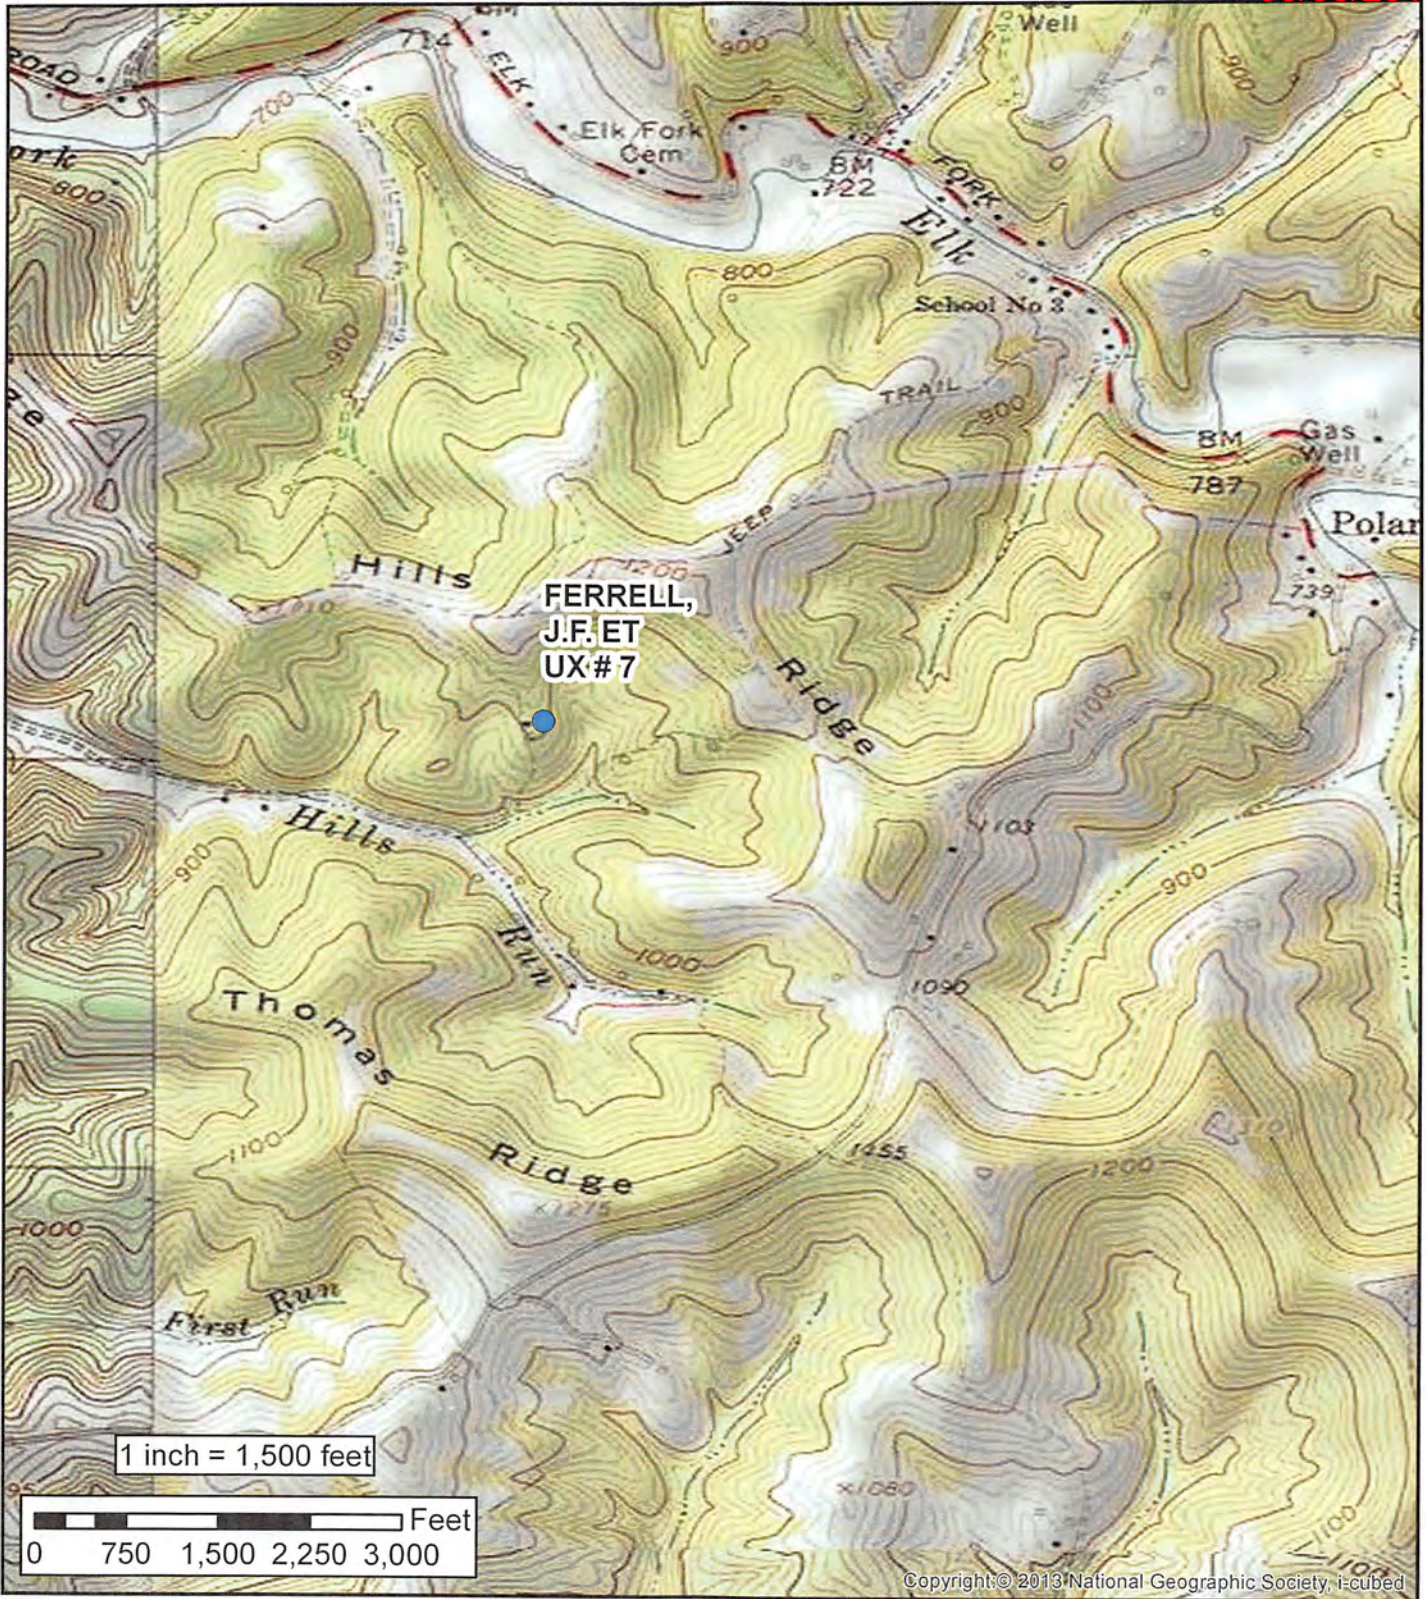

Well Name: Ferrell, J.F. #7
Triad Hunter, LLC
A subsidiary of Blue Ridge Mountain Resources, Inc.
Tyler County - Ellsworth District - West Virginia

RECEIVED
Office of Oil and Gas
FEB 25 2019
WV Department of
Environmental Protection