

WW-7
8-30-06



West Virginia Department of Environmental Protection
Office of Oil and Gas

WELL LOCATION FORM: GPS


API: 47-095-00576 WELL NO.: 4
FARM NAME: W.W.. Gorrell
RESPONSIBLE PARTY NAME: Triad Hunter, LLC
COUNTY: Tyler DISTRICT: Ellsworth
QUADRANGLE: Porters Falls
SURFACE OWNER: John & Lean Starkey
ROYALTY OWNER: Unknown
UTM GPS NORTHING: 4373724.76269
UTM GPS EASTING: 511556.85378 GPS ELEVATION: 264.566(868')

The Responsible Party named above has chosen to submit GPS coordinates in lieu of preparing a new well location plat for a plugging permit or assigned API number on the above well. The Office of Oil and Gas will not accept GPS coordinates that do not meet the following requirements:

- Datum: NAD 1983, Zone: 17 North, Coordinate Units: meters, Altitude: height above mean sea level (MSL) – meters.
 - Accuracy to Datum – 3.05 meters
 - Data Collection Method:
Survey grade GPS : Post Processed Differential _____
Real-Time Differential
- Mapping Grade GPS _____ : Post Processed Differential _____
Real-Time Differential _____
- Letter size copy of the topography map showing the well location.**

I the undersigned, hereby certify this data is correct to the best of my knowledge and belief and shows all the information required by law and the regulations issued and prescribed by the Office of Oil and Gas.

Brian Smith Geologist 1/14/2016
Signature Title Date

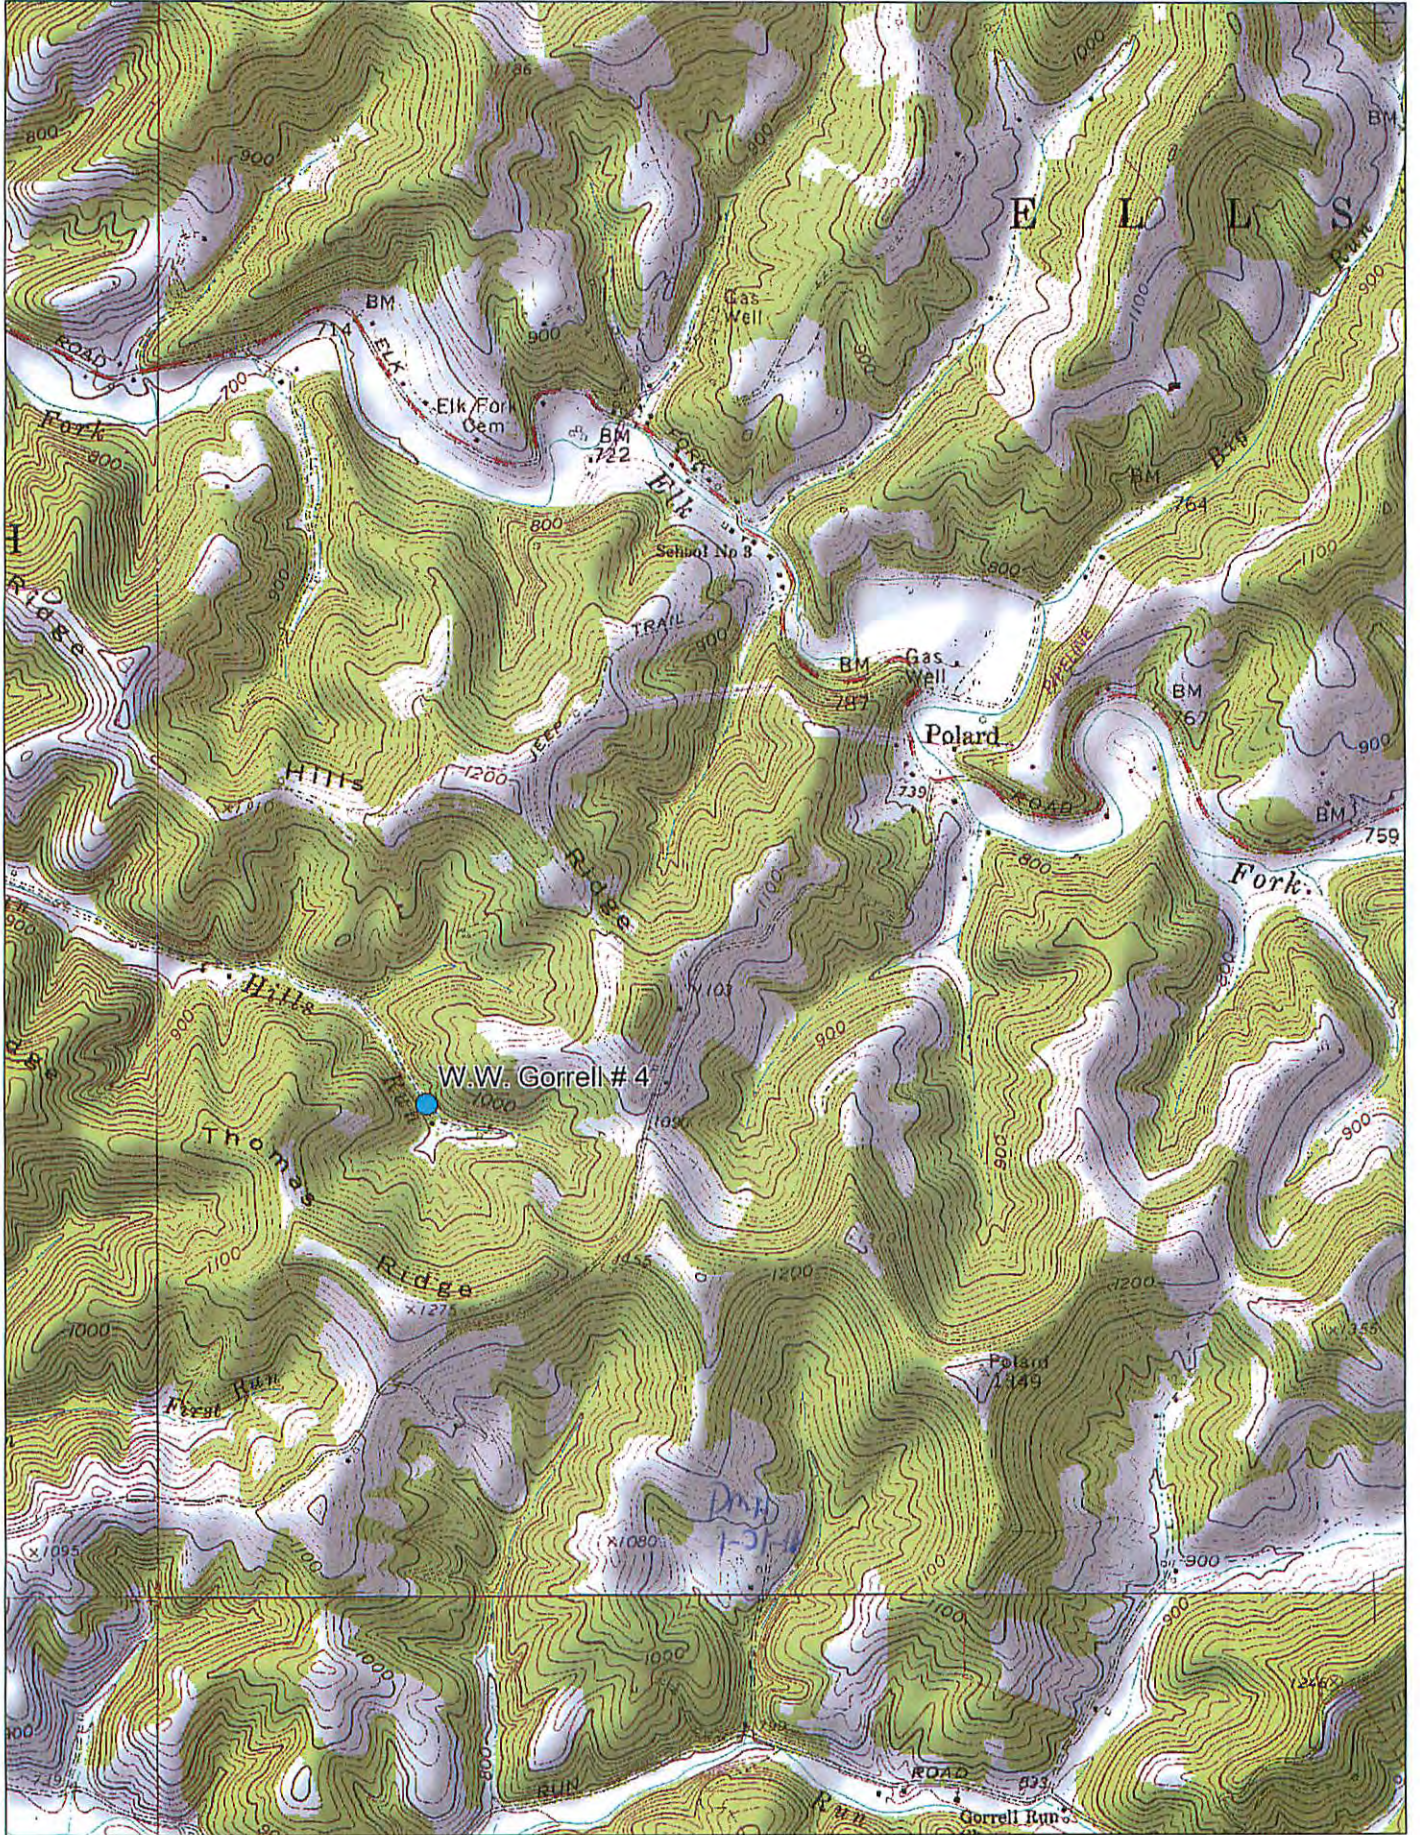


Data use subject to license.

© DeLorme. XMap® 7.

www.delorme.com



Scale 1 : 22,400

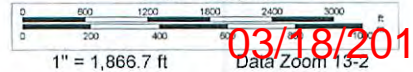

03/18/2016

Data Zoom 13-2