

WW-7  
8-30-06



West Virginia Department of Environmental Protection  
Office of Oil and Gas  
**WELL LOCATION FORM: GPS**

API: 47-095-00580 WELL NO.: 5  
 FARM NAME: HILL, J. K.  
 RESPONSIBLE PARTY NAME: Triad Hunter, LLC  
 COUNTY: TYLER DISTRICT: ELLSWORTH  
 QUADRANGLE: Porters Falls  
 SURFACE OWNER: DANIEL R DEETZ  
 ROYALTY OWNER: Unknown  
 UTM GPS NORTHING: 4374714.6000  
 UTM GPS EASTING: 511071.4000 GPS ELEVATION: 1078

The Responsible Party named above has chosen to submit GPS coordinates in lieu of preparing a new well location plat for a plugging permit or assigned API number on the above well. The Office of Oil and Gas will not accept GPS coordinates that do not meet the following requirements:

- Datum: NAD 1983, Zone: 17 North, Coordinate Units: meters, Altitude: height above mean sea level (MSL) – meters.
- Accuracy to Datum – 3.05 meters
- Data Collection Method:

Survey grade GPS  : Post Processed Differential \_\_\_\_\_

Real-Time Differential  \_\_\_\_\_

Mapping Grade GPS \_\_\_\_\_ : Post Processed Differential \_\_\_\_\_

Real-Time Differential \_\_\_\_\_

- Letter size copy of the topography map showing the well location.


I the undersigned, hereby certify this data is correct to the best of my knowledge and belief and shows all the information required by law and the regulations issued and prescribed by the Office of Oil and Gas.

*[Signature]*  
Signature

Operations Manager  
Title

2/5/19  
Date

RECEIVED  
Office of Oil and Gas  
FEB 25 2019  
WV Department of  
Environmental Protection

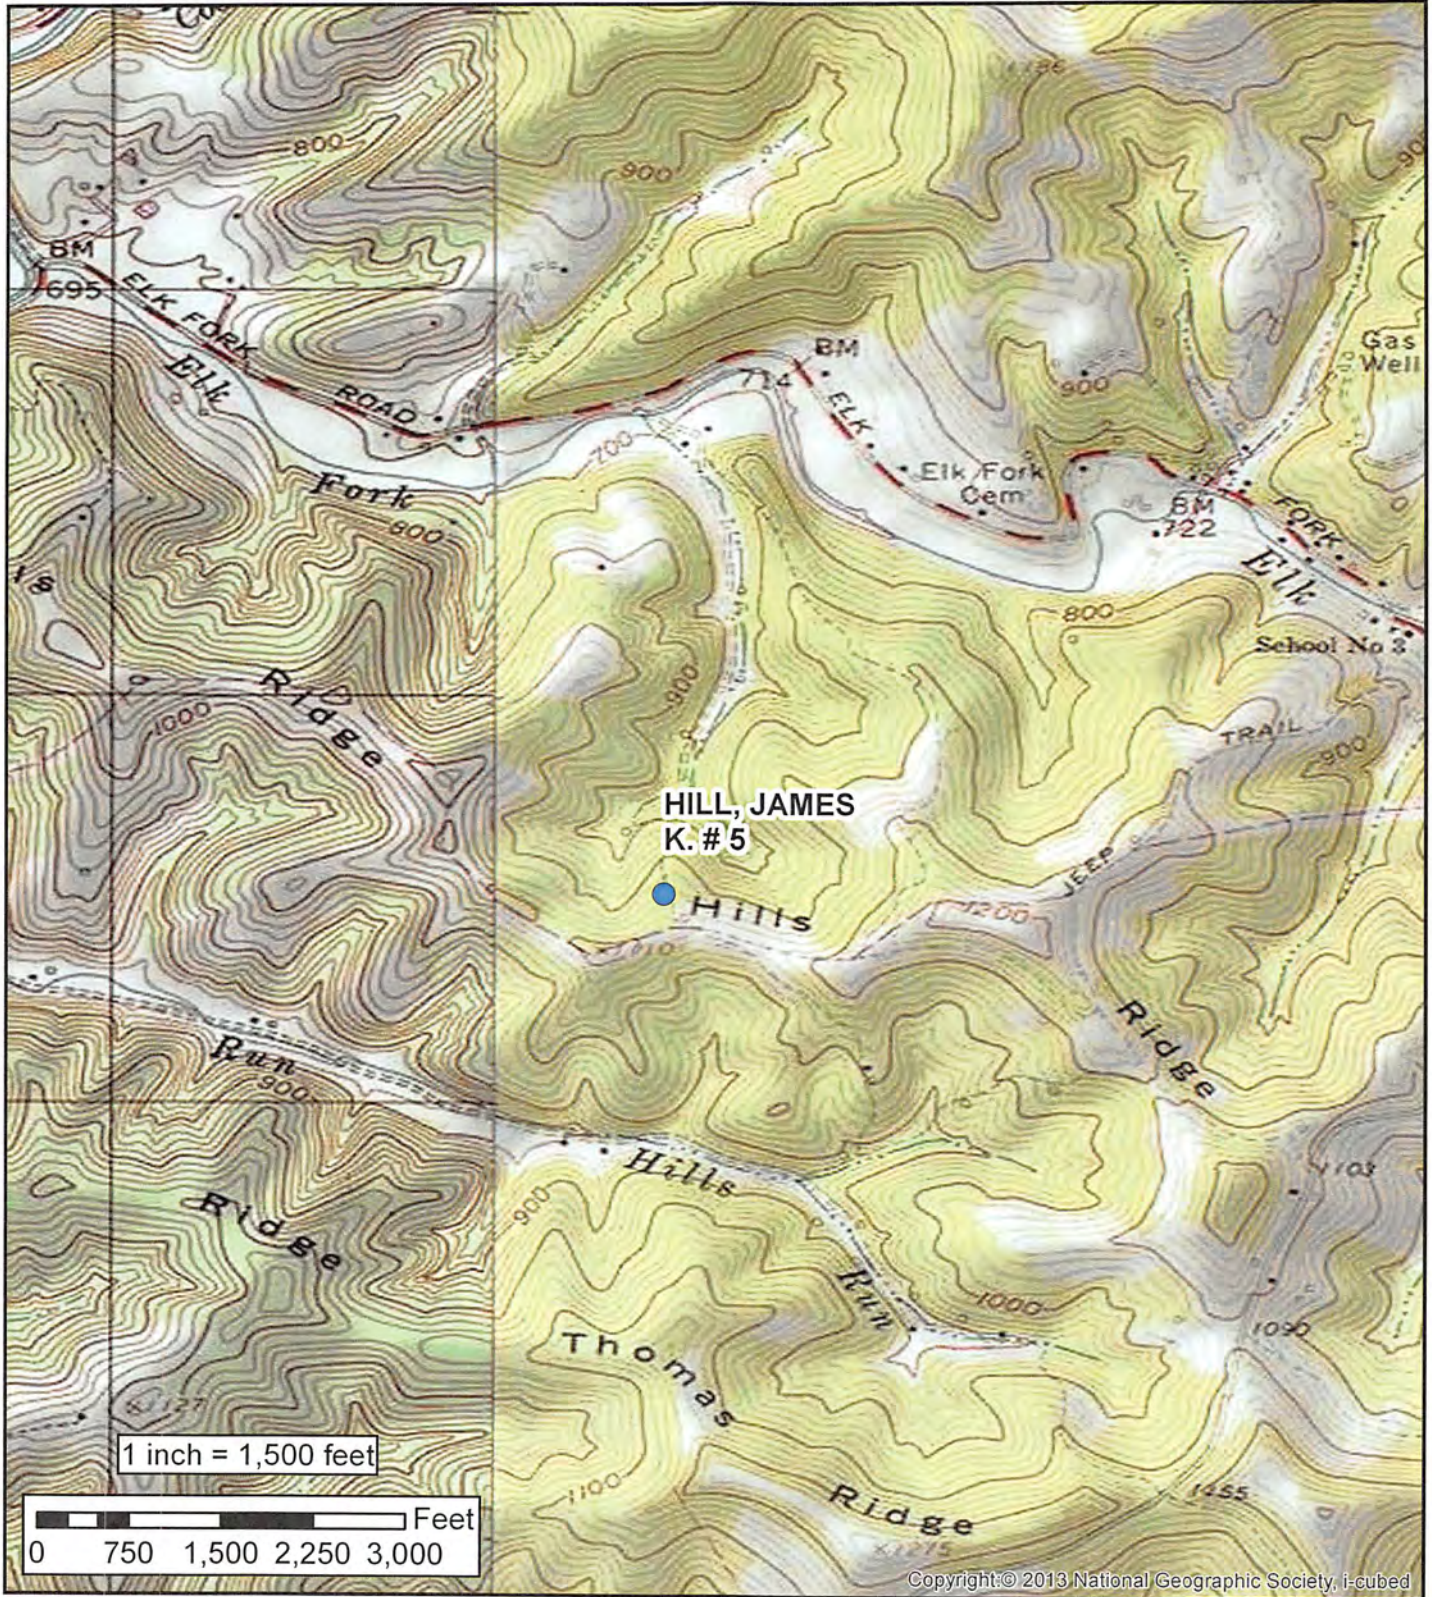

# Well Name: Hill, J.K. #5

Triad Hunter, LLC  
A subsidiary of Blue Ridge Mountain Resources, Inc.

Tyler County - Ellsworth District - West Virginia

RECEIVED  
Office of Oil and Gas  
FEB 25 2019  
WV Department of Environmental Protection