

Call Table	
A	S20° W 62 P.
B	S61° 14'E 709.5'
C	N77° 47'E 594.0'
D	N60° 34'E 701.0'
E	N19° W 40 P.
WELL TIES	
①	N38° 02'E 1911'
②	N24° 47'W 1516'


(H) DENOTES LOCATION OF WELL ON UNITED STATES TOPOGRAPHIC MAPS

◆ Denotes a Water Supply Source

FILE NO. 1819
 MAP NO. N47 N S 1 E W 5
 SCALE 1" = 1000'
 MINIMUM DEGREE OF ACCURACY 1 in 200
 PROVEN SOURCE OF ELEVATION USGS BM - 902

I THE UNDERSIGNED, HEREBY CERTIFY THAT THIS PLAT IS CORRECT TO THE BEST OF MY KNOWLEDGE AND BELIEF AND SHOWS ALL THE INFORMATION REQUIRED BY LAW AND THE REGULATIONS ISSUED AND PRESCRIBED BY THE DEPARTMENT OF MINES.

(SIGNED) *Timothy P. Roush*
 TIMOTHY P. ROUSH PS 793

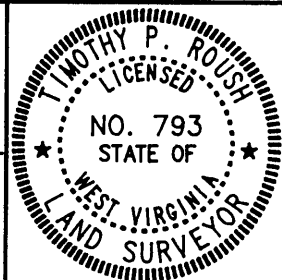

STATE OF WEST VIRGINIA
 DIVISION OF ENERGY
 OIL AND GAS SECTION



DATE October 23, 19 96
 FARM Isaac Baker NO. 3
 API WELL NO. 47-095-00792-P

WELL TYPE: OIL GAS LIQUID INJECTION WASTE DISPOSAL
 (IF "GAS") PRODUCTION STORAGE DEEP SHALLOW
 LOCATION: ELEVATION 894' WATERSHED Indian Creek
 DISTRICT McElroy COUNTY Tyler
 QUADRANGLE Centerpoint 7.5'

SURFACE OWNER David W. Lemasters ACREAGE 54 Ag.
 OIL & GAS ROYALTY OWNER Pennzoil Products Co. et al. LEASE ACREAGE 54 Ac.
 LEASE NO. 14630-50

PROPOSED WORK: DRILL CONVERT DRILL DEEPER REDRILL FRACTURE OR STIMULATE PLUG OFF OLD FORMATION PERFORATE NEW FORMATION OTHER PHYSICAL CHANGE IN WELL (SPECIFY) _____

PLUG AND ABANDON CLEAN OUT AND REPLUG
 TARGET FORMATION Gordon ESTIMATED DEPTH 2764'
 WELL OPERATOR Pennzoil Products Company DESIGNATED AGENT Philip S. Ondrusek
 ADDRESS P. O. Box 5519 ADDRESS P. O. Box 5519
Vienna, W.Va. 26105 Vienna, W.Va. 26105

ISAAC BAKER NO. 3 WELL.

Gal. No. 439 (252)

McElroy District, Tyler County, W. Va.
South Penn Oil Co.
Elevation, 897'. ✓
On run below McIntyre Run.

7

→ 095
792

no location
Found

Comp 08/01/1898

Przl - Kla
10/19/98

Pg h 295
Injun 2010 - 2070
Gordon Stray 2726 - 2741
Gordon 2741 - 2756
oil - 2745

TD 2764
(Active)

TL-792

(095)

STATE OF WEST VIRGINIA
DIVISION OF ENVIRONMENTAL PROTECTION
SECTION OF OIL AND GAS

AFFIDAVIT OF PLUGGING AND FILLING WELL

AFFIDAVIT SHOULD BE IN TRIPPLICATE, one copy mailed to the Division, one copy to be retained by the Well Operator and the third copy (and extra copies if required) should be mailed to each coal operator at their respective addresses.

Farm name: LEMASTERS, DAVID W. Operator Well No.: ISAAC BAKER #3

LOCATION: Elevation: 894.00 Quadrangle: CENTER POINT
District: MCELROY County: TYLER
Latitude: 8300 Feet South of 39 Deg. 27 Min. 30 Sec.
Longitude 10100 Feet West of 80 Deg. 40 Min. 0 Sec.

Well Type: OIL X GAS

Company: Pennzoil Products Company
P. O. Box 5519
Vienna, WV 26105-5519

Coal Operator
or Owner

Agent: P. S. Ondrusek

Coal Operator
or Owner

Permit Issued: 10/29/96

RECEIVED
Environmental Protection
Section
FEB 04 1997
Office of Oil & Gas
Permitting

AFFIDAVIT

STATE OF WEST VIRGINIA,
County of Wood ss:

R. A. Green and Levy Snodgrass being first duly sworn according to law depose and say that they are experienced in the work of plugging and filling oil and gas wells and were employed by the above named well operator, and participated in the work of plugging and filling the above well, and Mike Underwood Oil and Gas Inspector representing the Director, say that said work was commenced on the 6th day of January, 1997, and that the well was plugged and filled in the following manner:


TYPE	FROM	TO	PIPE REMOVED	LEFT
60 sks. cement	2760'	2600'	5-1/2" 1886'	277'
60 sks. cement	2213'	1813'	6-5/8" 290'	1670'
25 sks. cement	1281'	1181'		
40 sks. cement	725'	625'	Ripped 7" @1231' and 675'	
40 sks. cement	340'	240'		
70 sks. cement	200'	100'		
50 sks. cement	50'	Surface		

Description of monument: 7" casing extending 30" above ground level and that the work of plugging and filling said well was completed on the 22nd day of January, 1997.

And further deponents saith not.

Sworn and subscribe before me this 30th day of January, 1997
My commission expires: August 7, 2006

R. A. Green
Levy Snodgrass
Diane E. Bosley
Notary Public

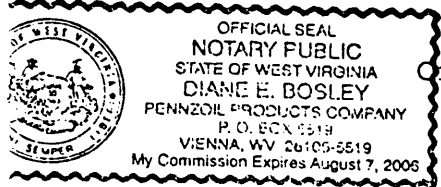

Oil and Gas Inspector: _____

FEB 31 1997