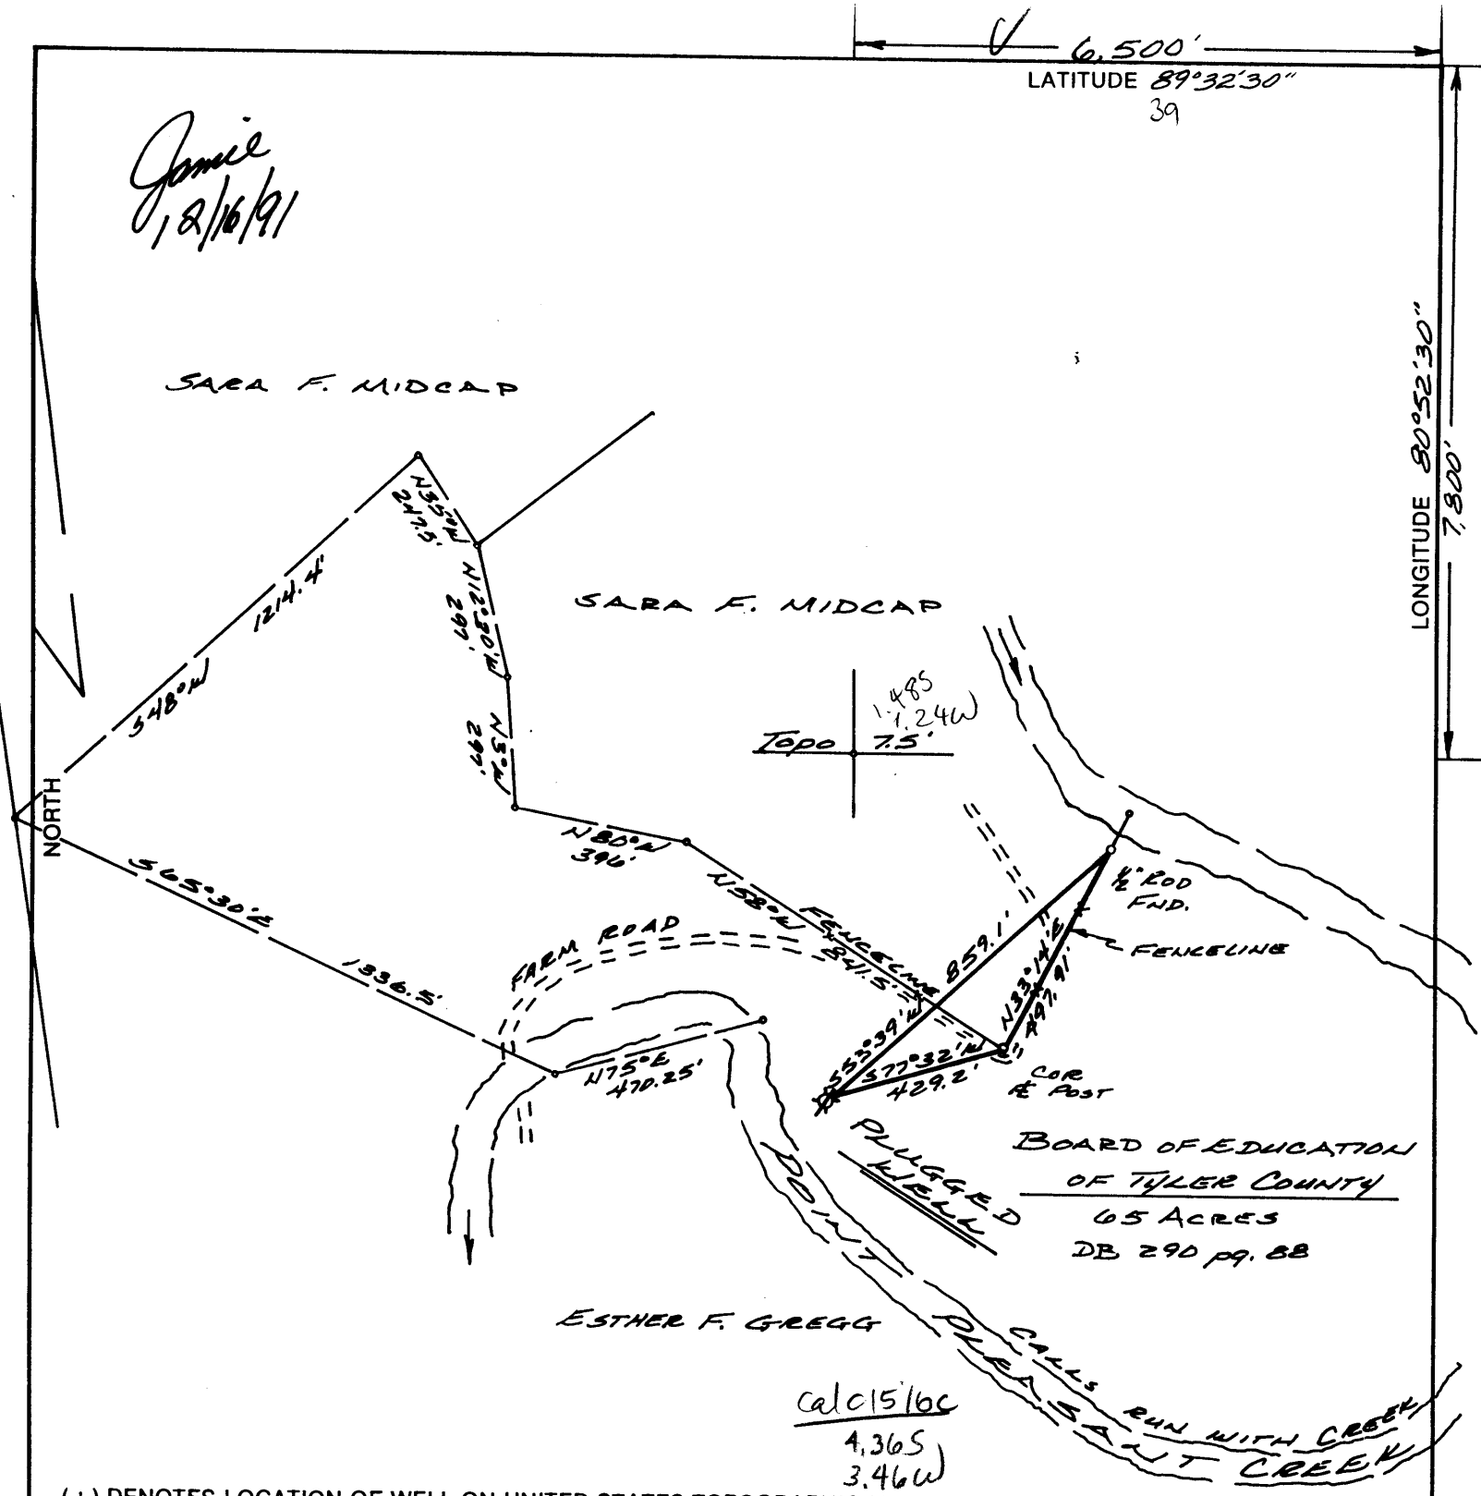

(+) DENOTES LOCATION OF WELL ON UNITED STATES TOPOGRAPHIC MAPS

FILE NO. _____
DRAWING NO. 91-2
SCALE 1" = 400'
MINIMUM DEGREE OF ACCURACY 1' in 200'
PROVEN SOURCE OF ELEVATION BM-695' EAST OF LOCATION.

I THE UNDERSIGNED, HEREBY CERTIFY THAT THIS PLAT IS CORRECT TO THE BEST OF MY KNOWLEDGE AND BELIEF AND SHOWS ALL THE INFORMATION REQUIRED BY LAW AND THE REGULATIONS ISSUED AND PRESCRIBED BY THE DEPARTMENT OF ENERGY.

(SIGNED) Rexford L. Castaneda

R.P.E. _____ L.L.S. 555

BUCKHANNON, WV

PLACE SEAL HERE

STATE OF WEST VIRGINIA
DEPARTMENT OF ENERGY
OIL AND GAS DIVISION

DATE 10 DECEMBER, 19 91
OPERATOR'S WELL NO. Tyl. Court School Board. #1
API WELL NO. 47 _ 095 _ 01484P
STATE COUNTY PERMIT

WELL TYPE: OIL ___ GAS ✓ LIQUID INJECTION ___ WASTE DISPOSAL ___
(IF "GAS,") PRODUCTION ___ STORAGE ___ DEEP ___ SHALLOW ✓
LOCATION: ELEVATION 693' WATER SHED POINT PLEASANT CREEK
DISTRICT ELLSWORTH COUNTY TYLER
QUADRANGLE PADEN CITY, W. VA. - OHIO New Martinsville SC
SURFACE OWNER BOARD OF EDUCATION, TYLER COUNTY ACREAGE 65
OIL & GAS ROYALTY OWNER O.B. CONAWAY LEASE ACREAGE 65
LEASE NO. _____
PROPOSED WORK: DRILL ___ CONVERT ___ DRILL DEEPER ___ REDRILL ___ FRACTURE OR STIMULATE ___ PLUG OFF OLD FORMATION ___ PERFORATE NEW FORMATION ___ OTHER PHYSICAL CHANGE IN WELL (SPECIFY) _____
PLUG AND ABANDON ✓ CLEAN OUT AND REPLUG ___
TARGET FORMATION _____ ESTIMATED DEPTH _____
WELL OPERATOR STATE OF WEST VIRGINIA DESIGNATED AGENT _____
ADDRESS _____ ADDRESS _____

COUNTY NAME
PERMIT

RECEIVED DEC 20 1991

FORM WW-6
H.T. HALL 48673