


WELLS MECKLEY 101 (AS-DRILLED)



LEGEND

- + TYPED MAP POINT
- ⊠ EXISTING WELLS
- PRE-20 WELLS
- PANEL LINES
- PROPOSED WELL
- WELL
- STREAM

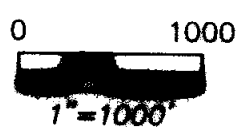

STATE OF WEST VIRGINIA
 PROFESSIONAL SURVEYOR
 No. 2741
W. B. S. S.


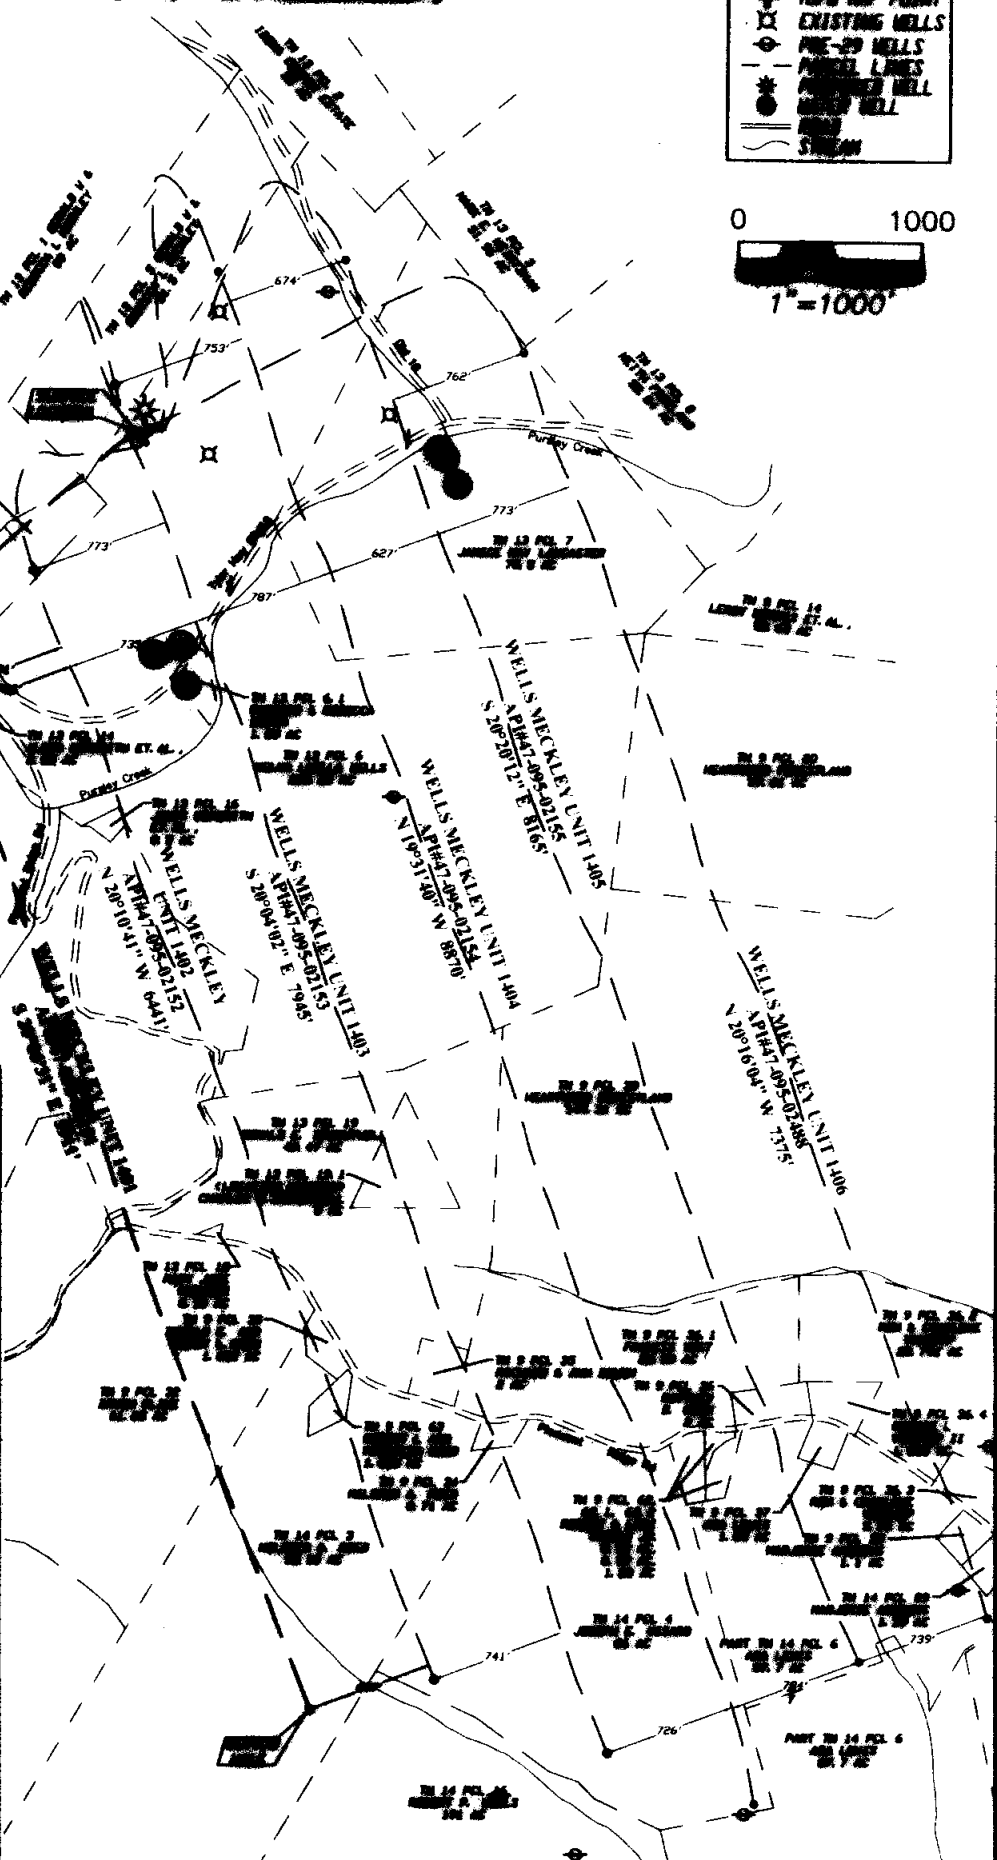 

SURVEY NOTES:


11283 EMERSON AVENUE, PARKERSBURG, WV 26104
 (304) 464-5385 PICKERING USA.COM

API WELL #: 47-095-02151
 STATE COUNTY PERMIT

OPERATOR'S WELL #: **WELLS MECKLEY 101**

WELL OPERATOR TRIAD HINTER, LLC (SUBSIDIARY OF BLUE RIDGE ENERGY SERVICES) ADDRESS 125 PUTNAM ST. MARIETTA OH 45750
 DESIGNATED AGENT KENNETH W. BULL ADDRESS PO BOX 154 MAVERLY WV 26104 DATE: 8/12/2019