

LATITUDE 39°30'00"

5,492'

789' TO BOTTOM HOLE  
LATITUDE 39°27'30"

LONGITUDE 80°50'00"

12,331'

LONGITUDE 80°50'00"

**RICHARD L. SEAGO ET UX LEASE**  
LORETTA J. FULKS  
D.B. 212 PG. 10  
T.M. 27 PAR. 8  
35 AC. ±

**STONE FOUND**  
WELL NO. 3H  
47-095-02173

**KATHY ANN SEAGO LEASE**  
EDWIN C. WEIGLE  
A.P. 40 PG. 99  
T.M. 27 PAR. 22  
60.19 AC. ±

**KATHY ANN SEAGO LEASE**  
EDWIN C. WEIGLE  
D.B. 348 PG. 74  
T.M. 27 PAR. 23  
61.62 AC. ±

**THOMAS L. BURKHART**  
D.B. 284 PG. 348  
T.M. 27 PAR. 24  
90 AC. ±

**KATHY ANN SEAGO LEASE**  
KATHY ANN SEAGO ET AL  
W.B. 41 PG. 119  
T.M. 27 PAR. 10  
73.59 AC. ±

**LYNDA SPELLMAN LEASE**  
REUBEN SCHWARTZ ET AL  
D.B. 119 PG. 512  
T.M. 27 PAR. 19  
86 AC. ±

**KENNETH R. MASON ET AL LEASE**  
KENNETH MASON ET AL  
D.B. 332 PG. 960  
T.M. 27 PAR. 20  
269 AC. ±

**ROGER R. WEESE LEASE**  
ROGER WEESE ET AL  
D.B. 312 PG. 200  
T.M. 2 PAR. 1  
120 AC. ±

**LARRY E. FLETCHER ET AL LEASE**  
LARRY FLETCHER ET AL  
D.B. 331 PG. 935  
T.M. 5 PAR. 15  
60 AC. ±

**EARL J. FLETCHER ET AL LEASE**  
EARL J. FLETCHER ET AL  
D.B. 158 PG. 283  
T.M. 5 PAR. 01  
36 AC. ±


**KENNETH R. MASON ET AL LEASE**  
KENNETH R. MASON ET AL  
D.B. 336 PG. 416  
T.M. 5 PAR. 14  
88.25 AC. ±

**DONALD SECKMAN ET AL**  
DONALD SECKMAN ET AL  
D.B. 278 PG. 658  
T.M. 5 PAR. 11  
97.028 AC. ±


**Antero Resources Corporation**  
Well No. Scardina Unit 3H  
47-095-02173 (AS DRILLED)

**AS DRILLED DATA**  
WELL 3H TOP HOLE INFORMATION:  
N: 354,766ft E: 1,618,090ft  
LAT: 39°27'58.13" LON: 80°51'10.03"  
BOTTOM HOLE INFORMATION:  
N: 345,200ft E: 1,622,652ft  
LAT: 39°26'24.26" LON: 80°50'10.05"  
WEST VIRGINIA COORDINATE SYSTEM OF 1927 NORTH ZONE. ZONE WAS DERIVED FROM MEASUREMENTS TAKEN WITH TRIMBLE GEOXT SUBMETER MAPPING GRADE GPS UNIT. PLAT ORIENTATION, CORNER, AND WELL REFERENCE TIE LINES ARE BASED ON GRID NORTH.

(NAD) 83 (UTM) ZONE 17 COORDS:  
WELL 3H TOP HOLE INFORMATION:  
N: 4,368,527m E: 512,678m  
BOTTOM HOLE INFORMATION:  
N: 4,365,635m E: 514,117m

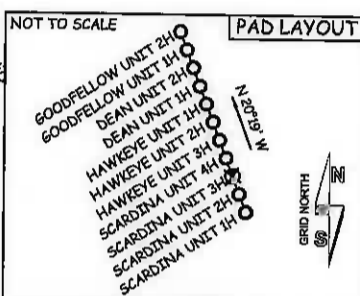

**NOTE**  
1. ONE OCCUPIED DWELLING AND NO BUILDINGS TWO THOUSAND FIVE HUNDRED (2,500) SQUARE FEET OR LARGER USED TO HOUSE OR SHELTER DAIRY CATTLE OR POULTRY HUSBANDRY ARE LOCATED WITHIN SIX HUNDRED TWENTY-FIVE (625) FEET OF THE CENTER OF THE WELL PAD.  
2. TOP HOLE DATA SHOWN HEREON WAS PROVIDED BY ALLEGHENY SURVEYS, INC.  
3. AS DRILLED DATA WAS PROVIDED BY ANTERO RESOURCES CORPORATION.  
4. WLS IS NOT CERTIFYING THE DATA AND INFORMATION PROVIDED LISTED IN NOTES 2 AND 3, ONLY THE RELATIONSHIP TO THE DATA AND INFORMATION PROVIDED TO THE LEASE BOUNDARIES.  
5. WLS IS BY NO MEANS RESPONSIBLE FOR ANY ERRORS OR INACCURACIES WITH THE DATA AND INFORMATION THAT HAS BEEN PROVIDED.

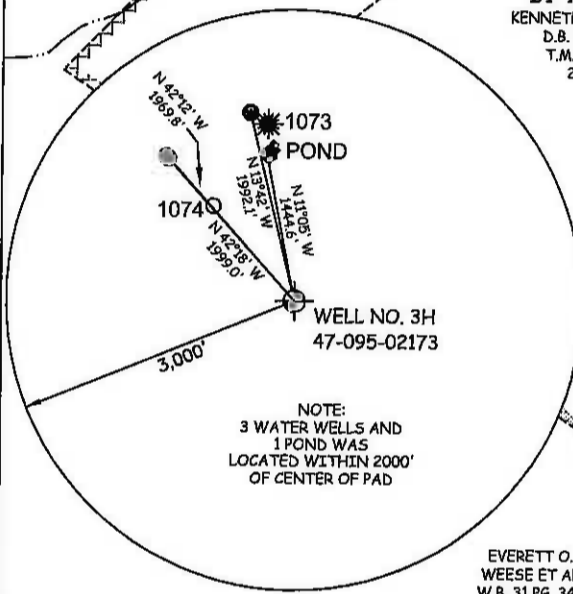

47 - 095 - 02173  
STATE COUNTY PERMIT



STATE OF WEST VIRGINIA, DIVISION OF ENVIRONMENTAL PROTECTION, OFFICE OF OIL AND GAS

WILLOW LAND SURVEYING PLLC  
220 MASONIC AVE. PENNSBORO WEST VIRGINIA 26415

JOB # 13-039WA  
DRAWING # SCARDINA3HAD  
SCALE 1" = 1000'  
MINIMUM DEGREE OF ACCURACY SUBMETER  
PROVEN SOURCE OF ELEV. SUBMETER MAPPING GRADE GPS

**LEGEND**  
--- Surface Owner Boundary Lines +/-  
--- Interior Surface Tracts +/-  
X Existing Fence  
⊕ Found monument, as noted  
○ Proposed Well Path  
⊗ As Drilled Well Path

STATE OF WEST VIRGINIA DEPARTMENT OF ENERGY DIVISION OF OIL AND GAS  
DATE 08/05/15  
OPERATOR'S WELL# SCARDINA UNIT #3H

WELL TYPE: OIL \_\_\_ GAS X LIQUID INJECTION \_\_\_ WASTE DISPOSAL \_\_\_  
(IF "GAS") PRODUCTION X STORAGE \_\_\_ DEEP \_\_\_ SHALLOW X  
LOCATION: ELEVATION ORIGINAL 811' - AS DRILLED 817' WATERSHED OUTLET MIDDLE ISLAND CREEK  
QUADRANGLE SHIRLEY 7.5' DISTRICT ELLSWORTH COUNTY TYLER  
SURFACE OWNER EDWIN C. WEIGLE ACREAGE 60.19 ACRES +/-

OIL & GAS ROYALTY OWNER KATHY ANN SEAGO; RICHARD L. SEAGO ET UX; KATHY ANN SEAGO; LYNDA SPELLMAN  
KENNETH R. MASON ET AL; ROGER R. WEESE; LARRY E. FLETCHER ET AL; EARL J. FLETCHER ET UX; KENNETH R. MASON ET AL  
LEASE ACREAGE 129.2 AC. ±; 85.45 AC. ±; 73.59 AC. ±; 86 AC. ±; 269 AC. ±; 182.74 AC. ±; 197 AC. ±; 36 AC. ±; 88.25 AC. ±

PROPOSED WORK: DRILL \_\_\_ CONVERT \_\_\_ DRILL DEEPER \_\_\_ REDRILL \_\_\_ FRACTURE OR STIMULATE \_\_\_  
PLUG OFF OLD FORMATION \_\_\_ PERFORATE NEW FORMATION \_\_\_ OTHER PHYSICAL CHANGE IN WELL (SPECIFY) (X) AS DRILLED  
TARGET FORMATION MARCELLUS ESTIMATED DEPTH 6,417' TVD 17,050' MD  
WELL OPERATOR ANTERO RESOURCES CORP. DESIGNATED AGENT DIANNA STAMPER - CT CORPORATION SYSTEM  
ADDRESS 1615 WYNKOOP STREET ADDRESS 5400 D BIG TYLER ROAD  
FORM WW-6 DENVER, CO 80202 CHARLESTON, WV 25313

10/28/2016