47-095-02213P

WW-7
8-30-06

West Virginia Department of Environmental Protection
Office of Oil and Gas
WELL LOCATION FORM: GPS

API: 4709502213 WELL NO.: SHRL-40E-HS

FARM NAME: CNX Gas Company

RESPONSIBLE PARTY NAME: CNX Gas Company

COUNTY: Tyler DISTRICT: Centerville

QUADRANGLE: Shirley

SURFACE OWNER: CNX Gas Company

ROYALTY OWNER: CNX Gas Company

UTM GPS NORTHING: 4362833.065

UTM GPS EASTING: 514245.494 GPS ELEVATION: 771

The Responsible Party named above has chosen to submit GPS coordinates in lieu of preparing a new well location plat for a plugging permit or assigned API number on the above well. The Office of Oil and Gas will not accept GPS coordinates that do not meet the following requirements:

1. Datum: NAD 1983, Zone: 17 North, Coordinate Units: meters, Altitude: height above mean sea level (MSL) – meters.
2. Accuracy to Datum – 3.05 meters
3. Data Collection Method:

Survey grade GPS _x_: Post Processed Differential ____

Real-Time Differential x

Mapping Grade GPS ____: Post Processed Differential ____

Real-Time Differential ____

4. **Letter size copy of the topography map showing the well location.**

I the undersigned, hereby certify this data is correct to the best of my knowledge and belief and shows all the information required by law and the regulations issued and prescribed by the Office of Oil and Gas.

RECEIVED
Office of Oil and Gas
AUG 20 2021
WV Department of Environmental Protection

Signature Project Manager Title 8-18-21 Date

09/10/2021

47-095-02213P

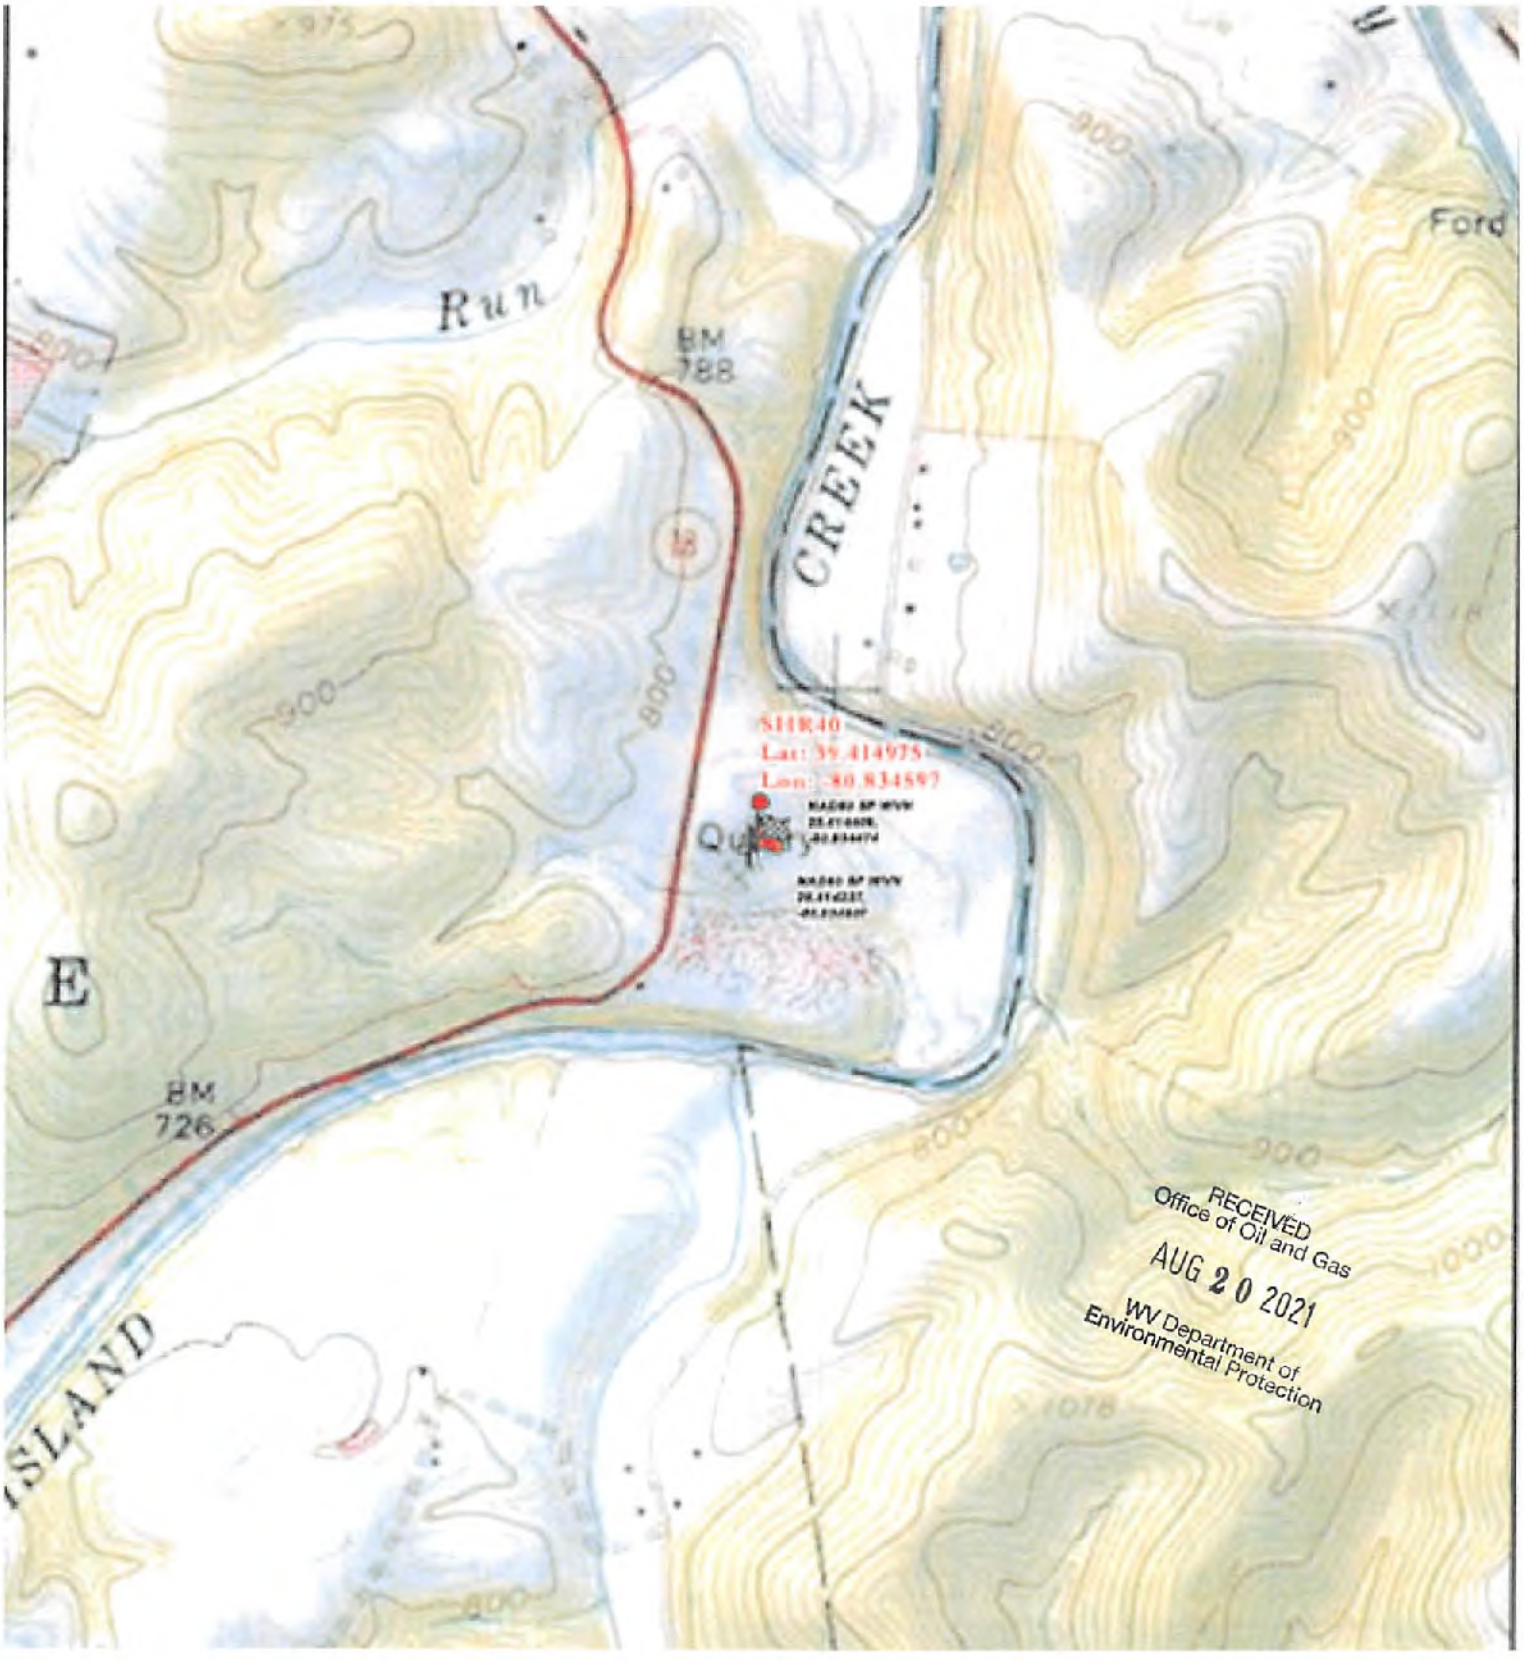

RECEIVED
Office of Oil and Gas
AUG 20 2021
WV Department of
Environmental Protection

09/10/2021