


- A-Peak TM 26-46.8 2.079 Ac.
  - B-Peak TM 26-46.20 0.652 Ac.
  - C-Peak TM 26-46.19 4.59 Ac.
  - D-Peak TM 26-46.21 0.22 Ac.
  - E-Sulser TM 20-110 4.412 Ac.
  - F-Kelly TM 26-46.18 4.323 Ac.
  - G-Kelly TM 26-46.17 4.114 Ac.
  - H-Johnson TM 26-46.23 3.598 Ac.
  - I-Johnson TM 26-46.22 2.92 Ac.
  - J-Holiday TM 26-46.13 5.94 Ac.
  - K-Holiday TM 26-46.12 3.238 Ac.
  - L-Kanz TM 26-46.3 5.4 Ac.
  - M-Patera TM 26-46.7 7.32 Ac.
  - N-JayBee TM 26-46.14 8.692 Ac.
  - O-Pittman TM 26-46.2 5.135 Ac.
  - P-Johnson TM 26-46.9 5 Ac.
  - Q-Patera TM 26-46.6 1.702 Ac.
  - R-Patera TM 26-46.15 3.722 Ac.
  - S-JayBee TM 26-46.16 5.094 Ac.
  - T-Shrader TM 26-46.1 5.58 Ac.
  - U-Ison TM 26-46.10 4.98 Ac.
  - V-Doty TM 26-46.5 13.14 Ac.
  - W-Kanz TM 26-46.4 8.1 Ac.
  - X-Walton TM 26-46.11 6.43 Ac.
  - Y-JayBee TM 26-46.24 3.059 Ac.
  - Z-JayBee TM 26-19.9 1.496 Ac.
  - KK-Weigle TM 27-22 60.19 Ac.
  - LL-Weigle TM 27-23 61.62 Ac.
- The distance between Larry SU Top Hole and Moe SU Top Hole is 3,222'. The distance of the Moe SU Top Hole to Larry SU leg is 2,087'.

- Lease Numbers**
- AA-Jay Bee Production Company TM 26-46 - RT2
  - BB-WVDNR TM 27-5 - T6002B
  - CC-WVDNR TM 27-2 - T6000E
  - DD-WVDNR TM 27-5 - T6002A
  - EE-WVDNR TM 27-2 - T6000A
  - FF-WVDNR TM 27-2 - T6000C
  - GG-WVDNR TM 27-2 - T6000D
  - HH-WVDNR TM 27-4 - T6015
  - II-WVDNR TM 27-28 - T6014
  - JJ-WVDNR TM 27-25 - T6052

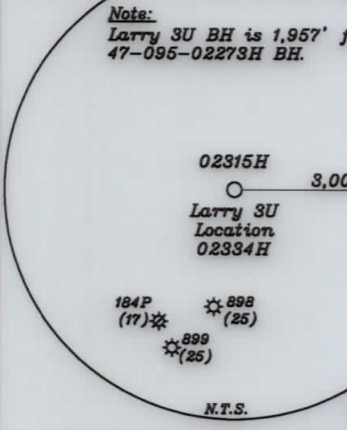

(+) DENOTES LOCATION OF WELL ON UNITED STATES TOPOGRAPHIC MAPS

FILE NO. \_\_\_\_\_  
 DRAWING NO. 1  
 SCALE 1" = 2000'  
 MINIMUM DEGREE OF ACCURACY 1 in 200  
 PROVEN SOURCE OF ELEVATION GPS  
submeter unit

I THE UNDERSIGNED, HEREBY CERTIFY THAT THIS PLAT IS CORRECT TO THE BEST OF MY KNOWLEDGE AND BELIEF AND SHOWS ALL THE INFORMATION REQUIRED BY LAW AND THE RULES ISSUED AND PRESCRIBED BY THE DEPARTMENT OF ENVIRONMENTAL PROTECTION.

(SIGNED) David L. Jackson  
 R.P.E. \_\_\_\_\_ P.S. 708



STATE OF WEST VIRGINIA  
 Division of Environmental Protection  
 OFFICE OF OIL AND GAS

DATE June 27, 2019  
 OPERATOR'S WELL NO. Larry 3U  
 API WELL NO. AsDrilled

WELL TYPE: OIL GAS LIQUID INJECTION X WASTE DISPOSAL \_\_\_\_\_  
 (IF 'GAS') PRODUCTION X STORAGE \_\_\_\_\_ DEEP X SHALLOW \_\_\_\_\_  
 LOCATION: ELEVATION 738.9' WATER SHED Middle Island Creek  
 DISTRICT Ellsworth COUNTY Tyler  
 QUADRANGLE Middlebourne 7 1/2' (TH), Shirley 7 1/2' (BH)

SURFACE OWNER Jay Bee Oil & Gas, Inc. ACREAGE 286.03 ac.  
 OIL & GAS ROYALTY OWNER Ridgetop Capital LP, and Ridgetop Capital II, LP LEASE ACREAGE 286.03 ac.  
 LEASE NO. RT2

PROPOSED WORK: DRILL X CONVERT \_\_\_\_\_ DRILL DEEPER \_\_\_\_\_ REDRILL \_\_\_\_\_ FRACTURE OR STIMULATE X PLUG OFF OLD FORMATION \_\_\_\_\_ PERFORATE NEW FORMATION X OTHER PHYSICAL CHANGE IN WELL (SPECIFY) AsDrilled

PLUG AND ABANDON \_\_\_\_\_ CLEAN OUT AND REPLUG \_\_\_\_\_  
 TARGET FORMATION Utica ESTIMATED DEPTH TVD = 11,157'; TMD = 17,956'  
 WELL OPERATOR Jay-Bee Oil & Gas, Inc. DESIGNATED AGENT Randy Broda  
 ADDRESS 1720 Route 22 E, Union, NJ 07083 ADDRESS 3570 Shields Hill Rd., Cairo, WV 26337