west virginia department of environmental protection

Office of Oil and Gas
601 57th Street, S.E.
Charleston, WV 25304
(304) 926-0450
fax: (304) 926-0452

Harold D. Ward, Cabinet Secretary
www.dep.wv.gov

Tuesday, October 27, 2026

WELL WORK PLUGGING PERMIT
Horizontal 6A Plugging

ANTERO RESOURCES CORPORATION
1615 WYNKOOP STREET

DENVER, CO 80202

Re: Permit approval for OLIVE UNIT 1H
47-095-02450-00-00

This well work permit is evidence of permission granted to perform the specified well work at the location described on the attached pages and located on the attached plat, subject to the provisions of Chapter 22 of the West Virginia Code of 1931, as amended, and all rules and regulations promulgated thereunder, and to any additional specific conditions and provisions outlined in the pages attached hereto. Notification shall be given by the operator to the Oil and Gas Inspector at least 24 hours prior to the construction of roads, locations, and/or pits for any permitted work. In addition, the well operator shall notify the same inspector 24 hours before any actual well work is commenced and prior to running and cementing casing. Spills or emergency discharges must be promptly reported by the operator to 1-800-642-3074 and to the Oil and Gas Inspector.

Upon completion of the plugging well work, the above named operator will reclaim the site according to the provisions of WV Code 22-6-30. Please be advised that form WR-38, Affidavit of Plugging and Filling Well, is to be submitted to this office within 90 days of completion of permitted well work, as should form WR-34 Discharge Monitoring Report within 30 days of discharge of pits, if applicable. Failure to abide by all statutory and regulatory provisions governing all duties and operations hereunder may result in suspension or revocation of this permit and, in addition, may result in civil and/or criminal penalties being imposed upon the operators.

Per 35 CSR 4-5.2.g this permit will expire in two (2) years from the issue date unless permitted well work is commenced. If there are any questions, please feel free to contact me at (304) 926- 0450.

H. Jason Harmon
Chief

Operator's Well Number: OLIVE UNIT 1H
Farm Name: ANTERO RESOURCES CORPORATION
U.S. WELL NUMBER: 47-095-02450-00-00
Horizontal 6A Plugging
Date Issued: 10/27/2026

10/30/2026

PERMIT CONDITIONS

West Virginia Code §22-6-11 allows the Office of Oil and Gas to place specific conditions upon this permit. Permit conditions have the same effect as law. Failure to adhere to the specified permit conditions may result in enforcement action.

CONDITIONS

1. All pits must be lined with a minimum of 20 mil thickness synthetic liner.
2. In the event of an accident or explosion causing loss of life or serious personal injury in or about the well or while working on the well, the well operator or its contractor shall give notice, stating the particulars of the accident or explosion, to the oil and gas inspector and the Chief within twenty-four (24) hours.
3. Well work activities shall not constitute a hazard to the safety of persons.
4. Notification shall be given by the operator to the Oil and Gas Inspector at least 24 hours prior to the construction of roads, locations and/or pits for any permitted work. In addition, the well operator shall notify the same inspector 24 hours before any actual well work is commenced and prior to running and cementing casing.
5. No sooner than sixty (60) days and no greater than ninety (90) days after the completion of the plugging of the well, the operator shall conduct an evaluation of the plugging operations to verify that the well is not leaking any fluid or gases and is properly sealed at the surface to prevent fluids or other materials from entering the well. Reports of such analysis are required to be provided to the agency with the permittee's filing of the WR-38. Wells affirmed to be leaking after plugging operations have completed, will be considered to not be properly plugged and may be required to be retested, repaired, and/or replugged.

10/30/2026

4709502450P

WW-4B
Rev. 2/01

1) Date September 23, 2026
2) Operator's
Well No. Olive Unit 1H
3) API Well No. 47- 095 - 02450

STATE OF WEST VIRGINIA
DEPARTMENT OF ENVIRONMENTAL PROTECTION
OFFICE OF OIL AND GAS

APPLICATION FOR A PERMIT TO PLUG AND ABANDON

4) Well Type: Oil _____/ Gas X / Liquid injection _____/ Waste disposal _____/
(If "Gas, Production ____ or Underground storage ____) Deep ____/ Shallow X

5) Location: Elevation 1158.2 Watershed Outlet Middle Island Creek
District Centerville & Meade County Tyler Quadrangle Middlebourne & Shirley

6) Well Operator Antero Resources Corporation
Address 1615 Wynkoop St
Denver, CO 80202

7) Designated Agent Conrad Baston
Address 535 White Oaks Blvd
Bridgeport, WV 26330

8) Oil and Gas Inspector to be notified
Name Stephen E. McCoy
Address 13016 Indian Creek Rd
Jacksonburg, WV 26377

9) Plugging Contractor
Name N/A - Antero will plug well
Address

10) Work Order: The work order for the manner of plugging this well is as follows:

*Please see attached work order

RECEIVED
Office Of Oil and Gas
OCT 13 2026
WV Department of
Environmental Protection

Notification must be given to the district oil and gas inspector 24 hours before permitted work can commence.

Work order approved by inspector Stephen Mccoy Digitally signed by Stephen Mccoy Date: 2026.10.09 12:01:06 -04'00' Date

10/30/2026

4709502450P

Antero Resources
1615 Wynkoop St.
Denver, CO 80202
Office: 303.357.7310
Fax: 303.357.7315

Olive 1H
Tyler County, WV
API #47-095-02450

Objective: Plug and Abandon from 2427' back to surface

Well Design:

- 20" Conductor @ 80'– Cemented to Surface – 19.124" ID
- 13.375" Surface Casing @ 607' – Cemented to Surface – 12.615" ID
- 9-5/8" Intermediate Casing @ 2,570'– Cemented to Surface - 8.921" ID
- 8 3/4 Open Hole to 6,333'
- 300' Cement Plug set @ 5299'-4999'
- 300' Cement Plug set @ 2727'-2427' covering 9 5/8" casing shoe

Oil and Gas Zones:

1. Freshwater – 78', 274', 485'
2. Coal Depths – 233', 727'
3. Salt Water – 1607', 1627'

Procedure:

1. Check and record casing surface pressures into Wellview. Verify no pressure behind 9 5/8". Bleed off pressure and monitor any build-up prior to performing any more work.
2. Notify WV DEP 24 hours prior to commencing work.
3. Move in and rig up flat tank and frac tank (No pits will be utilized).
4. MIRU Service rig with JU Head and BOP's. Pressure test well control equipment.
5. RIH with 2 3/8" tubing and attempt to wash down to TD, if unable to reach TD consult with inspector and decide on new course of action.
6. Ensure hole is filled with at least 6% Bentonite Gel from TD to surface.
7. Pull up to 1587', MIRU cement services. Mix and pump a 100' cement plug to cap the Saltwater zones at 1607' and 1627' (1487'-1587') (Class A cement, zero excess, yield =1.15 ft^3/sk, WR = 5.2 gal/sk, minimum 500 psi compressive strength)
    a. Volume inside of 9-5/8" = 0.4341 ft^3/ft
    b. 100' plug = 44 ft^3 cement.
    c. Displace to balance plug with 8.33 ppg fluid
    d. Slowly pull out of cement plug and lay down 150' of 2-3/8" tubing
    e. Circulate tubing clear of cement with 8.33ppg fluid
8. TOOH laying down tubing to 707'
9. Mix and pump a 200' cement plug to cap coal zone and cover surface casing shoe (507'-707') (Class A cement, zero excess, yield =1.15 ft^3/sk, WR = 5.2 gal/sk, minimum 500 psi compressive strength)
    a. Volume inside of 9-5/8" = 0.4341 ft^3/ft
    b. 200' plug = 88 ft^3 cement.
    c. Displace to balance plug with 8.33 ppg fluid
    d. Slowly pull out of cement plug and lay down 250' of 2-3/8" tubing
    e. Circulate tubing clear of cement with 8.33ppg fluid
10. TOOH laying down tubing to 100'.
11. MIRU cement services. Mix and pump a 100' cement plug to surface (Class A cement + 2% $CaCl_2$, zero excess, yield =1.15 ft^3/sk, WR = 5.2 gal/sk, minimum 500 psi compressive strength)

RECEIVED
Office Of Oil and Gas
OCT 13 2026
WV Department of
Environmental Protection

Stephen Mccoy
Digitally signed by Stephen Mccoy
Date: 2026.10.09 11:59:26 -04'00'
10/30/2026

4709502450P

a. Volume inside of 9-5/8" = 0.4341 ft^3/ft
b. 100' plug = 44 ft^3 cement.
c. Displace to balance plug with 8.33 ppg fluid
d. Slowly pull out of cement plug and lay down 305' of 2-3/8" tubing
e. Clean up tubing if possible
f. Install Monument Marker with API #47-095-02450

RECEIVED
Office Of Oil and Gas
OCT 13 2026
WV Department of
Environmental Protection

Stephen Mccoy

Digitally signed by Stephen Mccoy
Date: 2026.10.09 12:00:04 -04'00'

10/30/2026

4709502450P

WR-35
Rev. 8/23/13

State of West Virginia
Department of Environmental Protection - Office of Oil and Gas
Well Operator's Report of Well Work

API 47- 095 - 02450 County Tyler District Centerville
Quad Middlebourne & Shirley Pad Name Lemuel Pad Field/Pool Name ----
Farm name Antero Resources Corporation Well Number Olive Unit 1H
Operator (as registered with the OOG) Antero Resources Corporation
Address 1615 Wynkoop Street City Denver State CO Zip 80202

As Drilled location NAD 83/UTM Attach an as-drilled plat, profile view, and deviation survey
Top hole Northing 4363663.49m Easting 507458.75m
Landing Point of Curve Northing _____ Easting _____
Bottom Hole Northing _____ Easting _____

Elevation (ft) 1158.2' GL Type of Well ■New □ Existing Type of Report □Interim ■Final
Permit Type □ Deviated □ Horizontal ■ Horizontal 6A □ Vertical Depth Type □ Deep ■ Shallow
Type of Operation □ Convert □ Deepen ■ Drill □ Plug Back □ Redrilling □ Rework ■ Stimulate
Well Type □ Brine Disposal □ CBM ■ Gas ■ Oil □ Secondary Recovery □ Solution Mining □ Storage □ Other _____
Type of Completion ■ Single □ Multiple Fluids Produced □ Brine ■Gas □ NGL ■ Oil □ Other _____
Drilled with □ Cable ■ Rotary

Drilling Media Surface hole ■ Air □ Mud □Fresh Water Intermediate hole ■ Air □ Mud □ Fresh Water □ Brine
Production hole □ Air ■ Mud □ Fresh Water □ Brine
Mud Type(s) and Additive(s)
Air - Foam & 4% KCL
Mud - Polymer

Date permit issued 6/23/2017 Date drilling commenced 12/10/2017 Date drilling ceased 6/13/2018
Date completion activities began N/A Date completion activities ceased N/A
Verbal plugging (Y/N) N/A Date permission granted N/A Granted by N/A

Please note: Operator is required to submit a plugging application within 5 days of verbal permission to plug

RECEIVED
Office Of Oil and Gas
OCT 13 2026
WV Department of
Environmental Protection

Freshwater depth(s) ft 78', 274', 485' Open mine(s) (Y/N) depths No
Salt water depth(s) ft 1607', 1627' Void(s) encountered (Y/N) depths No
Coal depth(s) ft 233', 727' Cavern(s) encountered (Y/N) depths No
Is coal being mined in area (Y/N) No

Reviewed by:

10/30/2026

4709502450P

WR-35
Rev. 8/23/13

API 47- 095 - 02450 Farm name Antero Resources Corporation Well number Olive Unit 1H

CASING STRINGS	Hole Size	Casing Size	Depth	New or Used	Grade wt/ft	Basket Depth(s)	Did cement circulate (Y/ N) * Provide details below*
Conductor	26"	20"	112'	New	78.67#, A252	N/A	Y
Surface	17-1/2"	13-3/8"	639.1'	New	54.5#, J-55	N/A	Y
Coal							
Intermediate 1	12-1/4"	9-5/8"	2602'	New	36#, J-55	N/A	Y
Intermediate 2							
Intermediate 3							
Production							
Tubing							
Packer type and depth set							

Comment Details

CEMENT DATA	Class/Type of Cement	Number of Sacks	Slurry wt (ppg)	Yield (ft^3/sks)	Volume (ft^3)	Cement Top (MD)	WOC (hrs)
Conductor	Class A	204 sx	15.6	1.18	241	0'	8 Hrs.
Surface	Class A	528 sx	15.6	1.20	634	0'	8 Hrs.
Coal							
Intermediate 1	Class A	890 sx	15.6	1.20	1068	0'	8 Hrs.
Intermediate 2							
Intermediate 3							
Production							
Tubing							

Drillers TD (ft) 2602' Loggers TD (ft)

Deepest formation penetrated Plug back to (ft) N/A

Plug back procedure N/A

Kick off depth (ft)

Check all wireline logs run ☐ caliper ☐ density ☐ deviated/directional ☐ induction
☐ neutron ☐ resistivity ☐ gamma ray ☐ temperature ☐ sonic

Well cored ☐ Yes ■ No Conventional Sidewall Were cuttings collected ☐ Yes ■ No

DESCRIBE THE CENTRALIZER PLACEMENT USED FOR EACH CASING STRING

Conductor - 0

Surface - 1 above guide shoe, 1 above insert float, 1 every 4th joint to surface

Intermediate - 1 above float joint, 1 above float collar, 1 every 4th joint to surface

WAS WELL COMPLETED AS SHOT HOLE ☐ Yes ■ No DETAILS

WAS WELL COMPLETED OPEN HOLE? ☐ Yes ■ No DETAILS

WERE TRACERS USED ☐ Yes ■ No TYPE OF TRACER(S) USED N/A

RECEIVED
Office Of Oil and Gas
OCT 13 2026
WV Department of
Environmental Protection

10/30/2026

4709502450P

WR-35
Rev. 8/23/13

API 47- 095 - 02450 Farm name Antero Resources Corporation Well number Olive Unit 1H

PERFORATION RECORD

Stage No.	Perforation date	Perforated from MD ft.	Perforated to MD ft.	Number of Perforations	Formation(s)

Please insert additional pages as applicable.

STIMULATION INFORMATION PER STAGE

Complete a separate record for each stimulation stage.

Stage No.	Stimulations Date	Ave Pump Rate (BPM)	Ave Treatment Pressure (PSI)	Max Breakdown Pressure (PSI)	ISIP (PSI)	Amount of Proppant (lbs)	Amount of Water (bbls)	Amount of Nitrogen/other (units)

RECEIVED
Office Of Oil and Gas
OCT 13 2026
WV Department of
Environmental Protection

Please insert additional pages as applicable.

10/30/2026

4709502450P

WR-35
Rev. 8/23/13

API 47- 095 - 02450 Farm name Antero Resources Corporation Well number Olive Unit 1H

PRODUCING FORMATION(S)	DEPTHS	
Marcellus	TVD	MD

Please insert additional pages as applicable.

GAS TEST ☐ Build up ☐ Drawdown ■ Open Flow OIL TEST ■ Flow ☐ Pump

SHUT-IN PRESSURE Surface _____ psi Bottom Hole --- psi DURATION OF TEST --- hrs

OPEN FLOW Gas _____ mcfpd Oil _____ bpd NGL --- bpd Water _____ bpd GAS MEASURED BY ☐ Estimated ■ Orifice ☐ Pilot

LITHOLOGY/ FORMATION	TOP DEPTH IN FT NAME TVD	BOTTOM DEPTH IN FT TVD	TOP DEPTH IN FT MD	BOTTOM DEPTH IN FT MD	DESCRIBE ROCK TYPE AND RECORD QUANTITY AND TYPE OF FLUID (FRESHWATER, BRINE, OIL, GAS, H_2S, ETC)
	0		0		

Please insert additional pages as applicable.

Drilling Contractor Frontier Drilling
Address 562 Heritage Dr City Pennsboro State WV Zip 26415

Logging Company _____
Address _____ City _____ State _____ Zip _____

Cementing Company C & J Services
Address 1650 Hackers Creek Rd City Jane Lew State WV Zip 26378

Stimulating Company _____
Address _____ City _____ State _____ Zip _____
Please insert additional pages as applicable.

RECEIVED
Office Of Oil and Gas
OCT 13 2026
WV Department of
Environmental Protection

Completed by Carly Wren Telephone 303-357-7373
Signature _____ Title Permitting Agent Date 9/23/2026

Submittal of Hydraulic Fracturing Chemical Disclosure Information Attach copy of FRACFOCUS Registry

10/30/2026

C&J SERVICES
O-TEX CEMENTING

4709502450

Customer:	Antero Resources Corporation	**Date:**	6/10/2018	**Serv. Supervisor:**	Dave Thome
Cust. Rep.:		**Ticket #:**	JWV1806-0010	**Serv. Center**	Jane Lew, WV
Lease:	Olive 1H	**API Well #:**	47-095-02450	**County:** Tyler	**State:** West Virginia
Well Type:		**Rig:**	Frontier 32	**Type of Job:**	Intermediate Casing

Materials Furnished by C&J ENERGY SERVICES

Plugs	Casing Hardware		Physical Slurry Properties					
			Sacks of Cement	Fluid Dens (lb/gal)	Yield (cuft/sk)	Mix Water (gal/sk)	Fluid Volume (bbls)	Mix Water (bbls)
Spacer 1:	Water		-	8.34				
Lead								
Tail:	CJ910 + 0.125 LB/SK CJ600		900	15.6	1.18	5.21	189	112
Displacement Chemicals:								

OPEN HOLE DATA			TUBULAR DATA								
SIZE (in)	EXCESS (%)	DEPTH (ft)	TYPE (CSG/TBG/DP)	OD (in)	WEIGHT (lbs/ft)	THREAD	DEPTH (ft)	GRADE	ID (in)	BURST (psi)	COLLAPSE (psi)
12 1/4		2601	Casing	9 5/8	36		2602		8.92		

PREVIOUS CASING DATA				PERFORATED INTERVAL DATA				CASING EQUIPMENT DEPTHS			
SIZE (in)	WEIGHT (lbs/ft)	ID (in)	DEPTH (ft)	TOP	BTM	SPF	SIZE	SHOE	FLOAT	STAGE	ACP
13 3/8	54.5	12.61	639					2602	2556		

WELL FLUID		DISPLACEMENT FLUID (STG 1)		DISPLACEMENT FLUID (STG 2)				WATER ON LOC (bbl)	DIFF PRESS (psi)	CSG LIFT (psi)	MAX PRESS (psi)
TYPE	DENSITY	VOLUME	TYPE	DENSITY	VOLUME	TYPE	DENSITY				
Water	8.3 ppg	198 bbl	Water	8.3 ppg				1000	1075	1264	

Time	Rate (bbl/min)	Csg. Press. (psi)	Tbg. Press (psi)	Ann. Press. (psi)	Stg. Vol. (bbl)	Cum. Vol. (bbl)	Stage Details
2:30 AM						0	Arrived On Location
4:00 AM						0	Location Time
6:00 AM						0	Rigged Up(waiting on casin crew)
7:30 AM						0	Safety Meeting
8:00 AM		2500				0	Psi Test
8:05 AM	6	175			25	25	Gel
8:07 AM	8	375			10	35	Water
8:10 AM	7	560			189	224	Slurry
8:45 AM						224	SD DP
8:47 AM	6	757			198	422	Disp
9:13 AM	4	1722				422	Plug Landed
9:28 AM						422	Released Psi (1.5 bbl back)
11:00 AM						422	Washed Up Rigged Down

RECEIVED
Office Of Oil and Gas
OCT 13 2026
WV Department of
Environmental Protection

Left Yard				Left Loc.				Start Pump	
Arrived Loc.				Returned Yd				End Pump	
Bumped Plug (psi)	Final Differential (psi)	Floats Held (Y/N)	PSI Left on Casing	Cement to Surface (bbl)	Full Circ. During Job (Y/N)	Max Pump Pressure (psi)	Standby Charged (hrs)	Dave Thorne	
Yes	876	Yes		48	Yes			Service Supervisor	

4709502450

10/30/2026

4709502450P

RECEIVED
Office Of Oil and Gas
OCT 13 2026
WV Department of
Environmental Protection

OLIVE UNIT 4H - API#47-095-02441
OLIVE UNIT 1H - API#47-095-02450
MIDGE UNIT 4H - API#47-095-02440

WELL PLUGGING PLAN

CENTERVILLE & MEADE DISTRICTS, TYLER COUNTY, WEST VIRGINIA
SANCHO CREEK WATERSHED
USGS 7.5 MIDDLEBOURNE & SHIRLEY QUAD MAPS

LOCATION COORDINATES:
ACCESS ROAD ENTRANCE
LATITUDE: 39.443800 LONGITUDE: -80.811902 (NAD 83)
N 4366418.69 E 509826.69 (UTM ZONE 17 METERS)

CENTROID OF WELL PAD
LATITUDE: 39.444111 LONGITUDE: -80.809697 (NAD 83)
N 4366461.51 E 509941.11 (UTM ZONE 17 METERS)

GENERAL DESCRIPTION
THE ACCESS ROADS, WATER CONTAINMENT PAD, AND WELL PAD ARE BEING UPGRADED TO USE IN THE PLUGGING OF EXISTING HORIZONTAL GAS WELLS.

FLOODPLAIN NOTES:
THE SITE IS LOCATED WITHIN FEMA FLOOD ZONE 'X' PER FEMA FLOOD MAP #5409500500C.

MISS UTILITY STATEMENT:


ENVIRONMENTAL NOTES:
STREAM AND WETLAND DELINEATIONS WERE PERFORMED WITHIN/NEAR THE PROJECT LIMITS BY ALLEGHENY ECO SCIENCE, INC. & ALLEGHENY ECO SCIENCE, LLC. ALLEGHENY ECO SCIENCE, LLC PERFORMED A FIELD SURVEY TO DETERMINE THE REGULATORY PRESENCE OF THE U.S. ARMY CORPS OF ENGINEERS (USACE) AND/OR WEST VIRGINIA DEPARTMENT OF ENVIRONMENTAL PROTECTION (WVDEP) JURISDICTIONAL WATERS OF THE UNITED STATES (WOTUS) WITHIN THE PROJECT AREA. THE FIELD SURVEY WAS PERFORMED BY QUALIFIED PERSONNEL ON NOVEMBER 6, 2019 PRIOR TO A MAP AND REPORT BEING PREPARED BY ALLEGHENY ECO SCIENCE, LLC. A DELINEATION REPORT, DATED NOVEMBER 6, 2019 WAS SUBMITTED TO THE USACE FOR VERIFICATION. THE MAP DOES NOT IDENTIFY ALL WETLANDS AND STREAMS ON THE SITE, BUT ONLY THOSE WHICH MAY BE REGULATED BY THE USACE OR THE WVDEP.

PROJECT CONTACTS:

OPERATOR:
ERIC WHITE, OWNER'S REP.
1000 VIP PARK DRIVE, SUITE 250
MORGANTOWN, WV 26508
PHONE: (304) 413-0170
FAX: (304) 413-0178

BILL WARNER - ENVIRONMENTAL MONITORING & REGULATORY MANAGER
OFFICE: (304) 413-0170 CELL: (304) 479-8770

JON MATHEWS - SITE OPERATIONS
OFFICE: (304) 367-0178

AARON FORTNEY - CONSTRUCTION MANAGER
PHONE: (304) 513-4181

TOMMY WEBB - DRIVER MANAGER
OFFICE: (304) 842-4100 CELL: (304) 457-7415

ROBERT SCOTT - UTILITY COORDINATOR
CELL: (304) 719-0349

BRET SNOOK - LAND AGENT
CELL: (304) 588-9272

ENGINEER/SURVEYOR:
CHRISTOPHER TENNANT, PE
CARTER ENGINEERING, PLLC - PROJECT MANAGER/ENGINEER
OFFICE: (304) 842-4185 CELL: (540) 818-4747

ENVIRONMENTAL:
ALLEGHENY ECO SCIENCE, LLC
JASON A. COOK - SENIOR ENVIRONMENTAL SPECIALIST
OFFICE: (304) 842-4100 CELL: (304) 709-2004

WEST VIRGINIA STATE PLANE COORDINATE SYSTEM
NORTH ZONE, NAD83
ELEVATION BASED ON NAVD88
ESTABLISHED BY SURVEY GRADE GPS & OPUS POST-PROCESSING

SHEET INDEX:
1 -- COVER SHEET
2 -- GENERAL CONSTRUCTION AND E&S CONTROLS NOTES
3 -- LEGEND
4 -- OVERALL PLAN SHEET INDEX
5 -- WELL PAD SHEET INDEX
6 -- WELL PAD AS-BUILT PLAN
7 -- CONSTRUCTION DETAILS

Total Disturbed Area	4.57
Total Wooded Area Disturbed	0.00

REPRODUCTION NOTE
THESE PLANS WERE CREATED TO BE PLOTTED ON 22"x34" (ARCH D) PAPER. HALF SCALE DRAWINGS ARE ON 11"x17" (ARCH B) PAPER.
THESE PLANS WERE CREATED FOR COLOR PLOTTING AND ANY REPRODUCTION IN BLACK & WHITE MAY RESULT IN A LOSS OF INFORMATION AND SHOULD NOT BE USED FOR CONSTRUCTION PURPOSES.

MISS Utility of West Virginia
1-800-245-4848
West Virginia State Law
(Section XII: Chapter 24-C)
Requires that you call two
business days before you dig in
the state of West Virginia.
It's the law!!

DATE	REVISION

NAVITUS
ENERGY ENGINEERING

COVER SHEET

LEMUEL
WELL PAD & WATER CONTAINMENT PAD
CENTERVILLE & MEADE DISTRICTS
TYLER COUNTY, WEST VIRGINIA

DATE: 06/24/2026
SCALE: AS SHOWN
SHEET 1 OF 6

4709502451P

10/30/2026

4709502450

10/30/2026

CONSTRUCTION AND E&S CONTROL NOTES

CONSTRUCTION NOTES:

1. THE CONTRACTOR IS TO VERIFY FIELD CONDITIONS PRIOR TO AND DURING CONSTRUCTION AND WILL NOTIFY NAVITUS ENGINEERING AT (866) 986-6188 IMMEDIATELY OF ANY DISCREPANCIES BETWEEN ACTUAL FIELD CONDITIONS AND THE APPROVED PLANS. ANY WORK PERFORMED BY THE CONTRACTOR AFTER THE FINDING OF SUCH DISCREPANCIES SHALL BE DONE AT THE CONTRACTOR'S RISK.

2. METHODS AND MATERIALS USED IN THE CONSTRUCTION OF THIS IMPROVEMENTS HEREIN SHALL CONFORM TO THE CURRENT COUNTY CONSTRUCTION STANDARDS AND SPECIFICATIONS AND/OR CURRENT WV DEP EROSION AND SEDIMENT CONTROL BEST MANAGEMENT PRACTICE MANUAL STANDARDS AND SPECIFICATIONS. SHOULD A CONFLICT BETWEEN THE DESIGN, SPECIFICATIONS, AND PLANS OCCUR, THE MORE STRINGENT REQUIREMENT WILL APPLY. THE APPROVAL OF THESE PLANS IN NO WAY RELIEVES THE DEVELOPER OR HIS AGENT OF THE RESPONSIBILITIES CONTAINED IN THE WV DEP EROSION AND SEDIMENT CONTROL BEST MANAGEMENT PRACTICE MANUAL.

3. AN APPROVED SET OF PLANS AND ALL APPLICABLE PERMITS MUST BE AVAILABLE AT THE CONSTRUCTION SITE. ALSO, A REPRESENTATIVE OF THE DEVELOPER MUST BE AVAILABLE AT ALL TIMES.

4. THE CONTRACTOR SHALL PROVIDE ADEQUATE MEANS OF CLEANING MUD FROM TRUCKS AND/OR OTHER EQUIPMENT PRIOR TO ENTERING PUBLIC STREETS, AND IT IS THE CONTRACTOR'S RESPONSIBILITY TO CLEAN STREETS, ALLEY WAYS, AND TO TAKE WHATEVER MEASURES ARE NECESSARY TO ENSURE THAT THE STREETS ARE MAINTAINED IN A CLEAN, MUD AND DUST FREE CONDITION AT ALL TIMES.

5. THE LOCATION OF EXISTING UTILITIES SHOWN IN THESE PLANS ARE FROM FIELD LOCATIONS AND/OR GIS DATA. IT SHALL BE THE CONTRACTOR'S RESPONSIBILITY TO VERIFY THE EXACT HORIZONTAL AND VERTICAL LOCATION OF ALL EXISTING UTILITIES AS NEEDED PRIOR TO CONSTRUCTION. THE CONTRACTOR SHALL INFORM THE RESPONSIBLE OF ANY CONFLICTS ARISING FROM THE EXISTING UTILITY VERIFICATION AND THE PROPOSED CONSTRUCTION.

6. THE CONTRACTOR SHALL PROVIDE NOTIFICATION TO THE APPROPRIATE UTILITY COMPANY PRIOR TO CONSTRUCTION OF WATER AND/OR GAS PIPELINES. NOTIFICATION SHOULD ALSO BE GIVEN TO THE APPROPRIATE AUTHORITY CONCERNING PERMITS, CUT BONDS, AND CONNECTIONS TO EXISTING LINES.

7. THE CONTRACTOR WILL BE RESPONSIBLE FOR THE REPAIR OF ANY DAMAGES TO THE EXISTING STREETS AND UTILITIES WHICH INCLUDE AS A RESULT OF THE CONSTRUCTION PROJECT WITH OR WITHOUTDOES HAVE THE EXISTING RIGHT-OF-WAY.

8. WHERE GRADING IS PROPOSED WITHIN EASEMENTS OF UTILITIES, LETTERS OF PERMISSION FROM ALL INVOLVED COMPANIES MUST BE OBTAINED PRIOR TO GRADING AND/OR SITE DEVELOPMENT.

9. THE DEVELOPER WILL BE RESPONSIBLE FOR THE RELOCATION OF ANY UTILITIES WHICH IS REQUIRED AS A RESULT OF HIS PROJECT. THE RELOCATION SHOULD BE DONE PRIOR TO CONSTRUCTION.

10. THESE PLANS INDICATE THE LOCATION OF ALL KNOWN GRAVESITES. GRAVESITES KNOWN ON THIS PLAN WILL BE PROTECTED IN ACCORDANCE WITH STATE LAW. IN THE EVENT ONE WHICH IS NOT DISCOVERED DURING CONSTRUCTION, THE OWNER AND ENGINEER MUST BE NOTIFIED IMMEDIATELY.

11. THE CONTRACTOR(S) SHALL NOTIFY OPERATORS WHO MAINTAIN UNDERGROUND UTILITY LINES IN THE AREA OF PROPOSED EXCAVATIONS OR BLASTING AT LEAST TWO (2) WORKING DAYS, BUT NOT MORE THAN TEN (10) WORKING DAYS, PRIOR TO COMMENCEMENT OF EXCAVATION OR DEMOLITION.

12. CONTRACTOR TO CONTACT OPERATOR AND ENGINEER IF GROUNDWATER IS ENCOUNTERED DURING CONSTRUCTION.

13. THE CONTRACTOR SHALL SCHEDULE A PRE-CONSTRUCTION MEETING WITH THE EROSION AND SEDIMENT CONTROL INSPECTOR 2 DAYS PRIOR TO THE START OF CONSTRUCTION.

14. THE CONTRACTOR IS RESPONSIBLE FOR ALL FILL MATERIAL PLACEMENT REQUIRED DURING THE CONSTRUCTION OF THIS PROJECT. ALL MATERIAL TESTS SHALL BE CONDUCTED BY THE ON-SITE INSPECTOR. ALL TEST RESULTS SHALL BE SUBMITTED TO THE ENGINEER CERTIFYING THE CONSTRUCTED FACILITY. FAILURE TO CONDUCT THE DENSITY TESTS AND/OR NECESSARY REPAIRS TO DEFICIENT AREAS AS A RESULT OF THE DENSITY TESTING SHALL BE CAUSE FOR NON-ACCEPTANCE OF THE CONSTRUCTED FACILITY.

15. THE CONTRACTOR IS RESPONSIBLE FOR CONSTRUCTING THE SITE IN ACCORDANCE WITH THE DESIGN PLANS AND CONSTRUCTION DOCUMENTS AND THE SCOPE OF WORK SHALL CONFORM WITH THE GRADES, NOTES, DETAIL DIMENSIONS, ETC. SHOWN HEREON.

16. SUPER SILT FENCE CAN BE USED IN PLACE OF ANY COMPOST FILTER SOCK.

17. IT SHALL BE THE SOLE RESPONSIBILITY OF THE CONTRACTOR TO COMPLY WITH ALL FEDERAL, STATE, AND LOCAL SAFETY REQUIREMENTS, INCLUDING THE 1970 OSHA ACT. PRECAUTION FOR THE PROTECTION OF PERSONS, INCLUDING EMPLOYEES AND PROPERTY, SHALL BE/ARE BE EXERCISED BY THE CONTRACTOR. INITIATION, MAINTENANCE, AND SUPERVISION OF ALL SAFETY REQUIREMENTS, PRECAUTIONS, AND PROGRAMS IN CONNECTION WITH THE WORK, INCLUDING ALL REQUIREMENTS PER CFR 1910.146, SHALL ALSO BE THE SOLE RESPONSIBILITY OF THE CONTRACTOR.

18. CONSTRUCTION ACTIVITIES SHALL BE RESTRICTED TO THE AREAS SHOWN ON THE PLANS WITHIN THE LIMITS OF DISTURBANCE, UNLESS OTHERWISE AUTHORIZED BY ANTERO RESOURCES CORPORATION. MODIFICATION PLAN MUST BE SUBMITTED TO THE DEP FOR ANY FACILITIES PROPOSED OUTSIDE OF THE LIMITS OF DISTURBANCE.

19. PRESERVATION OF BENCHMARKS, PROPERTY CORNER, REFERENCE POINTS, BEARD AND OTHER SURVEY REFERENCE POINTS, MONUMENTS OR MARKERS IS THE RESPONSIBILITY OF THE CONTRACTOR. IN CASES OF WILLFUL OR CARELESS DESTRUCTION THE CONTRACTOR SHALL BE RESTORED TO REPLACE OR RESTORE SAID MONUMENT OR MARKER. RESETTING OF MARKERS SHALL BE PERFORMED BY A PROFESSIONAL SURVEYOR AS APPROVED BY ANTERO RESOURCES CORPORATION.

20. THE CONTRACTOR SHALL MAINTAIN ADEQUATE CLEARANCES FROM ALL ELECTRIC LINES, IF ANY, IN ACCORDANCE WITH NATIONAL ELECTRICAL SAFETY CODE.

21. THE CONTRACTOR SHALL MINIMIZE ALL CLEARING AND DISTURBANCE TO THE ENVIRONMENT TO THE MAXIMUM EXTENT POSSIBLE. CLEARING, GRUBBING, AND TOPSOIL STRIPPING SHALL BE LIMITED TO THOSE AREAS DESIGNED IN EACH STAGE OF THE CONSTRUCTION SEQUENCE.

22. ANY DIGITAL FILES PROVIDED TO THE CONTRACTOR BY NAVITUS ENGINEERING, INC. ARE PROVIDED FOR THE CONVENIENCE OF THE CONTRACTOR ONLY. THE CONSTRUCTION OF THE SITE SHALL MIRROR ALL DESIGN PARAMETERS OF THE HYDRO APPROVED NAVITUS ENGINEERING, INC. DESIGN PLANS. NAVITUS ENGINEERING, INC. WILL NOT BE HELD LIABLE FOR THE CONTRACTOR USING THE DIGITAL FILES TO WAIVER FROM THE APPROVED DESIGN PLANS.

23. ANY CONSTRUCTION ISSUES OR QUESTIONS SHALL BE BROUGHT TO THE ENGINEER IMMEDIATELY. THE CONSTRUCTION INSPECTOR SHALL BE CONTACTED AND MUST RELAY THESE ISSUES OR QUESTIONS TO THE ENGINEER FOR RESOLUTION. TEMPORARY STABILIZATION SHALL BE APPLIED AS NECESSARY.

24. ALL EXISTING AND REMOVED CULVERTS AND CULVERT SCRIPS SHALL BE CLEANED AND CLEARED OF DEBRIS DURING THE COURSE OF CONSTRUCTION. ANY EXCESS SEDIMENT DUE TO THE PLUGGING OF A CULVERT SHALL BE THE SOLE RESPONSIBILITY OF THE CONTRACTOR.

EROSION AND SEDIMENT CONTROL NARRATIVE:

PROJECT DESCRIPTION: THE PURPOSE OF THIS PROJECT IS TO UPGRADE A GAS WELL PLUGGING PAD TO AN SITE IS LOCATED ON THE NORTH SIDE OF CO. RT. 20/1, 0.66 MILES NORTHWEST OF THE INTERSECTION OF CO. RT. 20/1 & CO. RT. 20 IN CENTERVILLE & MEADE DISTRICT, TYLER COUNTY, WEST VIRGINIA. THE TOTAL APPROXIMATE LAND DISTURBANCE ASSOCIATED WITH THIS PROJECT IS 6.17 ACRES.

EXISTING SITE CONDITIONS: THE EXISTING SITE IS APPROXIMATELY 6.05% WOODED. THE TOPOGRAPHY RANGES FROM MODERATE TO STEEP TERRAIN (8% TO 60% SLOPES). PRESENT ON SITE ARE ACCESS ROADS, EXISTING WATERLINES, EXISTING PIPELINES, EXISTING STRUCTURES, AN EXISTING GAS WELL AND YARDS ASSOCIATED WITH THE EXISTING GAS WELL. THE SITE DRAINS TO HANGING GREEN WATERSHED. NO EROSION WAS NOTICED ON SITE.

ADJACENT PROPERTY: THE SITE IS BORDERED BY FORESTED LANDS ON ALL SIDES.

CRITICAL AREAS: THE AREAS SHOWN ALONG THE FIELD DELINEATED STREAMS, WETLANDS, AND PONDS, AS SHOWN ON THE PLANS, ARE DESIGNATED AS CRITICAL AREA(S). IF PRESENT. ALL 2:1 SLOPES AND STEEPER, DITCHES, AND OTHER CONTROLS SHALL BE CONSIDERED CRITICAL EROSION AREAS. THESE AREAS SHALL BE MONITORED AND MAINTAINED DAILY DURING CONSTRUCTION AND AFTER EACH RAINFALL OF 0.5 INCHES OR GREATER. COMPOST FILTER SOCKS ARE TO BE USED TO PROTECT THESE FIELD DELINEATED AREA(S) FROM SEDIMENT LEAVING THE SITE. ADDITIONALLY, ORANGE SAFETY FENCE IS RECOMMENDED TO BE INSTALLED AROUND/AROUND THESE AREA(S), TO SERVE AS A PHYSICAL BARRIER, IGNORING THE AREA(S) ARE NOT DISTURBED. THE LOCAL GOVERNING AUTHORITY WILL MAKE THE AUTHORITY TO RECOMMEND THE PLACEMENT OF ADDITIONAL EROSION CONTROL MEASURES IN THESE AREAS IF IT BECOMES EVIDENT DURING CONSTRUCTION THAT THE ONES IN PLACE ARE NOT FUNCTIONING SUFFICIENTLY.

KARST: NO KARST FEATURES WERE ENCOUNTERED

OFF SITE AREAS: THERE ARE NO KNOWN OFF-SITE AREA(S) OR REPORT STOCKPILE AREA(S) OUTSIDE OF THE PROPOSED LIMITS OF DISTURBANCE FOR THIS PROJECT.

EROSION AND SEDIMENT CONTROL MEASURES: UNLESS OTHERWISE INDICATED, ALL TEMPORARY AND STRUCTURAL EROSION AND SEDIMENT CONTROL MEASURES SHALL BE CONSTRUCTED AND MAINTAINED ACCORDING TO MINIMUM STANDARDS AND SPECIFICATIONS OF THE CURRENT WEST VIRGINIA EROSION AND SEDIMENT CONTROL BEST MANAGEMENT PRACTICE MANUAL.

CONSTRUCTION SEQUENCE:

1. INSTALL ORANGE SAFETY FENCE TO ENSURE NO DISTURBANCE TO THE DELINEATED AREA(S).
2. INSTALL TEMPORARY CONSTRUCTION ENTRANCE.
3. INSTALL COMPOST FILTER SOCKS AND/OR SILT FENCE AS SHOWN ON THE PLANS TO REMOVE SEDIMENT FROM RUNOFF. PERIODICALLY REMOVE TRASH GENERATED TO DOWNSLOPE COMPOST FILTER SOCK IN WORKED AREAS. CLEANING AND CHANGING SHALL BE KEPT AT A MINIMUM TO INSTALL BMP CONTROLS.
4. FILL SLOPE SURFACE SHALL BE LEFT IN A ROUGHENED CONDITION TO REDUCE EROSION. CONTRACTOR SHALL ROUGHEN SLOPES TO RAY FROM THE FILL SLOPE BY INSTALLING EARTHEN DIVERSION BERMS AND DIVERTING THE RUNOFF TO SEDIMENT TRAPPING DEVICES.
5. INSTALL V-DITCHES, DITCH RELIEF CULVERTS, AND OUTLET PROTECTION (RIP-RAP APRONS) AS SHOWN ON THE PLANS.

DEVICES LISTED ABOVE ARE CONSIDERED MINIMUM EROSION AND SEDIMENT CONTROLS. ADDITIONAL CONTROL MEASURES MAY BE NECESSARY DUE TO CONTRACTOR PHASING OR OTHER UNFORESEEN CIRCUMSTANCES. IMMEDIATELY UPON DISCOVERING UNFORESEEN CIRCUMSTANCES POSING THE POTENTIAL FOR ACCELERATED EROSION AND/OR SEDIMENT POLLUTION, THE CONTRACTOR SHALL IMPLEMENT APPROPRIATE BMP'S TO MINIMIZE THE POTENTIAL FOR EROSION AND SEDIMENT POLLUTION. ALL MEASURES SHALL BE CONSTRUCTED AND MAINTAINED ACCORDING TO MINIMUM STANDARDS AND SPECIFICATIONS OF THE CURRENT WEST VIRGINIA EROSION AND SEDIMENT CONTROL BEST MANAGEMENT PRACTICE MANUAL. ALL RUNOFF FROM DISTURBED AREAS SHALL PASS THROUGH A SEDIMENT FILTERING DEVICE LOCATED BELOW THE DISTURBED AREA, AT NO TIME SHALL UNFILTERED SEDIMENT LADEN RUNOFF BE ALLOWED TO LEAVE THE SITE AND ENTER STATE WATERS.

PERMANENT STABILIZATION: ALL AREAS LEFT UNCOVERED BY EITHER BUILDINGS OR PAVEMENT SHALL BE STABILIZED WITH PERMANENT SEEDING IMMEDIATELY FOLLOWING FINISH GRADING AND WITHIN SEVEN (7) DAYS. AT NO TIME SHALL LAND LAY DORMANT LONGER THAN TWENTY-ONE (21) DAYS.

MAINTENANCE PROGRAM: DURING CONSTRUCTION ACTIVITIES, ALL CONTROL MEASURES SHALL BE INSPECTED DAILY BY THE SITE SUPERINTENDENT OR HIS REPRESENTATIVE AND WITHIN TWENTY-FOUR (24) HOURS AFTER ANY SIGNIFICANT RAIN EVENT, WHICH SHALL BE DEFINED AS RAINFALL OF (0.5) INCHES OR MORE IN A TWENTY-FOUR (24) HOUR PERIOD. SINCE CONSTRUCTION ACTIVITIES HAVE CONCLUDED, THE SITE SHALL BE INSPECTED EVERY TWO (2) WEEKS AND EVERY TWENTY-FOUR (24) HOURS OF A SIGNIFICANT RAIN EVENT AS DEFINED ABOVE. ANY DAMAGED STRUCTURES, MEASURES ARE TO BE REPAIRED, BY THE END OF THE DAY, OR AT THE LATEST TIME IN WHICH IT IS SAFE TO DO SO. SEEDED AREAS SHALL BE CHECKED PERIODICALLY TO ENSURE THAT A GOOD STAND OF GRASS IS MAINTAINED. ALL AREAS SHALL BE FERTILIZED AND RESEEDED AS NEEDED UNTIL GRASS IS ESTABLISHED.

TRAPPED SEDIMENT IS TO BE REMOVED AS REQUIRED TO MAINTAIN 50% TRAP AND/OR SOCK EFFICIENCY AND DISPOSED OF AS DESCRIBED THEREIN ON THE STOCKPILES.

OUTLETS AND OUTLETS OF DITCH RELIEF CULVERTS SHALL BE CHECKED REGULARLY FOR SEDIMENT BUILD-UP. IF THE INLET BMP/OR OUTLET IS CLOGGED BY SOIL OR GREATER, IT SHALL BE REMOVED AND CLEANED OR REPLACED IMMEDIATELY.

SEDIMENT TRACKED ONTO ANY PUBLIC ROADWAY OR SIDEWALK SHALL BE RETURNED TO THE CONSTRUCTION SITE IMMEDIATELY AND DISPOSED IN THE MANNER DESCRIBED IN THIS PLAN. IN NO CASE SHALL THE SEDIMENT BE WASHED, SHOVELED OR SWEPT INTO ANY ROADSIDE DITCH, COURSE OR SURFACE WATER.

ANY DISTURBED AREAS ALONG THE ACCESS ROAD SHALL BE STABILIZED AS CONSERVATION PRACTICE, PRIOR TO CONTINUING FURTHER ACCESS ROAD CONSTRUCTION, WITH EITHER ROCK STABILIZATION OR SEEDING AND MULCHING METHODS.

SUPER SILT FENCE CAN BE USED IN PLACE OF ANY COMPOST FILTER SOCK.

NOTE: THE WV DEP REVIEWS THE SCOPE TO ADD AND/OR MODIFY THESE EROSION AND SEDIMENT CONTROL MEASURES DURING THE CONSTRUCTION PROCESS, WITHIN REASON, TO ENSURE ADEQUATE PROTECTION TO THE PUBLIC AND THE ENVIRONMENT.

SEDIMENT TRAP SUMMARY:
1. CONTRACTOR SHALL APPLY SEED AND STABILIZATION IN ACCORDANCE WITH THE WV DEP EROSION AND SEDIMENT CONTROL BEST MANAGEMENT PRACTICE (BMP) MANUAL BASED UPON SITE SPECIFIC SOIL CHARACTERISTICS.
2. WINTERIZED SEEDING MIX TO BE APPLIED TO STEEP SLOPES (≥ 30%?), SEED MIXTURES SHOULD BE SELECTED THAT ARE APPROPRIATE FOR STEEP SLOPES.

DUST CONTROL:
1. TEMPORARY SEEDING SHALL BE APPLIED TO ALL DISTURBED AREAS SUBJECT TO LITTLE OR NO CONSTRUCTION TRAFFIC.
2. ALL HAUL ROADS AND OTHER HEAVY TRAFFIC BOUYER SHALL BE SPRINKLED WITH WATER UNTIL THE SURFACE IS WET AND REPEATED AS NEEDED TO CONTROL DUST.

CONSTRUCTION SEQUENCE:

THE DEVELOPMENT OF THIS SITE SHALL BE CONSISTENT WITH THE FOLLOWING GENERAL SEQUENCE OF CONSTRUCTION. THE CONTRACTOR SHALL IMPLEMENT, MAINTAIN, AND OPERATE ALL TEMPORARY EROSION AND SEDIMENT CONTROL MEASURES TO EFFECTIVELY MITIGATE THE HAZARD OF ACCELERATED EROSION AND RESUSPENSION TO ACCEPTABLE LEVELS. MINOR DEVIATIONS FROM THIS SEQUENCE SHALL BE EXECUTED BY THE PROJECT'S SUPERINTENDENT AS NEEDED TO ELIMINATE ANY POTENTIAL OFFSITE SEDIMENT EVENTS THAT MAY ARISE FOR THE DURATION OF THE PROJECT. THE WV DEP OFFICE OF OIL AND GAS SHALL BE NOTIFIED OF ANY AND ALL SUCH DEVIATIONS FROM THE APPROVED PLANS.

1. A PRE-CONSTRUCTION CONFERENCE WITH THE CONTRACTOR AND THE APPROPRIATE EROSION AND SEDIMENT CONTROL INSPECTOR OR HOUSE PRIOR TO BEGINNING WORK TO REVIEW THE CONSTRUCTION DRAWINGS AND PROVIDE ANY REQUESTED GUIDANCE.
2. STAKE THE LIMITS OF CONSTRUCTION AND MARK/FLAG ALL IDENTIFIED WETLANDS, STREAMS, LIVELIHOOD, AND OTHER AREAS OF CONCERN FOR CONSTRUCTION ACTIVITIES. INSTALL SIGNS TO DESIGNATE THE AREAS AND ORANGE SAFETY FENCE TO IDENTIFY IMPORTANT PROJECT ATTRIBUTES SUCH AS APPROVED ACCESS ROADS, NO REPAIRING ZONES, WETLANDS/STREAM BOUNDS, ETC.
3. CONSTRUCT THE ROCK CONSTRUCTION ENTRANCE. ALL VEHICLES ENTERING AND EXITING THE SITE SHALL DO SO VIA THE ROCK CONSTRUCTION ENTRANCE.
4. CONSTRUCT ALL BMP'S AS SOON AS CLEARING AND GRUBBING OPERATIONS ALLOW. DITCHLINES AND SEDIMENT TRAP(S)/BASIN(S) SHALL BE SEEDED AND MULCHED IMMEDIATELY.
5. IF APPLICABLE, SURVEY TOPSOIL DRAINAGE AROUND THE ACCESS ROAD AND WELL PAD AREAS BY CONSTRUCTING ALL DIVERSION BERM(S) AND/OR COMPOST FILTER SOCK DIVERSION(S) AS SHOWN ON THE PLANS.
6. CLEAR AND GRUB THE SITE. ALL WOODY MATERIAL, BRUSH, TREES, STUMPS, LARGE ROCKS, BOULDERS, AND DEBRIS SHALL BE CLEARED FROM THE SITE AREA AND KEPT TO THE MINIMUM NECESSARY FOR PROPER CONSTRUCTION, INCLUDING THE INSTALLATION OF TEMPORARY SEDIMENT CONTROLS. TREES SIX INCHES IN DIAMETER AND LARGER SHALL BE CUT AND LOGS STACKED. SMALLER TREES, BRUSH, AND STUMPS SHALL BE CUT AND/OR GROUBBED AND WINDROWED IN APPROPRIATE AREAS FOR USE AS SEDIMENT BARRIERS AT WATER CROSSINGS OUTLETS (AS SHOWN ON THE PLANS), WINDROWED BELOW THE WELL SITE, USED FOR WILDLIFE HABITAT, OR BURNED AS PER THE FOREST FIRE LAWS, REMOVED FROM SITE, OR DISPOSED OF BY OTHER METHODS APPROVED BY WV DEP.
7. IF APPLICABLE, INSTALL ALL WETLAND OR STREAM CROSSINGS AS SHOWN ON THE PLANS.
8. STRIP THE TOPSOIL FROM THE ACCESS ROAD. PRIOR TO PLACING ANY FILL, THE EXPOSED SUBGRADE SHALL BE COMPACTED AND PROOF ROLLED TO PRODUCE A STABLE AND UNYIELDING SITE. ALL STRIPPED TOPSOIL SHALL BE STOCKPILED IN AREAS SHOWN IN THE PLANS, ON SLOPES LESS THAN 8%, AND IMMEDIATELY STABILIZED. ADDITIONAL BMP MEASURES SHALL BE CONSTRUCTED AROUND TOPSOIL STOCKPILES, IF NECESSARY.
9. CONSTRUCT THE ACCESS ROAD. ALL FILL AREAS, INCLUDING EXCESS MATERIAL STOCKPILES, SHALL BE "KEYED IN" AND COMPACTED IN HORIZONTAL LIFTS WITH A MAXIMUM LOOSE LIFT THICKNESS OF 12" AND MAXIMUM PARTICLE SIZE AS OUTLINED IN THE GEOTECHNICAL REPORT. ALL FILL SHALL BE COMPACTED BY A VIBRATING SHEEPSFOOT ROLLER TO 90% PER THE STANDARD PROCTOR TEST (ASTM-D698). MOISTURE CONTENT 94% BE CONTROLLED IN ACCORDANCE WITH THE STANDARD PROCTOR TEST (ASTM-D698) RESULTS. IT IS ALSO RECOMMENDED THAT EACH LIFT BE PROOF ROLLED WITH A LOADED HAUL TRUCK WHERE APPLICABLE. DITCH RELIEF CULVERTS SHALL BE INSTALLED AT A GRADE OF 1-5% TO MINIMIZE OUTLET VELOCITIES TO THE EXTENT POSSIBLE. INSTALL OUTLET PROTECTION ONCE DITCH RELIEF CULVERTS ARE INSTALLED, AS SHOWN ON PLANS. STABILIZE THE ROAD WITH GEOTEXTILE FABRIC & STONE AND SEED AND MULCH SLOPES AS SPECIFIED WITH PERMANENT SEEDING. ENSURE MATERIAL SHALL BE STOCKPILED (IF NECESSARY) IN AREAS SHOWN ON THE PLANS AND IMMEDIATELY STABILIZED. TOPSOIL SHALL BE STRIPPED FROM ALL STOCKPILE AREAS PRIOR TO CONSTRUCTION OF STOCKPILES. AFTER STOCKPILES ARE CONSTRUCTED, THEY SHALL BE TO BE ROUGHENED AT A DEPTH OF 4"-6". SLOPES SHALL BE TRACKED BY RUNNING TRACKED MACHINERY UP AND DOWN THE SLOPES, LEAVING TRENCH MARKS PARALLEL TO THE CONTOUR. ALL DITCH LINES SHALL BE CLEANED PRIOR TO INSTALLATION OF LINING PROTECTION.
10. STRIP THE TOPSOIL FROM THE WELL PAD. PRIOR TO PLACING ANY FILL, THE EXPOSED SUBGRADE SHALL BE COMPACTED AND PROOF ROLLED TO PRODUCE A STABLE AND UNYIELDING SITE. ALL STRIPPED TOPSOIL SHALL BE STOCKPILED IN AREAS SHOWN IN THE PLANS, ON SLOPES LESS THAN 8%, AND IMMEDIATELY STABILIZED. ADDITIONAL BMP MEASURES SHALL BE CONSTRUCTED AROUND TOPSOIL STOCKPILES, IF NECESSARY.
11. GRADE THE WELL PAD AREA AS SHOWN ON THE PLANS. INSTALL PAD SUMPS (WITH 4" PVC DRAIN PIPE AND OUTLET PROTECTION) AND CONTAINMENT BERM LINER SYSTEM. IMMEDIATELY STABILIZE THE OUTER AREAS OF THE WELL PAD. THE WELL PAD AREA SHALL BE STABILIZED WITH GEOTEXTILE FABRIC & STONE AND THE SIDE SLOPES WITH SEED AND MULCH. INSTALL ALL STRAW WATTLES AS SHOWN ON PLANS. APPLY SEED AND MULCH TO ALL DISTURBED AREAS. THIS SHALL INCLUDE ALL AREAS THAT WILL NOT BE SUBJECT TO REGULAR TRAFFIC ACTIVITY TO PROMULGATE RITE STRESS, OR ANY DISTURBED AREA THAT WILL NOT BE RE-DISTURBED BEFORE SITE RECLAMATION BEGINS.
12. COMMENCE WELL DRILLING ACTIVITY.
13. ALL BMP'S MUST REMAIN IN PLACE AND FUNCTIONAL UNTIL ALL AREAS WITHIN THE LIMIT OF DISTURBANCE ARE COMPLETE AND PERMANENTLY STABILIZED. MAINTENANCE MUST INCLUDE INSPECTION OF ALL EROSION AND SEDIMENT CONTROLS AFTER EACH RUNOFF EVENT IN EXCESS OF 0.5" AND ON A BIWEEKLY BASIS.
14. THE CONSTRUCTION SITE SHOULD BE STABILIZED AS SOON AS POSSIBLE AFTER COMPLETION. REVEGETATION OF FINAL STABILIZATION MUST BE INITIATED NO LATER THAN 7 DAYS AFTER REACHING FINAL GRADE, AND SHALL BE COMPLETED WITHIN SEVEN DAYS THAT ALL SOIL-DISTURBING ACTIVITIES ARE COMPLETED, AND THAT EITHER A PERMANENT VEGETATIVE COVER WITH A DENSITY OF 70% OR GREATER HAS BEEN ESTABLISHED OR THAT THE SURFACE HAS BEEN STABILIZED BY MEANS OTHER SUCH AS PAVEMENT OR BUILDINGS. IT SHOULD BE NOTED THAT THIS THE REQUIREMENT REFERS TO THE TOTAL AREA VEGETATED AND NOT JUST A PERCENT OF THE SITE.
15. ALL PERMANENT SEDIMENT CONTROL MEASURES CAN BE REMOVED AFTER THE SITE IS PERMANENTLY STABILIZED AND APPROVAL IS RECEIVED FROM THE WVDEP.
16. ANY AREAS DISTURBED BY REMOVAL OF CONTROLS SHALL BE REGRADED, HYDROSEED, AND PERMANENTLY SEEDED.

SITE RECLAMATION NARRATIVE:

POST CONSTRUCTION - THE CONSTRUCTION SITE SHALL BE STABILIZED AS SOON AS POSSIBLE AFTER COMPLETION. THE ESTABLISHMENT OF FINAL COVER MUST BE INITIATED NO LATER THAN 7 DAYS AFTER REACHING FINAL GRADE. THE ACCESS ROADS AND WELL PAD ARE TO BE MAINTAINED THROUGHOUT THE LIFE OF THE FACILITY. ALL CULVERTS, HARDSURFACE DITCHES, ROAD-BASED DIPS, DIVERSION DITCHES, ETC. MUST BE MAINTAINED TO PROVIDE WORKING ORDER. ANY SOIL THAT IS DISTURBED ALONG THE ACCESS ROAD OR WELL PAD MUST BE REVEGETATED ACCORDING TO THESE PLANS AND THE WVDEP OFFICE OF OIL AND GAS FIELD MANUAL. IF NECESSARY, ALL TEMPORARY BMP MEASURES CAN BE REMOVED AFTER THE SITE IS PERMANENTLY STABILIZED AND APPROVAL IS RECEIVED FROM THE WVDEP. ANY AREAS DISTURBED BY REMOVAL OF THE BMP'S SHALL BE REGRADED, STABILIZED, AND PERMANENTLY SEEDED.

NOTES:

1. DURING SITE RECLAMATION ALL FILL AREAS SHALL BE COMPACTED IN 12" MAXIMUM LIFT THICKNESS WITH A VIBRATING SHEEPSFOOT ROLLER TO 90% COMPACTION PER STANDARD PROCTOR DENSITY, ASTM D-698. MOISTURE CONTENT WILL BE CONTROLLED IN ACCORDANCE WITH THE STANDARD PROCTOR TEST (ASTM-D698) RESULTS.

CONSTRUCTION STANDARDS:

THE EROSION, CONSTRUCTION, AND REMOVAL OF FILL FOR CH, AND G&G SITES MUST BE ACCOMPLISHED IN SUCH A MANNER AS TO PROTECT THE HEALTH AND SAFETY OF THE PEOPLE, THE NATURAL RESOURCES, AND ENVIRONMENT OF THE STATE. THE SITE SHALL BE DESIGNED, CONSTRUCTED, AND MAINTAINED TO BE STRUCTURALLY SOUND AND REASONABLY PROTECTED FROM UNAUTHORIZED ACTS OF THIRD PARTIES.

1. ALL FILL AREAS SHOULD BE CLEARED OF TREES, STUMPS, AND ANY VEGETATION AND STRIPPED OF TOPSOIL/ORGANIC SOILS PRIOR TO THE START OF FILL PLACEMENT.
2. ANY GROUNDWATER ENCOUNTERED DURING CONSTRUCTION SHALL BE DIVERTED TO THE OUTSIDE/DOWNSTREAM TOE OF THE SLOPE. CONNECTED DRAIN ROCK SECTION SHALL BE AN EXCAVATED 8' x 8' TRENCH AND BACK FILLED WITH CHY STONE, COMPACTED BY HAND TAMPER. GEOMEMBRANE FABRIC SHALL BE USED TO LINE TRENCH.
3. SATISFACTORY MATERIALS FOR USE AS FILL FOR PAD AREAS INCLUDE MATERIALS CLASSIFIED IN ASTM D-2487 AS CH, CL, GM, GC, SW, SP, SM, SC, ML, AND CL GROUPS.
4. GENERALLY, UNSATISFACTORY MATERIALS INCLUDE MATERIALS CLASSIFIED IN ASTM D-2487 AS PT, OH, MH, OL. OH, AND ANY SOIL TOO WET TO FACILITATE COMPACTION. CH AND MH SOILS MAY BE USED SUBJECT TO APPROVAL OF THE ENGINEER.
5. ALL FILL AREAS SHALL BE "KEYED IN" AND COMPACTED IN HORIZONTAL LIFTS WITH A MAXIMUM LOOSE LIFT THICKNESS OF 24" AND MAXIMUM PARTICLE SIZE AS OUTLINED IN THE GEOTECHNICAL REPORT. ALL FILL SHALL BE COMPACTED BY A VIBRATING SHEEPSFOOT ROLLER TO 90% PER THE STANDARD PROCTOR TEST (ASTM-D698). MOISTURE CONTENT WILL BE CONTROLLED IN ACCORDANCE WITH THE STANDARD PROCTOR TEST (ASTM-D698) RESULTS.
6. ROCK LIFTS ARE NOT PREFERRED FOR THE CONSTRUCTION OF THIS SITE. HOWEVER, LARGER ROCK PARTICLES OR BOULDERS THAT ARE ENCOUNTERED DURING CONSTRUCTION NEED TO BE BROKEN DOWN TO A MANAGEABLE SIZE (MAXIMUM 8"x8"x1" THICK) TO BE PLACED AS FILL DURING PLACEMENT OF FILL CONTAINING LARGE SIZE ROCK PARTICLES. IT IS ESSENTIAL THAT NO VOID SPACES BE LEFT BETWEEN ROCK FRAGMENTS. SMALLER ROCK FRAGMENTS AND SOIL MUST BE WORKED INTO ANY OPENINGS BETWEEN THE BOULDERS AFTER THEY ARE PUT IN PLACE. ADDITIONAL GUIDANCE REGARDING ENCOUNTERED ROCK CAN BE FOUND IN THE GEOTECHNICAL REPORT.
7. THE PLACEMENT OF ALL FILL MATERIAL SHALL BE FREE OF WOOD, STUMPS AND ROOTS, LARGE ROCKS AND BOULDERS, AND ANY OTHER NONCOMPACTABLE SOIL MATERIAL. NO FILL SHALL CONTAIN OR BE PLACED ON FROZEN MATERIAL. THE FILL SHALL BE COMPACTED TO A MINIMUM OF VARIOUS NON-NOVEMBER. However, THE COMPACTION EFFORT SHALL NOT EXCEED THE OPTIMUM MOISTURE LIMITS.
8. ALL EXPOSED AREAS, NOT COVERED BY COMPACTED GRAVEL, OR RIP-RAP SHALL BE LIMED, FERTILIZED, SEEDED AND MULCHED. PERMANENT VEGETATIVE (GROUND COVER AND OTHER) WITH THE WV DEP EROSION AND SEDIMENT CONTROL FIELD MANUAL MUST BE ESTABLISHED UPON THE COMPLETION OF CONSTRUCTION. SLOPES SHALL BE TEMPERED WITH A CHARRY VEGETATIVE COVER AND FREE OF BRUSH AND/OR TREES.
9. IF STANDING WATER IS PRESENT ON SITE, CONTRACTOR TO CORRECT DRAINAGE ISSUE BY DIRECTING WATER TO PROPER BMP CONTROLS OR OUTLET WITH POSITIVE DRAINAGE IF NECESSARY. CONTACT ENGINEER FOR GUIDANCE IN CORRECTING DRAINAGE ISSUE.
10. ALL DRAINAGE DITCHES, DIVERSIONS, AND CULVERTS SHALL HAVE POSITIVE DRAINAGE AND OUTFALL INTO THE PROPER OUTLET PROTECTION OR LEVEL SPREADING DEVICE. SUPER SILT FENCE, O

4709502450P

LEGEND

LEGEND

LEMUEL

WELL PAD & WATER CONTAINMENT PAD

CENTERVILLE & MEADE DISTRICTS
TYLER COUNTY, WEST VIRGINIA

DATE	REVISION

NAVITUS ENERGY ENGINEERING

DATE: 06/24/2008
SCALE: N/A
SHEET 8 OF 8

10/30/2026

4709502450 4709502450P

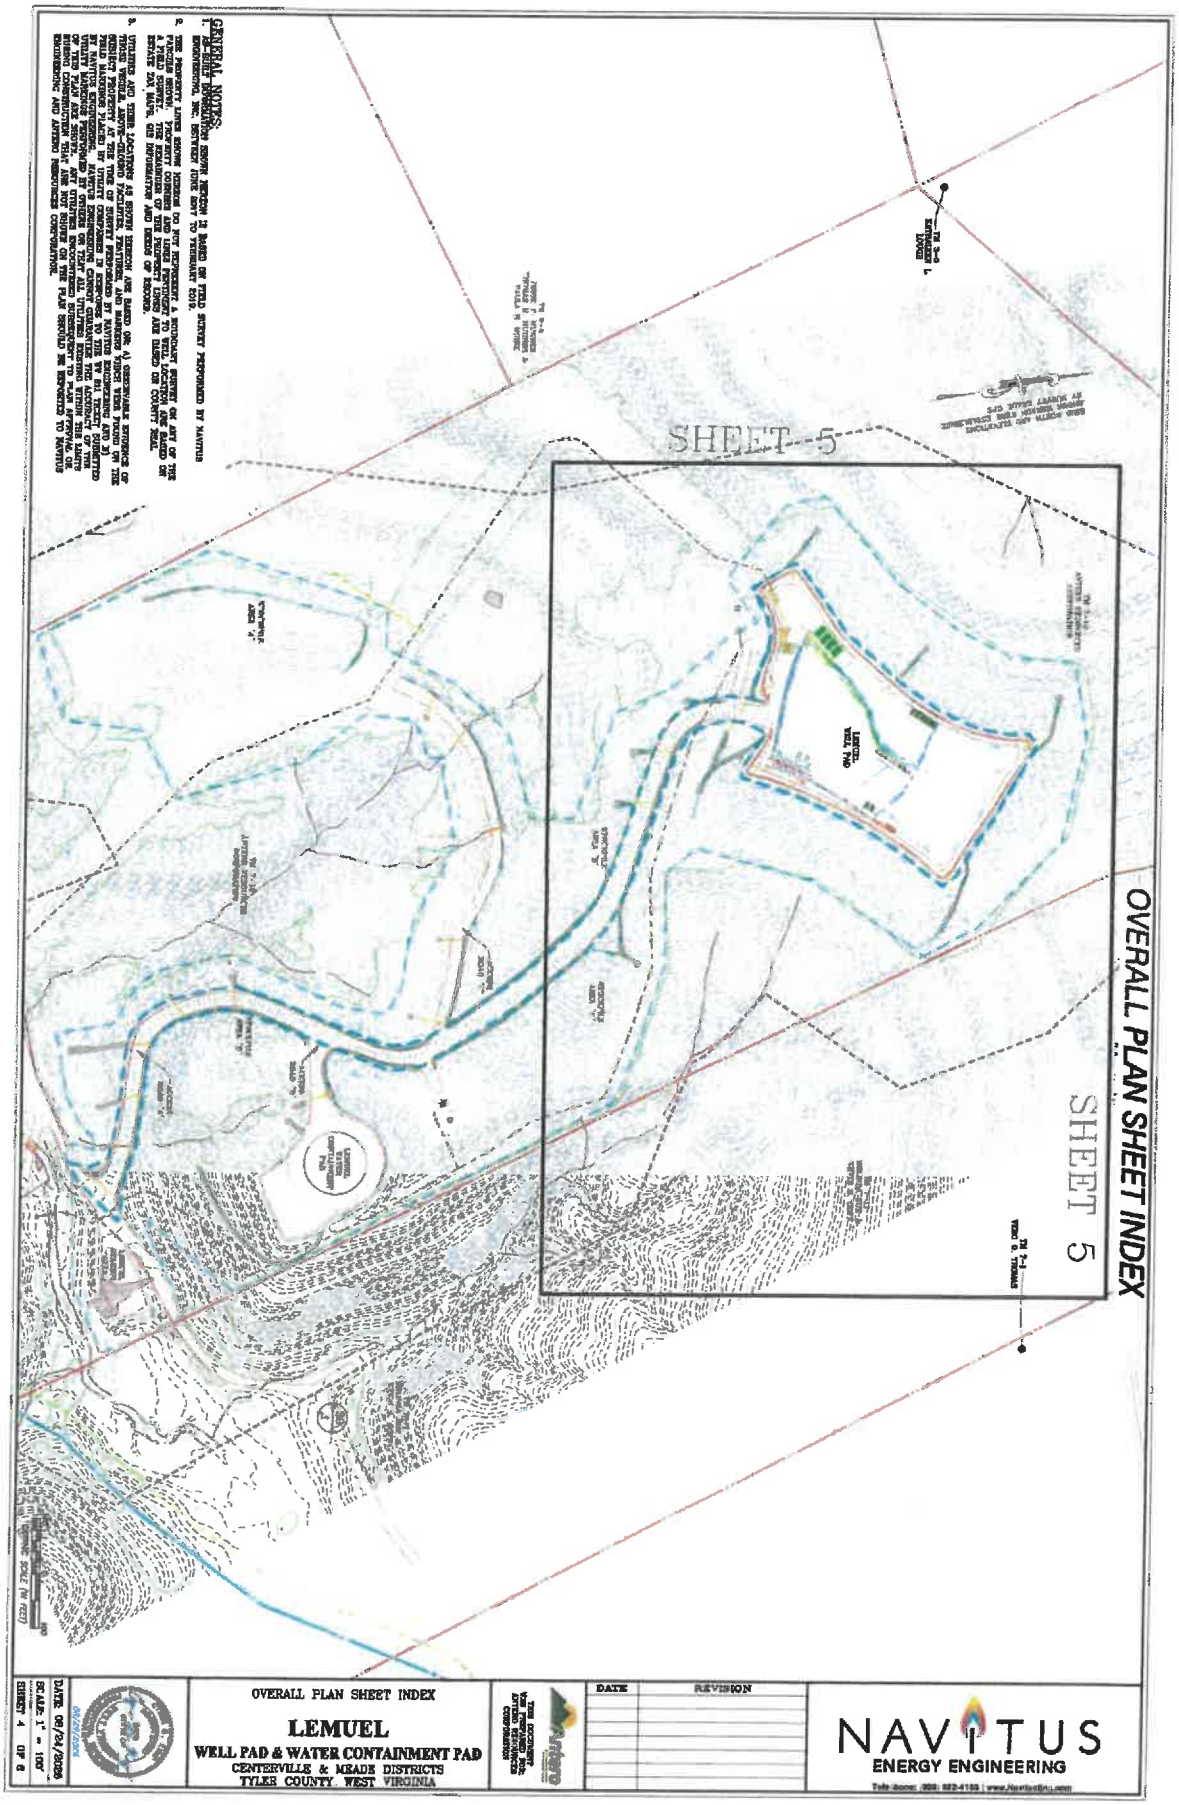

10/30/2026

4709502450P

10/30/2026

ROCK CONSTRUCTION ENTRANCE

N.T.S.

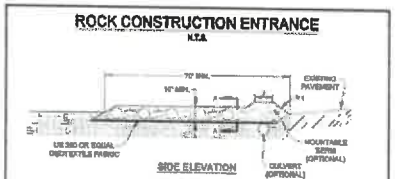

SIDE ELEVATION

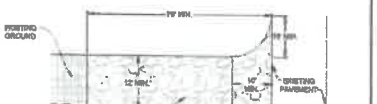

*MUST SPREAD FULL WIDTH OF INGRESS/EGRESS OPERATION

PLAN VIEW

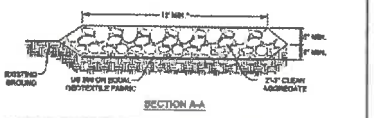

SECTION A-A

COMPOST FILTER SOCK

N.T.S.



SECTION VIEW

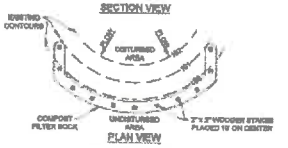

PLAN VIEW

ADAPTED FROM FILTREXX

SOCK FABRIC SHALL MEET STANDARDS OF TABLE 4.1 COMPOST SHALL MEET THE FOLLOWING STANDARDS:

ORGANIC MATTER CONTENT	80%-100% (DRY WEIGHT BASIS)
ORGANIC PORTION	FIBROUS AND ELONGATED
pH	6.0-8.0
MOISTURE CONTENT	30%-60%
PARTICLE SIZE	99% PASS THROUGH 1" SCREEN
SOLUBLE SALT CONCENTRATION	5.0 dS MAXIMUM

NOTES:
1. COMPOST FILTER SOCK SHALL BE PLACED AT EXISTING LEVEL GRADE, BOTH SIDES OF THE SOCK SHALL BE EXTENDED AT LEAST 8' UP THE SLOPE OR TO A HEIGHT EQUAL TO THE EFFECTIVE SOCK HEIGHT, WHICHEVER IS GREATER, AT 40' TO 70' MAX SOCK ALIGNMENT, MAXIMUM SLOPE LENGTH ABOVE ANY SOCK SHALL NOT EXCEED MANUFACTURER'S MAXIMUM PERMISSIBLE SLOPE LENGTH.
2. TRAFFIC SHALL NOT BE PERMITTED TO CROSS FILTER SOCKS.
3. ACCUMULATED SEDIMENT SHALL BE REMOVED WHEN IT REACHES 1/2 THE ABOVE GROUND HEIGHT OF THE SOCK AND DISPOSED IN THE MANNER DESCRIBED SUBSEQUENTLY IN THIS PLAN.
4. SOCKS SHALL BE INSPECTED HOURLY AND AFTER EACH RUNOFF EVENT. DAMAGED SOCKS SHALL BE REPAIRED ACCORDING TO MANUFACTURER'S SPECIFICATIONS OR REPLACED WITHIN 24 HOURS OF INSPECTION.
5. BIODEGRADABLE FILTER SOCKS SHALL BE REPLACED AFTER 6 MONTHS; PHOTODEGRADABLE SOCKS AFTER 1 YEAR. POLYPROPYLENE SOCKS SHALL BE REPLACED ACCORDING TO MANUFACTURER'S RECOMMENDATIONS.
6. UPON STABILIZATION OF THE AREA TRIBUTARY TO THE SOCK, STAKES SHALL BE REMOVED. THE SOCK MAY BE LEFT IN PLACE AND VEGETATED OR REMOVED. IN THE LATTER CASE, THE MESH SHALL BE CUT OPEN AND THE MULCH SPREAD AS A SOIL SUPPLEMENT.
7. IN THE EVENT THE GROUND IS FROZEN, IN REGAN WITH SAFETY CAPS SHALL BE USED INSTEAD OF WOODEN STAKES TO ANCHOR THE FILTER SOCK. ONCE THE GROUND THAWS, THE REBAR ANCHORS SHALL BE REMOVED AND REPLACED WITH 2" x 2" WOODEN STAKES AND INSTALLED AS SHOWN IN THE DETAIL ABOVE.

REVEGETATION

TAKEN FROM THE
WEST VIRGINIA EROSION AND SEDIMENT CONTROL FIELD MANUAL
WEST VIRGINIA DIVISION OF ENVIRONMENTAL PROTECTION OFFICE OF OIL AND GAS
CHARLESTON, WVA.
SECTION IV

TEMPORARY SEEDING

a. GENERAL CONDITIONS WHERE PRACTICE APPLIES
WHERE EXPOSED SOIL SURFACES ARE NOT TO BE FINE-GRADED OR WORKED FOR PERIODS LONGER THAN 21 DAYS, TEMPORARY VEGETATIVE COVER WITH SEDIMENT CONTROLS MUST BE ESTABLISHED WHERE RUNOFF WILL GO DIRECTLY INTO A STREAM, IMMEDIATELY UPON CONSTRUCTION OF THE SITE OF A HAUL ROAD AND LOCATION, VEGETATION MUST BE ESTABLISHED ON ROAD BANK AND LOCATION SLOPES. A PERMANENT VEGETATIVE COVER SHALL BE APPLIED TO AREAS THAT WILL BE LEFT UNWORKED FOR A PERIOD OF MORE THAN SIX MONTHS.

b. SEED MIXTURES AND PLANTING DATES
REFER TO TABLES M-2 THROUGH M-4 FOR RECOMMENDED DATES TO ESTABLISH VEGETATIVE COVER AND THE APPROVED LISTS OF TEMPORARY AND PERMANENT PLANT SPECIES AND PLANTING RATES. TABLE M-3 GIVES RECOMMENDED TYPES OF TEMPORARY VEGETATION, RATES OF APPLICATION, AND OPTIMUM SEEDING DATES. IN SITUATIONS WHERE ANOTHER COVER IS DESIRED, CONTACT THE LOCAL SOIL CONSERVATION DISTRICT FOR SEEDING RECOMMENDATIONS.

c. SEED APPLICATION
APPLY SEED BY BROADCASTING, DRILLING, OR BY HYDROSEED ACCORDING TO THE RATES INDICATED IN TABLE M-5. PERFORM ALL PLANTING OPERATIONS AT RIGHT ANGLES TO THE SLOPE. NECESSARY SITE PREPARATION AND ROUGHENING OF THE SOIL SURFACE SHOULD BE DONE JUST PRIOR TO SEEDING. SEEDBED PREPARATION MAY NOT BE REQUIRED ON NEWLY DISTURBED AREAS.

PERMANENT SEEDING

a. GENERAL
PERMANENT VEGETATIVE COVER WILL BE ESTABLISHED WHERE NO FURTHER SOIL DISTURBANCE IS ANTICIPATED OR NEEDED. SOIL FERTILITY AND PH LEVEL SHOULD BE TESTED AND ADJUSTED ACCORDING TO SPECIES PLANTED. PLANTING OF PERMANENT VEGETATIVE COVERS MAY BE PERFORMED ON ALL DISTURBED AREAS AFTER COMPLETION OF THE DRILLING PROCESS. ANY SITE THAT CONTAINS SIGNIFICANT AMOUNTS OF ROCKY GRADING AND REQUIRED PREPARATION, THE VEGETATION WILL ESTABLISH GROUND COVER FOR THE CONTROL OF SURFACE WATER RUNOFF EROSION.
ALL REQUIRED SEEDBED PREPARATION AND LOOSENING OF SOIL BY DISKING OR DOZER TRACKING SHOULD BE PERFORMED JUST PRIOR TO SEEDING. IF SEEDBED PREPARATION IS NOT FEASIBLE, 50% MORE SEED SHALL BE ADDED TO THE RECOMMENDED RATES SHOWN IN TABLES M-3 AND M-4.
WHEN HYDROSEEDING, SEEDBED PREPARATION MAY NOT BE NECESSARY IF ADEQUATE SITE PREPARATION WAS PERFORMED. INCORPORATE THE APPROPRIATE AMOUNT OF LIME AND/OR FERTILIZER IN THE SLURRY MIX WHEN HYDROSEEDING.
WHEN HYDROSEEDING, FIRST MIX THE LIME, FERTILIZER, AND HYDRO-MULCH IN THE RECOMMENDED AMOUNT OF WATER. MIX THE SEED AND INOCULANTS TOGETHER WITHIN ONE HOUR PRIOR TO PLANTING, AND ADD TO THE SLURRY JUST BEFORE SEEDING. APPLY THE SLURRY UNIFORMLY OVER THE PREPARED SITE. ENSURE THAT AGITATION IS CONSTANT THROUGHOUT THE SEEDING OPERATION AND THE MIX IS APPLIED WITHIN ONE HOUR OF INITIAL MIXING.

b. LIME AND FERTILIZER
1. LIME SHALL BE APPLIED TO ALL PERMANENT SEEDINGS. THE PH OF THE SOIL IS TO BE DETERMINED AND LIME APPLIED ACCORDINGLY. ONCE THE PH IS KNOWN, SELECT THE AMOUNT OF LIME TO BE APPLIED FROM TABLE M-6.
2. FERTILIZER IN SHALL BE APPLIED IN ALL PERMANENT SEEDINGS. APPLY THE EQUIVALENT OF 500 LBS. MINIMUM 10-20-20 FERTILIZER PER ACRE OR USE THE AMOUNT OF FERTILIZER AND LIME RECOMMENDED BY A CERTIFIED SOIL TEST.
3. APPLICATION: FOR BEST RESULTS AND MAXIMUM BENEFITS, THE LIME AND FERTILIZER ARE TO BE APPLIED AT THE TIME OF SEEDBED PREPARATION.

c. PERMANENT SEED MIXTURES
PLANNERS SHOULD TAKE INTO CONSIDERATION THE SPECIES MAKEUP OF THE EXISTING PASTURE AND THE LANDOWNER'S FUTURE PASTURE MANAGEMENT PLANS WHEN RECOMMENDING SEED MIXTURES. SELECTION FROM TABLES M-4A AND M-4B, PERMANENT SEEDING MIXTURES SUITABLE FOR ESTABLISHMENT IN WEST VIRGINIA.
NOTES:
1. ALL LEGUMES MUST BE PLANTED WITH THE PROPER INOCULANTS PRIOR TO SEEDING.
2. "LATHCY" FLATPEA IS POTENTIALLY POISONOUS TO SOME LIVESTOCK.
3. ONLY ENDOPHYTE FREE VARIETIES OF TALL FESCUE SHOULD BE USED. TALL FESCUE AND CROWNVETCH ARE ALSO VERY INVASIVE SPECIES, NON-NATIVE TO PA.
4. FOR UNPREPARED SEEDBEDS OR SEEDING OUTSIDE THE OPTIMUM TIMEFRAMES, ADD 50% MORE SEED TO THE SPECIFIED RATE. MIXTURES IN TABLE M-4B ARE MORE WILDLIFE AND FARM FRIENDLY, THOSE LISTED IN BOLD ARE SUITABLE FOR USE IN MINED WOODLAND SETTINGS. MIXTURES IN ITALICS ARE SUITABLE FOR USE IN FILTER STRIPS.

d. SEEDING FOR WILDLIFE HABITAT
CONSIDER THE USE OF THE NATIVE PLANTS OR LOCALLY ADAPTED PLANTS WHEN SELECTING COVER TYPES AND SPECIES FOR WILDLIFE HABITAT. WILDLIFE FRIENDLY SPECIES OR MIXES THAT HAVE MULTIPLE VALUES SHOULD BE CONSIDERED. SEE WILDLIFE FRIENDLY SPECIES/MIXTURES IN TABLE M-4B. CONSIDER SELECTING NO OR LOW MAINTENANCE LONG-LIVED PLANTS ADAPTABLE TO SITES WHICH MAY BE DIFFICULT TO MAINTAIN WITH EQUIPMENT.

MULCHING

a. GENERAL ORGANIC MULCHES
THE APPLICATION OF STRAW, HAY, OR OTHER ORGANIC MATERIAL TO THE SOIL SURFACE TO PREVENT EROSION. STRAW MADE FROM WHEAT OR OATS IS THE PREFERRED MULCH. THE USE OF HAY IS PERMISSIBLE, BUT NOT SHOULD NEED GIVE TO THE RISK OF SPREADING UNWANTED SPECIES. MULCH MUST BE APPLIED TO ALL TEMPORARY AND PERMANENT SEEDING OR ALL DISTURBED AREAS, DEPENDING ON SITE CONDITIONS, IN CRITICAL AREAS SUCH AS WATERWAYS OR STEEP SLOPES, ADDITIONAL OR SUBSTITUTE SOIL PROTECTIVE MEASURES MAY BE USED IF DEEMED NECESSARY. EXAMPLES INCLUDE JUTE MESH AND/OR STABILIZATION BLANKETS OR EROSION CONTROL MATTING.
AREAS THAT HAVE BEEN TEMPORARILY OR PERMANENTLY SEEDED SHOULD BE MULCHED IMMEDIATELY FOLLOWING SEEDING. MULCHES CONSERVE DESIRABLE SOIL PROPERTIES, REDUCE SOIL MOISTURE LOSS, PREVENT CRUSTING AND SEALING OF THE SOIL SURFACE, AND PROVIDE A SUITABLE MICROCLIMATE FOR SEED GERMINATION.
AREAS THAT CANNOT BE SEEDED BEFORE ONE OF THE SEASON SHOULD BE MULCHED TO PROVIDE SOME PROTECTION TO THE SOIL SURFACE. AN ORGANIC MULCH, STRAW, OR HAY SHOULD BE USED AND THE AREA THEN SEEDED AS SOON AS WEATHER OR SEASONAL CONDITIONS PERMIT. DO NOT USE FIBER MULCH (CELLULOSE-HYDROMIXED ALONE FOR THE PRACTICE AT NORMAL APPLICATION RATES IT WILL NOT GIVE THE SOIL PROTECTION OF OTHER TYPES OF MULCH.
WOOD CELLULOSE FIBER MULCH IS USED IN HYDROSEEDING OPERATIONS AND APPLIED AS PART OF THE SLURRY. IT CREATES THE BEST SEED-SOIL CONTACT WHEN APPLIED OVER THE TOP OF (AS A SEPARATE OPERATION) NEWLY SEEDED AREAS. FIBER MULCH DOES NOT ALONE PROVIDE SUFFICIENT PROTECTION OR PROPER SOIL, OR DURING LESS THAN FAVORABLE GROWING CONDITIONS. FIBER MULCH SHOULD NOT BE USED ALONE DURING THE DRY SUMMER MONTHS OR WHEN USED FOR LATE FALL MULCH COVER. USE STRAW MULCH DURING THESE PERIODS AND FIBER MULCH MAY BE USED TO TACK (ANCHOR) THE STRAW MULCH. FIBER MULCH IS WELL SUITED FOR STEEP SLOPES, CRITICAL AREAS, AND AREAS SUSCEPTIBLE TO WIND.

b. CHEMICAL MULCHES, SOIL BINDERS, AND TACKIFIERS
A WIDE RANGE OF SYNTHETIC SPRAY ON MATERIALS ARE MARKETED TO STABILIZE AND PROTECT THE SOIL SURFACE. THESE ARE MIXED WITH WATER AND SPRAYED OVER THE MULCH AND TO THE SOIL. THEY MAY BE USED ALONE IN SOME CASES AS TEMPORARY STABILIZERS, OR IN CONJUNCTION WITH FIBER MULCH, STRAW, OR HAY.
WHEN USED ALONE, MOST CHEMICAL MULCHES DO NOT HAVE THE CAPABILITY TO INSULATE THE SOIL OR RETAIN SOIL MOISTURE THAT ORGANIC MULCHES HAVE.

c. SPECIFICATIONS
FROM TABLE M-8 SELECT THE TYPE OF MULCH AND RATE OF APPLICATION THAT WILL BEST SUIT THE CONDITIONS AT THE SITE.

d. ANCHORING
DEPENDING ON THE YIELD SITUATION, MULCH MAY NOT STAY IN PLACE BECAUSE OF WIND ACTION OR RAPID WATER RUNOFF. IN SUCH CASES, MULCH IS TO BE ANCHORED MECHANICALLY OR WITH MULCH NETTING.
1. MECHANICAL ANCHORING
APPLY MULCH AND PULL MULCH ANCHORING TOOL OVER THE MULCH. WHEN A DISK IS USED, SET THE DISK STRAIGHT AND PULL ACROSS SLOPE. MULCH MATERIAL SHOULD BE TUCKED INTO THE SOIL ABOUT 3".
2. MULCH NETTING
FOLLOW MANUFACTURER'S RECOMMENDATION WHEN POSITIONING AND STAPLING THE MULCH NETTING IN THE SOIL.

ANTERO'S PREFERRED SEED MIXTURE

Common Name	Type Seed	Rate	Origin
Kentucky Bluegrass	25-35%	30%	OR
Orchard Timothy	24-30%	30%	CAN
Annual Ryegrass *	24-30%	15%	OR
Medium Red Clover *	5-9%	20%	OR
Perennial Ryegrass	5-10%	10%	OR
Other Crop Seeds:	0-5%		*Variety Not Stated
Inert Matter:	0-10%		
Weed Seeds:	0-0%		ANTC 0.0%

Table M-1
Recommended Seeding Dates

March 1 - April 15 and August 1 - October 1	Best Seeding Periods
April 15 - August 1	HIGH RISK - moisture stress likely
October 1 - December 1	HIGH RISK - freeze damage to young seedlings
December 1 - March 1	Dormant seeding period (harvest period)

Table M-2
Adequate Fertilization Recommendations

Cool Season Grass	40	80	40-60-40
Tall Grass & Legume	40	80	120 lbs. 10-20-20
Reclaiming Land	40	40	120 lbs. 10-20-20

Table M-3
Temporary Seeding

Species	Rate (lbs/acre)	Seeding Dates	Comments
Annual Ryegrass	40	3/15 - 5/15 or 8/15 - 9/30	Well - Poorly
Field Bromegrass	40	3/15 - 5/15 or 8/15 - 9/30	Well - Mod. Well
Spring Oats	86	3/1 - 6/15	Well - Poorly
Sudangrass	40	5/30 - 9/15	Well - Poorly
Winter Rye	168	9/30 - 12/15	Well - Poorly
Winter Wheat	150	9/30 - 12/15	Well - Mod. Well
Japanese Millet	30	6/15 - 8/15	Wet
Redtop	5	3/1 - 6/15	Wet
Annual Ryegrass	30	3/1 - 6/15	Well - Poorly
Spring Oats	67	3/1 - 6/15	Well - Poorly

NOTE: These rates should be increased by 50% if planted April 15 - August 1 and October 1 - March 1.

Table M-4A
Permanent Seeding Mixtures

Species/Mixture	Seeding Rate (lbs/acre)	Soil Drainage preference	pH Range
Crownvetch /	10 - 15	Well - Mod. Well	5.0 - 7.5
Tall Fescue	30		
Crownvetch /	10 - 15	Well - Mod. Well	5.0 - 7.5
Perennial Ryegrass	20		
Redtop or Perennial rye /	20	Well - Mod. Well	4.5 - 8.2
Tall Fescue	30		
Ladino Clover /	20		
Sericea Lespedeza /	25	Well - Mod. Well	4.5 - 7.5
Tall Fescue	2		
Tall Fescue /	40	Well - Mod. Well	5.0 - 7.5
Ladino Clover /	5		
Redtop	5		
Crownvetch /	10	Well - Mod. Well	5.0 - 7.5
Tall Fescue /	30		
Redtop	5		
Tall Fescue /	40	Well - Mod. Wet	5.0 - 7.5
Birdsfoot Trefoil /	10		
Redtop	5		
Sericea Lespedeza /	25	Well - Mod. Well	4.5 - 7.5
Tall Fescue /	30		
Redtop	5		
Redtop /	20	Well - Mod. Well	5.0 - 7.5
Tall Fescue	3		
Crownvetch /	20	Well - Poorly	4.5 - 7.5
Tall Fescue	30		
Perennial Ryegrass /	30		
Tall Fescue	30	Well - Poorly	5.0 - 8.5
Ladino Redtop *	30		

* "Ladino" Redtop is potentially poisonous to some livestock. All legumes should be planted with proper inoculants prior to seeding. For unprepared seedbeds or seeding outside the optimum timeframe, add 50% more seed to the specified rate.
Mixtures listed in bold are suitable for use in created woodland settings; those in italics are suitable for use in filter strips.

Table M-4B
Wildlife and Farm Friendly Seed Mixtures

Species/Mixture	Seeding Rate (lbs/acre)	Soil Drainage preference	pH Range
KY Bluegrass /	20	Well - Mod. Well	5.5 - 7.5
Redtop /	5		
Ladino Clover or Birdsfoot Trefoil	2 / 10		
Timothy /	5	Well - Mod. Well	5.5 - 8.0
Alfalfa	12		
Timothy /	5	Well - Poorly	5.5 - 7.5
Birdsfoot Trefoil	5		
Orchardgrass /	20	Well - Mod. Well	5.5 - 7.5
Ladino Clover /	2		
Redtop	5		
Orchardgrass /	20	Well - Mod. Well	5.5 - 7.5
Ladino Clover	2		
Orchardgrass /	20	Well - Mod. Well	5.5 - 7.5
Perennial Ryegrass	10		
Creeping Red Fescue /	30	Well - Mod. Well	5.5 - 7.5
Perennial Ryegrass	10		
Orchardgrass or KY Bluegrass	20	Well - Mod. Well	5.5 - 7.5
Birdsfoot Trefoil /	10		
Redtop /	5	Well - Mod. Well	5.5 - 7.5
Orchardgrass	20		
Ladino Redtop */	30	Well - Mod. Well	5.5 - 7.5
Perennial Ryegrass	30		
Ladino Redtop */	30	Well - Mod. Well	5.5 - 7.5
Orchardgrass	30		

* "Ladino" Redtop is potentially poisonous to some livestock. All legumes should be planted with proper inoculants prior to seeding. For unprepared seedbeds or seeding outside the optimum timeframe, add 50% more seed to the specified rate.
Mixtures listed in bold are suitable for use in created woodland settings; those in italics are suitable for use in filter strips.

Table M-5
Lime and Fertilizer Application Table

Lime Required (tons per acre)	Fertilizer Required (lbs per acre 10-20-20 or Equivalent)
Above 6.0	0
5.0 to 6.0	300
Below 5.0	600

The above recommendations are based on the results of soil tests made by the Pennsylvania State University Agricultural Laboratory. Where a type of fertilizer other than 10-20-20 is used, adjustments in the amounts should be made to allow for differences in the percentages of plant nutrients. Lime and fertilizer should be thoroughly incorporated into the soil by disking, harrowing or other suitable means.

Table M-6
Mulch Materials Rates and Uses

Material	Quality Standards	Rate per Acre	Remarks
Hay or Straw	Air-dry, free of noxious weeds, preferably grass hay or straw. Straw should be free of grain.	2 to 3 Tons	Subject to wind blowing or washing unless held down by hydromulching
Wood Fiber Pulp Fiber Wood - Cellulose Recirculated Paper	100 lbs 50 Gallons Contains fertilizer	Cover 1000 sq. ft. of bottom Diluted in Area	

NAVITUS
ENERGY ENGINEERING
Telephone: (888) 675-4195 | www.NavitusEnergy.com

DATE	REVISION

THIS DOCUMENT WAS PREPARED FOR: ANTERO RESOURCES CORPORATION

CONSTRUCTION DETAILS
LEMUEL
WELL PAD & WATER CONTAINMENT PAD
CENTERVILLE & MEADE DISTRICTS
TYLER COUNTY, WEST VIRGINIA

07/24/2026

DATE: 06/24/2026
SCALE: N/A
SHEET 6 OF 6

RECEIVED
Office Of Oil and Gas
OCT 13 2026
WV Department of
Environmental Protection

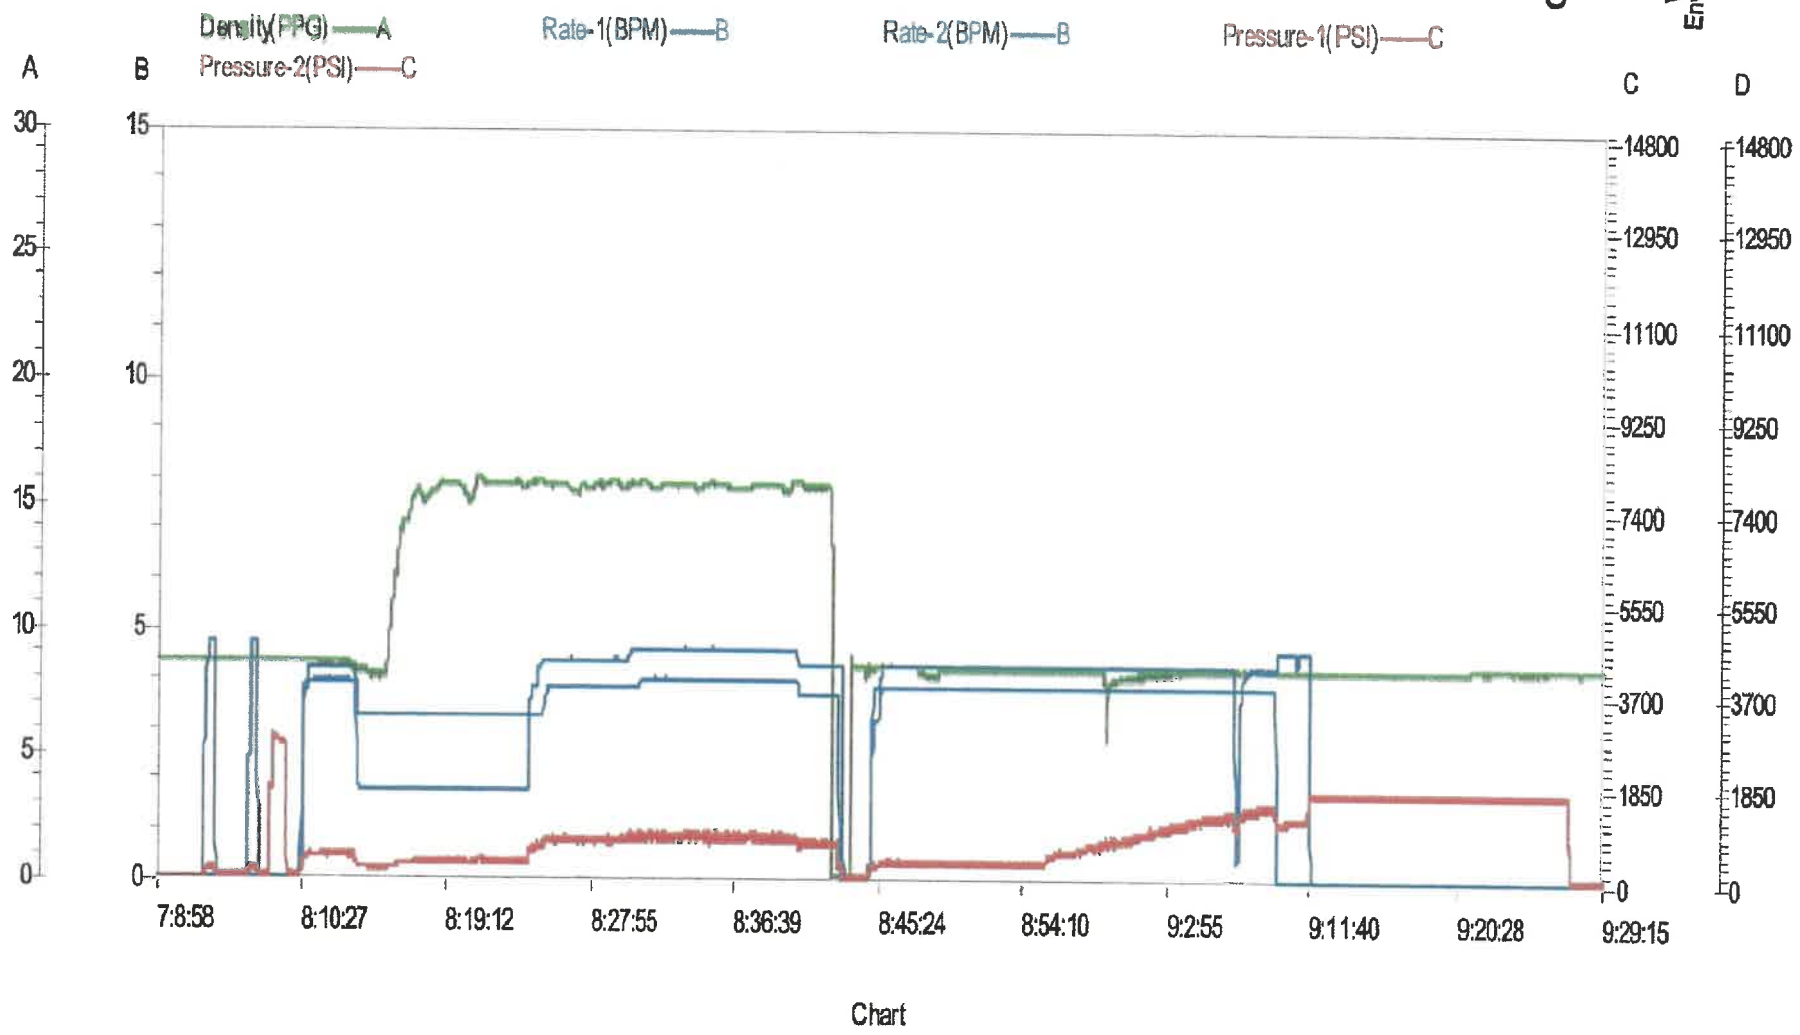

10/30/2026

47095024500P

4709502450P

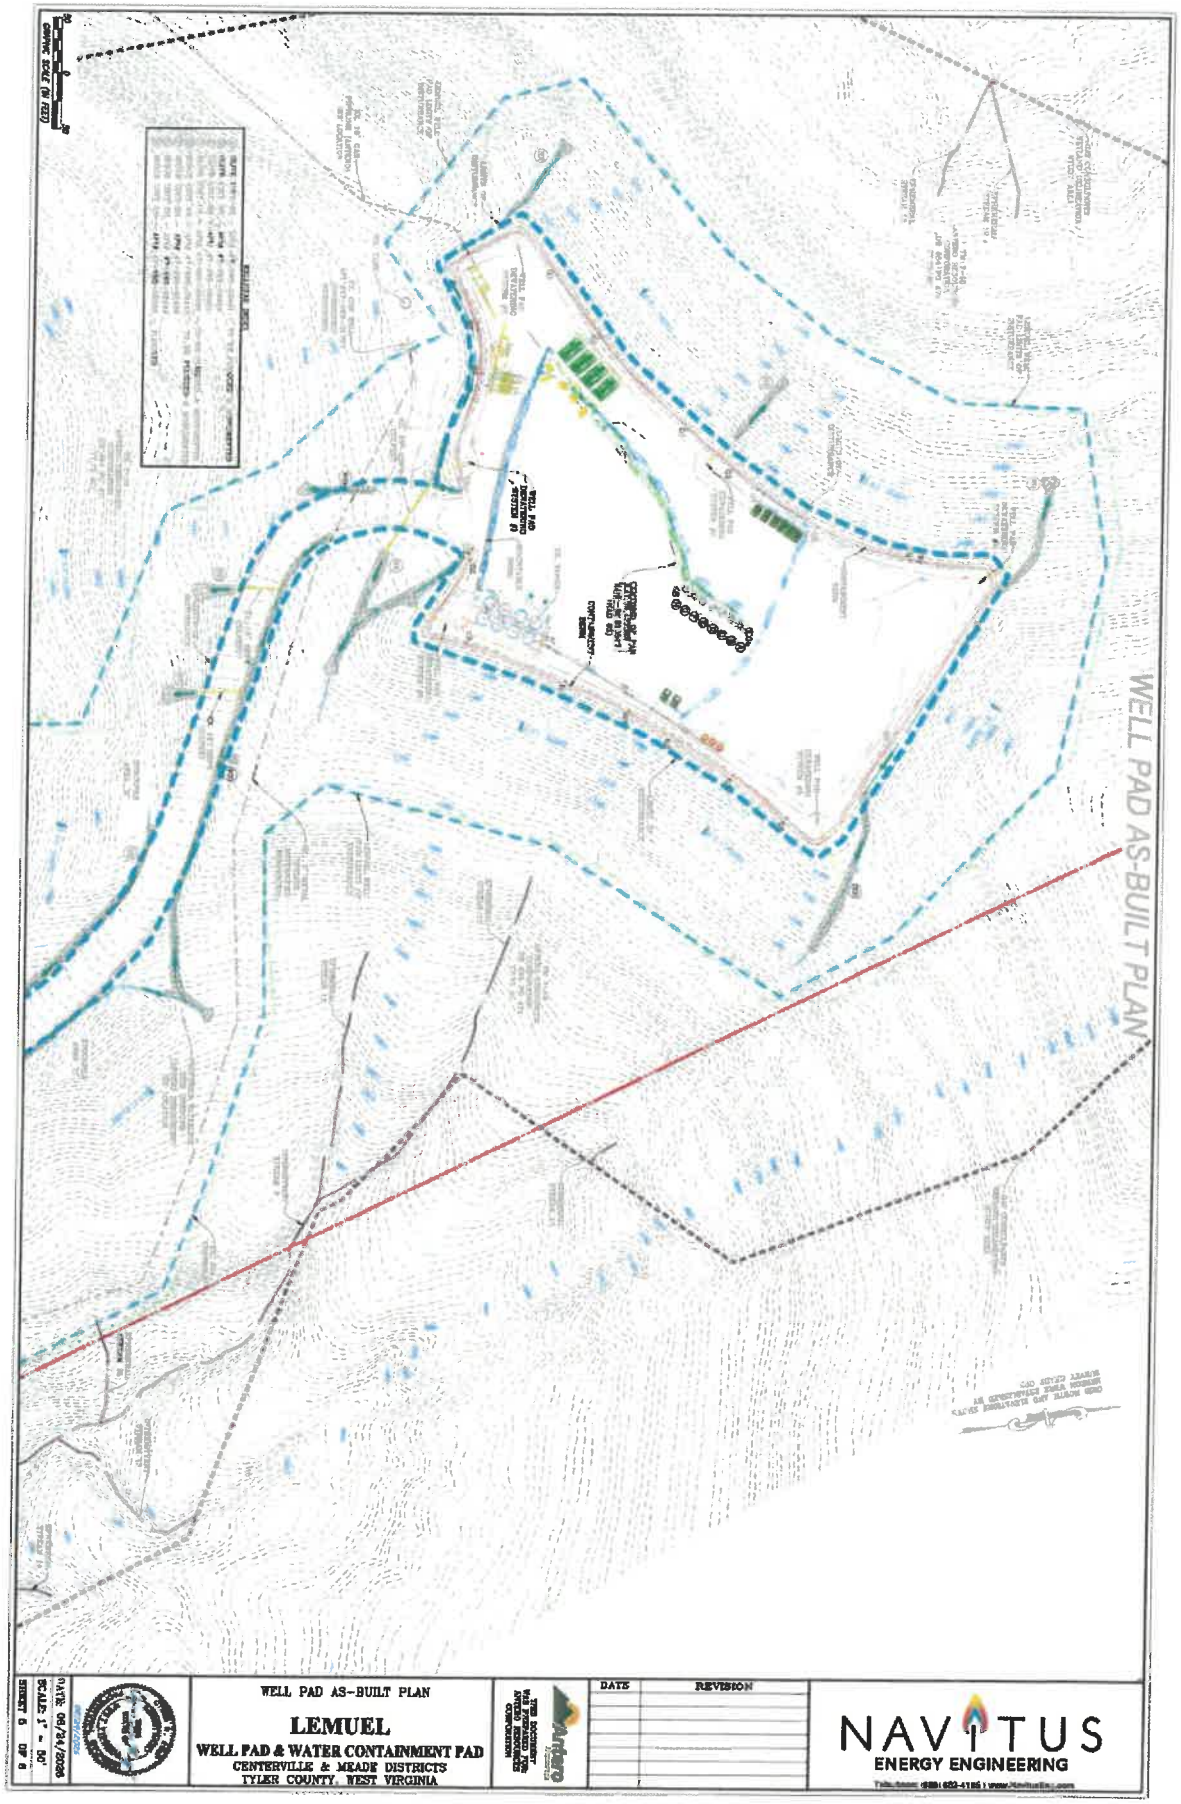

10/30/2026

4709502450P

WW-4A
Revised 6-07

1) Date: 9/23/2026
2) Operator's Well Number
Olive Unit 1H

3) API Well No.: 47 - 095 - 02450

STATE OF WEST VIRGINIA
DEPARTMENT OF ENVIRONMENTAL PROTECTION, OFFICE OF OIL AND GAS
NOTICE OF APPLICATION TO PLUG AND ABANDON A WELL

4) Surface Owner(s) to be served:
(a) Name: Antero Resources Corporation
Address: 1615 Wynkoop St
Denver, CO 80202
(b) Name:
Address:
(c) Name:
Address:

5) (a) Coal Operator
Name:
Address:
(b) Coal Owner(s) with Declaration
Name:
Address:
Name:
Address:
(c) Coal Lessee with Declaration
Name:
Address:

6) Inspector: Stephen E. McCoy
Address: 13016 Indian Creek Rd
Jacksonburg, WV 26377
Telephone: 681-344-3265

TO THE PERSONS NAMED ABOVE: You should have received this Form and the following documents:

(1) The application to Plug and Abandon a Well on Form WW-4B, which sets out the parties involved in the work and describes the well its and the plugging work order; and
(2) The plat (surveyor's map) showing the well location on Form WW-6.

The reason you received these documents is that you have rights regarding the application which are summarized in the instructions on the reverses side. However, you are not required to take any action at all.

Take notice that under Chapter 22-6 of the West Virginia Code, the undersigned well operator proposes to file or has filed this Notice and Application and accompanying documents for a permit to plug and abandon a well with the Chief of the Office of Oil and Gas, West Virginia Department of Environmental Protection, with respect to the well at the location described on the attached Application and depicted on the attached Form WW-6. Copies of this Notice, the Application, and the plat have been mailed by registered or certified mail or delivered by hand to the person(s) named above (or by publication in certain circumstances) on or before the day of mailing or delivery to the Chief.

Well Operator: Antero Resources Corporation
By: Brandon Binford BBF
Its: VP of Geology
Address: 1615 Wynkoop St
Denver, CO 80202
Telephone: 303-357-6773

CARLY RAYNE WREN
NOTARY PUBLIC - STATE OF COLORADO
NOTARY ID 20224038743
MY COMMISSION EXPIRES OCT 5, 2030

Subscribed and sworn before me this 23 day of September 2026
Carly Rayne Wren Notary Public
My Commission Expires 10-5-30

RECEIVED
Office Of Oil and Gas
OCT 13 2026
WV Department of
Environmental Protection

Oil and Gas Privacy Notice

The Office of Oil and Gas processes your personal information, such as name, address and phone number, as a part of our regulatory duties. Your personal information may be disclosed to other State agencies or third parties in the normal course of business or as needed to comply with statutory or regulatory requirements, including Freedom of Information Act requests. Our office will appropriately secure your personal information. If you have any questions about our use of your personal information, please contact DEP's Chief Privacy Officer at deprivacyoffier@wv.gov.

10/30/2026

4709502450P

SURFACE OWNER WAIVER

Operator's Well Number Olive Unit 1H

INSTRUCTIONS TO SURFACE OWNERS NAMED ON PAGE WW4-A

The well operator named on page WW-4A is applying for a permit from the State to plug and abandon a well. (Note: If the surface tract is owned by more than three persons, then these materials were served on you because your name appeared on the Sheriff's tax ticket on the land or because you actually occupy the surface tract. In either case, you may be the only owner who will actually receive these materials.) See Chapter 22 of the West Virginia Code. Well work permits are valid for 24 months. If you do not own any interest in the surface tract, please forward these materials to the true owner immediately if you know who it is. Also, please notify the well operator and the Office of Oil and Gas.

NOTE: YOU ARE NOT REQUIRED TO FILE ANY COMMENT.

WHERE TO FILE COMMENTS AND OBTAIN ADDITIONAL INFORMATION:

Chief, Office of Oil and Gas
Department of Environmental Protection
601 57th St. SE
Charleston, WV 25304
(304) 926-0450

Time Limits and methods for filing comments. The law requires these materials to be served on or before the date the operator files his Application. You have **FIVE (5) DAYS** after the filing date to file your comments. Comments must be filed in person or received in the mail by the Chief's office by the time stated above. You may call the Chief's office to be sure of the date. Check with your postmaster to ensure adequate delivery time or to arrange special expedited handling. If you have been contacted by the well operator and you have signed a "voluntary statement of no objection" to the planned work described in these materials, then the permit may be issued at any time.

Comments must be in writing. Your comments must include your name, address and telephone number, the well operator's name and well number and the approximate location of the proposed well site including district and county from the application. You may add other documents, such as sketches, maps or photographs to support your comments.

The Chief has the power to deny or condition a well work permit based on comments on the following grounds:

1) The proposed well work will constitute a hazard to the safety of persons.
2) The soil erosion and sediment control plan is not adequate or effective;
3) Damage would occur to publicly owned lands or resources;
4) The proposed well work fails to protect fresh water sources or supplies;
5) The applicant has committed a substantial violation of a previous permit or a substantial violation of one or more of the rules promulgated under Chapter 22, and has failed to abate or seek review of the violation...".

If you want a copy of the permit as it is issued or a copy of the order denying the permit, you should request a copy from the Chief.

RECEIVED
Office of Oil and Gas
OCT 13 2026
WV Department of Environmental Protection

VOLUNTARY STATEMENT OF NO OBJECTION

I hereby state that I have read the instructions to surface owners and that I have received copies of a Notice and Application For A Permit To Plug And Abandon on Forms WW-4A and WW-4B, and a survey plat.

I further state that I have no objection to the planned work described in these materials, and I have no objection to a permit being issued on those materials.

FOR EXECUTION BY A NATURAL PERSON ETC.

_____ Date _____
Signature

FOR EXECUTION BY A CORPORATION,

Name Antero Resources Corporation
By Brandon Binford
Its VP of Geology Date

Signature BRB Date 9-23-26

10/30/2026

4709502450P

WW-4B

API No. 47-095-02450
Farm Name Antero Resources Corporation
Well No. Olive Unit 1H

INSTRUCTIONS TO COAL OPERATORS
OWNERS AND LESSEE

The well operator named on the obverse side of WW-4 (B) is about to abandon the well described in the enclosed materials and will commence the work of plugging and abandoning said well on the date the inspector is notified. Which date shall not be less then five days after the day on which this notice and application so mailed is received, or in due course should be received by the Department of Environmental Protection Office of Oil & Gas.

This notice and application is given to you in order that your respective representatives may be present at the plugging and filling of said well. You are further notified that whether you are represented or not the operator will proceed to plug and fill said well in the manner required by Section 24, Article 6, Chapter 22 of the Code and given in detail on obverse side of this application.

NOTE: If you wish this well to be plugged according to 22-6-24(d) then as per Regulation 35CSR4-13.9 you must complete and return to this office on form OB-16 "Request by Coal Operator, Owner, or Lessee for plugging" prior to the issuance of this plugging permit.

WAIVER

The undersigned coal operator _____/ owner _____/ lessee _____/ of the coal under this well location has examined this proposed plugging work order. The undersigned has no objection to the work proposed to be done at this location, provided, the well operator has complied with all applicable requirements of the West Virginia Code and the governing regulations.

Date: _____

_____

By: _____

Its _____

RECEIVED
Office Of Oil and Gas
OCT 13 2026
WV Department of
Environmental Protection

10/30/2026

4709502450P

WW-9
(5/16)

API Number 47 - 095 - 02450
Operator's Well No. Olive Unit 1H

STATE OF WEST VIRGINIA
DEPARTMENT OF ENVIRONMENTAL PROTECTION
OFFICE OF OIL AND GAS
FLUIDS/ CUTTINGS DISPOSAL & RECLAMATION PLAN

Operator Name Antero Resources Corporation OP Code 494507062

Watershed (HUC 10) Outlet Middle Island Creek Quadrangle Middlebourne & Shirley

Do you anticipate using more than 5,000 bbls of water to complete the proposed well work? Yes ☐ No ☑

Will a pit be used? Yes ☐ No ☑

If so, please describe anticipated pit waste:

Will a synthetic liner be used in the pit? Yes ☐ No ☐ If so, what ml.?

Proposed Disposal Method For Treated Pit Wastes:

_____ Land Application (if selected provide a completed form WW-9-GPP)
_____ Underground Injection (UIC Permit Number _____)
_____ Reuse (at API Number _____)
■ Off Site Disposal (Supply form WW-9 for disposal location)
_____ Other (Explain _____)

Will closed loop systembe used? If so, describe: Yes, fluids stored in tanks, cuttings removed off site.

Drilling medium anticipated for this well (vertical and horizontal)? Air, freshwater, oil based, etc.

-If oil based, what type? Synthetic, petroleum, etc.

Additives to be used in drilling medium?

Drill cuttings disposal method? Leave in pit, landfill, removed offsite, etc. Removed Offsite - Solids Control Company

-If left in pit and plan to solidify what medium will be used? (cement, lime, sawdust)

-Landfill or offsite name/permit number? Buckeye Brine, Coshocton, OH – Belmont Solids Control, Cadiz, OH – Mud Masters, Friendly, WV

Permittee shall provide written notice to the Office of Oil and Gas of any load of drill cuttings or associated waste rejected at any West Virginia solid waste facility. The notice shall be provided within 24 hours of rejection and the permittee shall also disclose where it was properly disposed.

I certify that I understand and agree to the terms and conditions of the GENERAL WATER POLLUTION PERMIT issued on April 1, 2016, by the Office of Oil and Gas of the West Virginia Department of Environmental Protection. I understand that the provisions of the permit are enforceable by law. Violations of any term or condition of the general permit and/or other applicable law or regulation can lead to enforcement action.

I certify under penalty of law that I have personally examined and am familiar with the information submitted on this application form and all attachments thereto and that, based on my inquiry of those individuals immediately responsible for obtaining the information, I believe that the information is true, accurate, and complete. I am aware that there are significant penalties for submitting false information, including the possibility of fine or imprisonment.

RECEIVED
Office Of Oil and Gas
OCT 13 2026
WV Department of
Environmental Protection

Company Official Signature Gretchen Kohler
Company Official (Typed Name) Gretchen Kohler
Company Official Title Director of Environmental & Regulatory Compliance

Subscribed and sworn before me this 23 day of September, 20 20

Carly Rayne Wren Notary Public

My commission expires 10-5-30

CARLY RAYNE WREN
NOTARY PUBLIC - STATE OF COLORADO
NOTARY ID 20224038743
MY COMMISSION EXPIRES OCT 5, 2030

10/30/2026

4709502450P

Form WW-9

Operator's Well No. Weekley Unit 1H

Proposed Revegetation Treatment: Acres Disturbed 5.17 Prevegetation pH

Lime 2-3 Tons/acre or to correct to pH 6.5

Fertilizer type

Fertilizer amount 500 lbs/acre

Mulch 2-3 Tons/acre

Seed Mixtures

Temporary		Permanent	
Seed Type	lbs/acre	Seed Type	lbs/acre
Annual Ryegrass	40	Crownvetch	10-15
Field Bromegrass	40	Tall Fescue	30
Please reference Table IV-3 of the Well Plugging Plan		Please reference Table IV-4A of the Well Plugging Plan	

*or type of grass seed requested by surface owner

Attach:
Maps(s) of road, location, pit and proposed area for land application (unless engineered plans including this info have been provided). If water from the pit will be land applied, provide water volume, include dimensions (L, W, D) of the pit, and dimensions (L, W), and area in acres, of the land application area.

Photocopied section of involved 7.5' topographic sheet.

Plan Approved by: Stephen Mccoy Digitally signed by Stephen Mccoy Date: 2026.10.09 12:01:34 -04'00'

Comments:

RECEIVED
Office Of Oil and Gas
OCT 13 2026
WV Department of
Environmental Protection

Title: Date:

Field Reviewed? ( )Yes ( )No

10/30/2026

4709502450P

Oil&Gas

Wells, Horizontal Only

WellStatus

- Active Well
- Permit Issued
- Permit Application
- Plugged

Wells, Active Status Only

WellUse

- Brine Disposal
- Fluid Injection
- Gas Production
- House Gas
- Observation
- Oil Production
- Production
- Solution Mining
- Storage
- Vent
- <all other values>

Wells, Other than Active Status

WellUse

- Brine Disposal
- Fluid Injection
- Gas Production
- House Gas
- Observation
- Oil Production
- Production
- Solution Mining
- Storage



begin date

end date

10/30/2026

rainfall tota

update

4709502450P

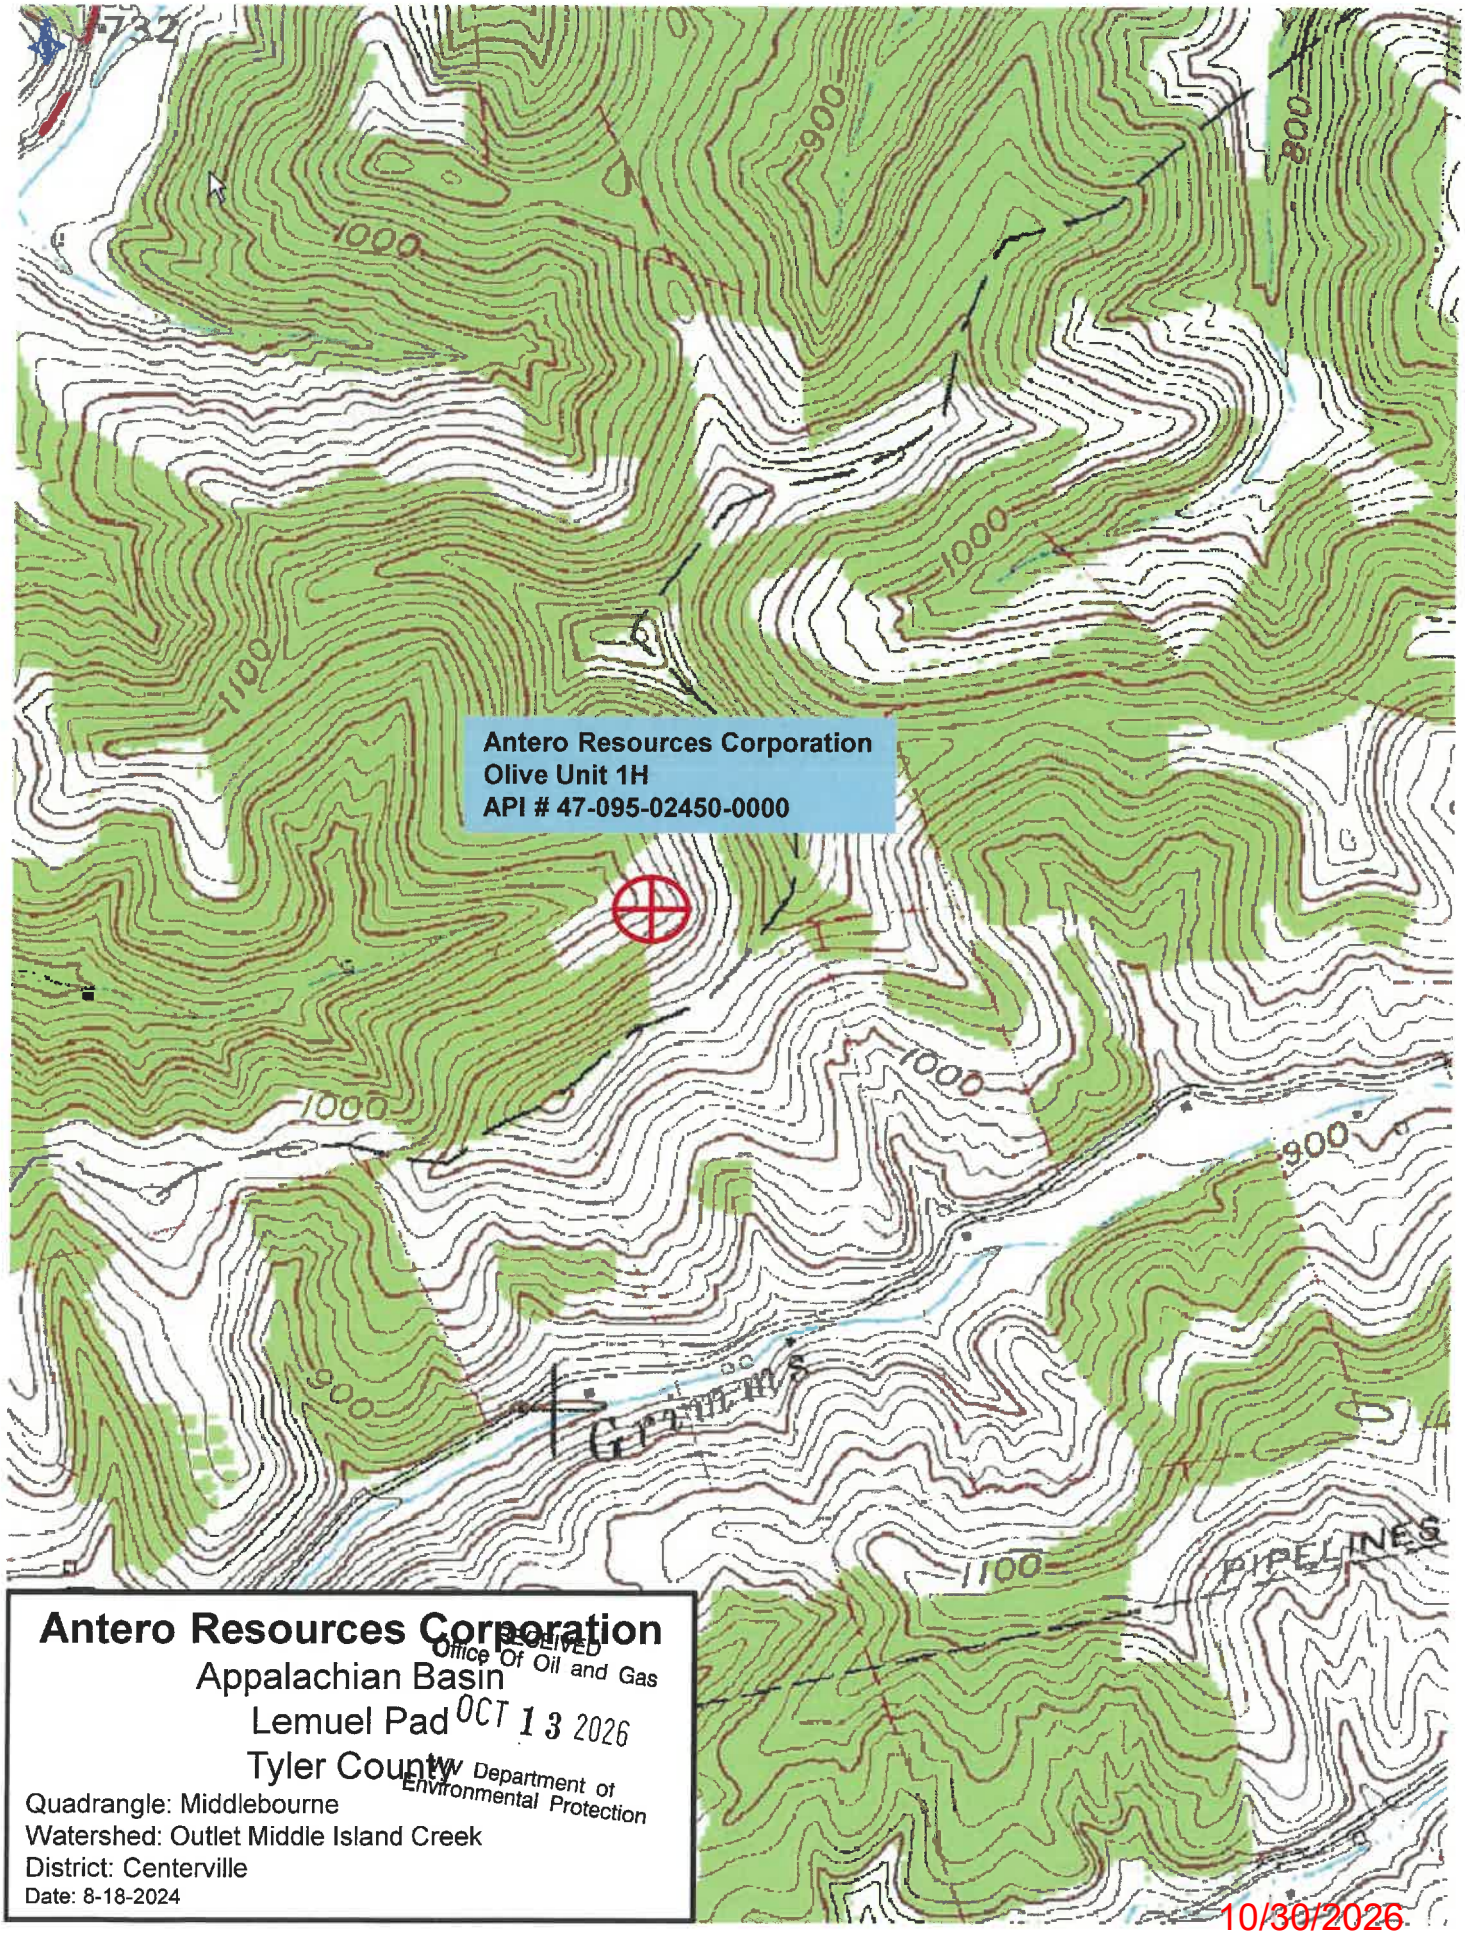

Antero Resources Corporation

Appalachian Basin

Lemuel Pad

Tyler County

Quadrangle: Middlebourne

Watershed: Outlet Middle Island Creek

District: Centerville

Date: 8-18-2024

RECEIVED
Office Of Oil and Gas
OCT 13 2026
WV Department of
Environmental Protection

4709502450P

WW-7
8-30-06

West Virginia Department of Environmental Protection
Office of Oil and Gas
WELL LOCATION FORM: GPS

API: 47-095-02450 **WELL NO.:** Olive 1H

FARM NAME: Lemuel

RESPONSIBLE PARTY NAME: Antero Resources Corporation

COUNTY: Tyler **DISTRICT:** Centerville & Meade

QUADRANGLE: Middlebourne & Shirley

SURFACE OWNER: Antero Resources Corporation

ROYALTY OWNER:

UTM GPS NORTHING: 4363663.49 m

UTM GPS EASTING: 507458.75 m **GPS ELEVATION:** 1158.2 ft

The Responsible Party named above has chosen to submit GPS coordinates in lieu of preparing a new well location plat for a plugging permit or assigned API number on the above well. The Office of Oil and Gas will not accept GPS coordinates that do not meet the following requirements:

1. Datum: NAD 1983, Zone: 17 North, Coordinate Units: meters, Altitude: height above mean sea level (MSL) – meters.
2. Accuracy to Datum – 3.05 meters
3. Data Collection Method:

Survey grade GPS ___: Post Processed Differential ___

Real-Time Differential X

Mapping Grade GPS X: Post Processed Differential ___

Real-Time Differential X

RECEIVED
Office Of Oil and Gas
OCT 13 2026
WV Department of
Environmental Protection

4. **Letter size copy of the topography map showing the well location.**

I the undersigned, hereby certify this data is correct to the best of my knowledge and belief and shows all the information required by law and the regulations issued and prescribed by the Office of Oil and Gas.

Signature | Permitting manager Title | 9/23/26 Date

10/30/2026