4709502450P

Oil&Gas

Wells, Horizontal Only

WellStatus

- Active Well
- Permit Issued
- Permit Application
- Plugged

Wells, Active Status Only

WellUse

- Brine Disposal
- Fluid Injection
- Gas Production
- House Gas
- Observation
- Oil Production
- Production
- Solution Mining
- Storage
- Vent
- <all other values>

Wells, Other than Active Status

WellUse

- Brine Disposal
- Fluid Injection
- Gas Production
- House Gas
- Observation
- Oil Production
- Production
- Solution Mining
- Storage



begin date

end date

10/30/2026

rainfall tota

update

4709502450P

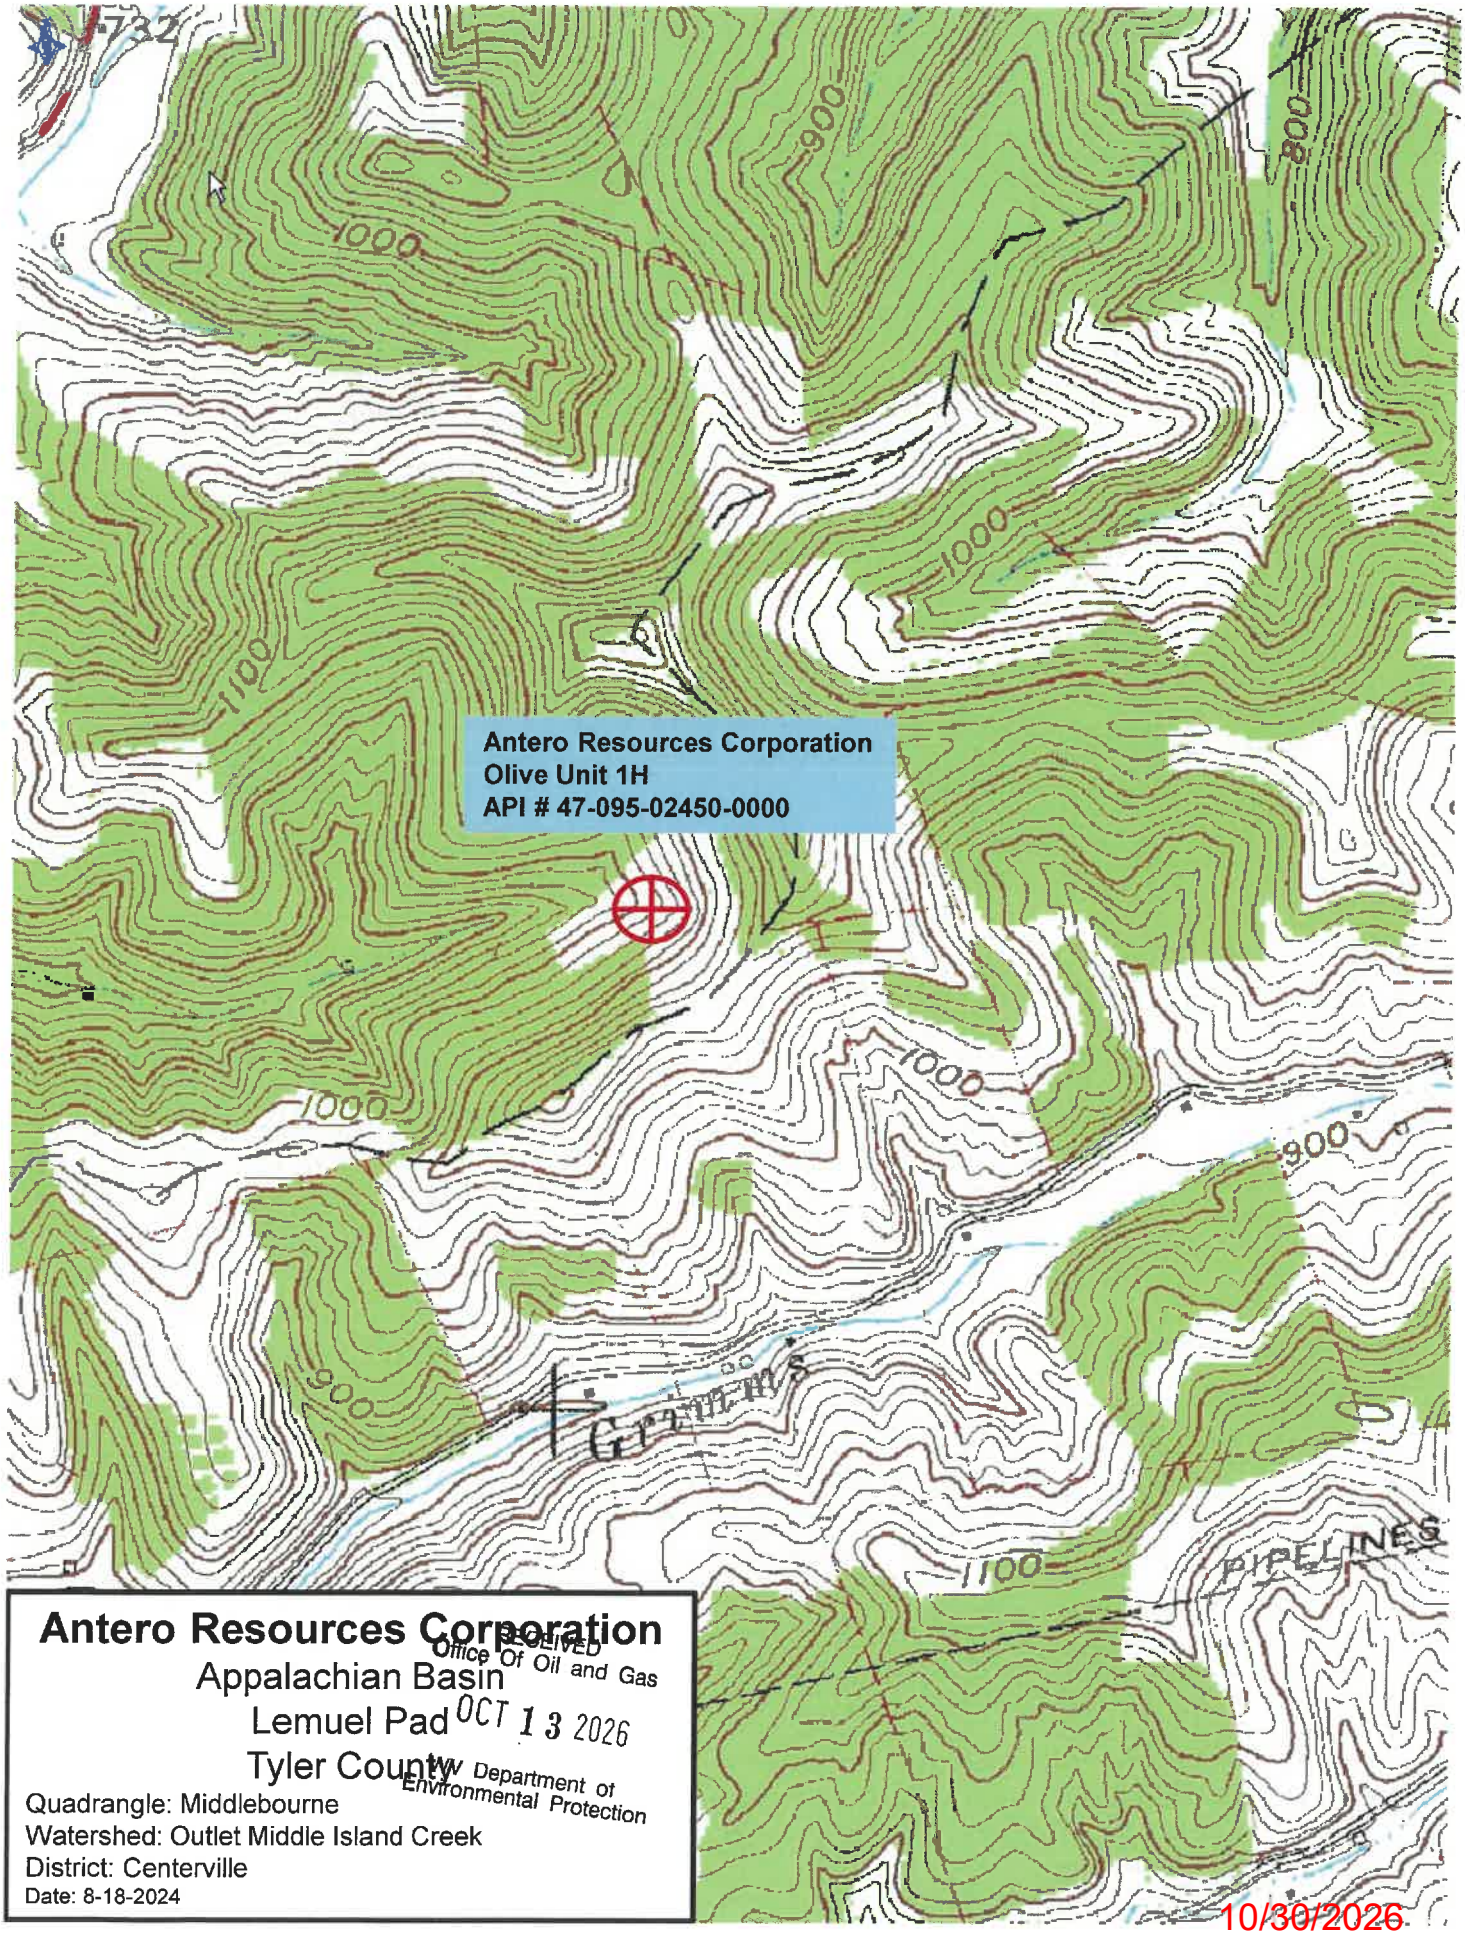

Antero Resources Corporation

Appalachian Basin

Lemuel Pad

Tyler County

Quadrangle: Middlebourne

Watershed: Outlet Middle Island Creek

District: Centerville

Date: 8-18-2024

RECEIVED
Office Of Oil and Gas
OCT 13 2026
WV Department of
Environmental Protection

4709502450P

WW-7
8-30-06

West Virginia Department of Environmental Protection
Office of Oil and Gas
WELL LOCATION FORM: GPS

API: 47-095-02450 **WELL NO.:** Olive 1H

FARM NAME: Lemuel

RESPONSIBLE PARTY NAME: Antero Resources Corporation

COUNTY: Tyler **DISTRICT:** Centerville & Meade

QUADRANGLE: Middlebourne & Shirley

SURFACE OWNER: Antero Resources Corporation

ROYALTY OWNER:

UTM GPS NORTHING: 4363663.49 m

UTM GPS EASTING: 507458.75 m **GPS ELEVATION:** 1158.2 ft

The Responsible Party named above has chosen to submit GPS coordinates in lieu of preparing a new well location plat for a plugging permit or assigned API number on the above well. The Office of Oil and Gas will not accept GPS coordinates that do not meet the following requirements:

1. Datum: NAD 1983, Zone: 17 North, Coordinate Units: meters, Altitude: height above mean sea level (MSL) – meters.
2. Accuracy to Datum – 3.05 meters
3. Data Collection Method:

Survey grade GPS ___: Post Processed Differential ___

Real-Time Differential X

Mapping Grade GPS X: Post Processed Differential ___

Real-Time Differential X

RECEIVED
Office Of Oil and Gas
OCT 13 2026
WV Department of
Environmental Protection

4. **Letter size copy of the topography map showing the well location.**

I the undersigned, hereby certify this data is correct to the best of my knowledge and belief and shows all the information required by law and the regulations issued and prescribed by the Office of Oil and Gas.

Signature | Permitting manager Title | 9/23/26 Date

10/30/2026