



Borehole: Original Borehole	Well: SHR-38K-HSM	Field: WV Tyler County (NAD 27)	Structure: Patterson 563
---------------------------------------	-----------------------------	---	------------------------------------

Gravity & Magnetic Parameters Model: HDGM 2019 Dip: 86.402° Date: 15-Dec-2019 MagDec: -7.712° FS: 51773.109NT Gravity FS: 999.321mgN (9.80665 Based)	Surface Location NAD27 West Virginia State Plane, Northern Zone, US Feet Let: N 39 22 17.49 Northing: 329233.16RUS Grid Conv: -0.8518" Lon: W 80 50 7.92 Easting: 162248.53RUS Scale Fact: 0.99995055	Miscellaneous Slot: SHR-38K-HSM TVD Ref: RKB(1040.8ft above MSL) Plan: CNX SHR-38K-HSM MWD 0' to 16564' MD
---	---	---

Critical Point	MD	INCL	AZM	TVD	VSEC	W-YPSI	S-YPSI	DLR
BHL	0.00	0.00	0.00	0.00	0.00	0.00	0.00	
CurveKick	5495.00	11.20	191.19	5494.99	-490.80	-463.87	-179.00	2.08
Marcellus	6796.43	72.04	332.44	6467.50	-30.70	-216.59	-443.44	8.80
Landing Point	6976.00	80.00	333.26	6527.74	178.28	-34.54	-441.72	8.86
Onondaga	13183.87	80.20	340.94	6546.10	6369.82	6800.38	-2868.08	0.14
Chopped TVD	13788.00	80.94	341.34	6561.19	6663.90	6300.18	-2894.96	0.91
Chonage	14787.82	91.14	342.12	6546.10	7982.90	7361.20	-3201.17	1.14
Final Survey	16564.00	80.78	341.01	6541.10	8893.82	9115.85	-3791.83	1.10
PTB	16984.00	88.78	341.01	6541.20	9878.82	9139.29	-3796.96	0.90

PART	Seq	Survey Tool	Vendor/Tool	Hole Size	Casing Size	Expected	MD From	MD To	Survey	EDU Size	EDU Size	Comments
1	1	NAL_NDSH-HSHOT-Cheek Only		30	30		0	29	166.425	1.251	1.25	
1	2	NAL_NDSH-HSHOT-Cheek Only		30	30		29	29	Aut Shts	1.281	1.25	
1	3	NAL_NDSH-HSHOT		30	30		29	661.61	Aut Shts	2.086	1.384	
1	4	NAL_MWD-HOH_BLR		30	30		661.61	6608	Aut Shts	16.402	7.041	
1	5	NAL_MWD_1A_DEG		30	30		6608	16564	Aut Shts	327.884	11.873	

Surface Location		Grid Coord		Local Coord						
Northing:	329233.16	Easting:	162248.534	Latitude:	N 39 22 17.49					
Longitude:	W 80 50 7.92	WGS Azimuth:	341.08							
Target Name	Shape	Dimension	Latitude	Longitude	Northing	Easting	TVD	VSEC	W-YPSI	S-YPSI
North B Marcellus Unit	Playline	N/A	N 39 22 17.88	W 80 50 8.07	320271.40	1622406.90	1040.80	36.80	38.24	-11.73
North A Marcellus Unit	Playline	N/A	N 39 22 17.88	W 80 50 8.07	320271.40	1622406.90	1040.80	36.80	38.24	-11.73
SHR-38K-HSM BHL	Point	N/A	N 39 22 47.18	W 80 50 8.28	320098.08	1618036.40	6460.00	9878.84	9132.89	-3819.33
SHR-38K-HSM LP	Point	N/A	N 39 22 17.84	W 80 50 18.68	320248.86	1621790.87	6460.00	238.90	16.86	-478.00

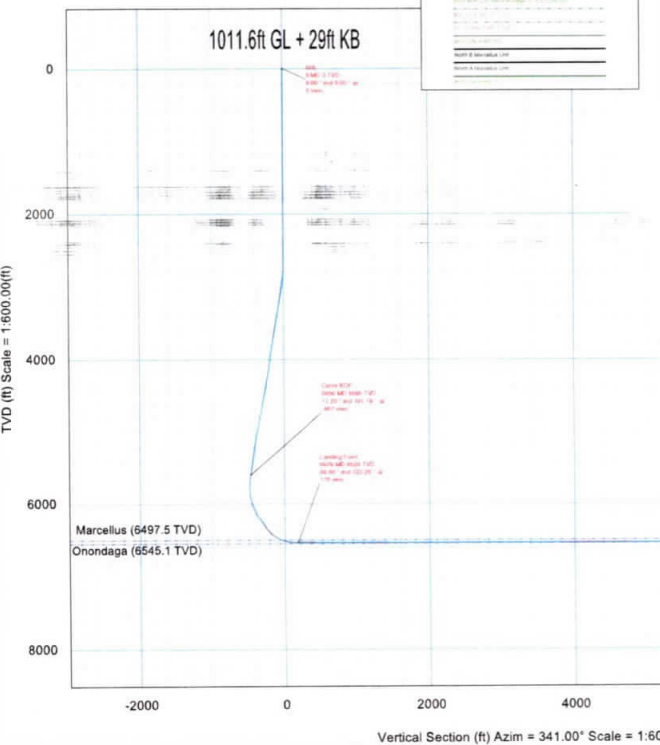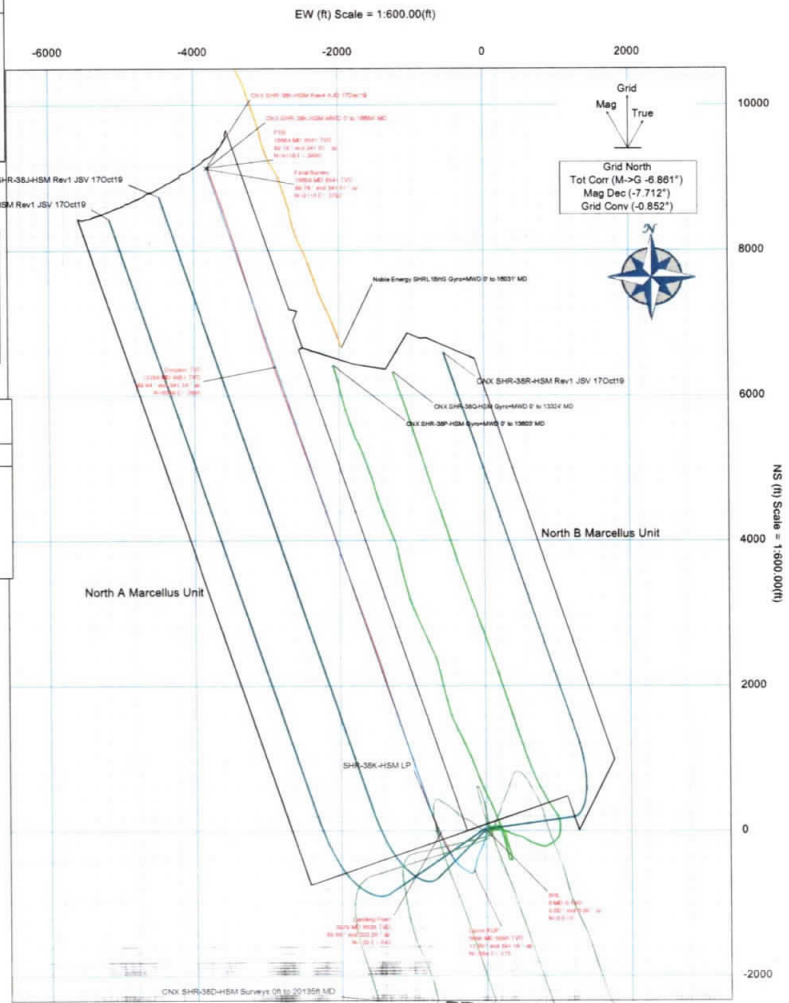

RECEIVED
Office of Oil and Gas
JUN 17 2021
WV Department of
Environmental Protection

CONTROLLED	
Drawn By:	J. Shannon
Checked By:	
Copy Number:	1 of 1
Date:	18-Jun-2020
Copy number:	1 of 1

CNX SHR-38K-HSM MWD 0' to 16684' MD Survey Report

(Def Survey)

Report Date: February 19, 2020 - 04:33 PM
Client: CNX
Field: WV Tyler County (NAD 27)
Structure / Slot: CNX SHR-38 Pad / SHR-38K-HSM
Well: SHR-38K-HSM
Borehole: Original Borehole
UWI / AP##: Unknown / Unknown
Survey Name: CNX SHR-38K-HSM MWD 0' to 16684' MD
Survey Date: December 15, 2019
Tort / AHD / DDI / ERD Ratio: 263.487' / 11074.166 ft / 6.871 / 1.690
Coordinate Reference System: NAD27 West Virginia State Plane, Northern Zone, US Feet
Location Lat / Long: N 39° 22' 17.487444 W 80° 50' 7.915117
Location Grid N/E Y/X: N 320233.160 RUS; E 1622448.534 RUS
CRS Grid Convergence Angle: -0.8518°
CRS Grid Scale Factor: 0.99995055
Version / Patch: 2.10.787.0

Survey / DLS Computation: Minimum Curvature / Lubinski
Vertical Section Azimuth: 341.000° (Grid North)
Vertical Section Origin: 0.000 ft, 0.000 ft
TVD Reference Datum: RKB
TVD Reference Elevation: 1040.600 ft above MSL
Original Borehole: 1011.000 ft above MSL
Magnetic Declination: -7.712°
Total Gravity Field Strength: 999.3213mg (g.80665 Based)
Gravity Model: GARM
Total Magnetic Field Strength: 51773.109 nT
Magnetic Dip Angle: 66.402°
Declination Date: December 15, 2019
Magnetic Declination Model: HDGM 2019
North Reference: Grid North
Grid Convergence Used: -0.8518°
Total Corr Mag North-Grid North: -6.8606°
Local Coord Referenced To: Well Head

Table with columns: Comments, MD (ft), Incl, Azim Grid (ft), TVD (ft), TVDSS (ft), VSEC (ft), NS (ft), EW (ft), DLS (ft/100ft), TF (ft/100ft), BR (ft/100ft), TR (ft/100ft), Northing (RUS), Easting (RUS), Latitude (°), Longitude (°), Directional (°), Ditch Index. The table contains a large number of rows representing survey data points.

Curve KOP
Marcellus
Landing Point


Comments	MD (ft)	Incl (°)	Azim Grid (°)	TVD (ft)	TVD55 (ft)	VSEC (ft)	NS (ft)	EW (ft)	DLS (ft/100ft)	TF (ft)	BR (ft/100ft)	TR (ft/100ft)	Northing (ft)	Easting (ft)	Latitude	Longitude	Directional Diff (ft)	Index
