



CNX





Borehole: Original Borehole	Well: SHR-371-HSM	Field: WV Tyler County (NAD 27)	Structure: CNX SHR-37 Pad
Gravity & Magnetic Parameters		Surface Location	Miscellaneous

Point	NO	ECL	ADM	TVD	VSEC	RTV/FV	RTV/H	SUR
Overage	None							

Point	NO	ECL	ADM	TVD	VSEC	RTV/FV	RTV/H	SUR

Target Description	Northings	Eastings	Latitude	Longitude	View Azimuth	SALR					
Target Name	313605.21	1619460.21	N 38 21 11.55	W 88 50 44.45							

CNX SHR-37 Pad - Boundary	NA		W 39.24 52.98	W 89.50 46.70	313626.76	1619626.13	807.00	211.623	22458.67	198.12	
CNX SHR-37 Pad - North A	NA		W 39.21 11.23	W 89.50 44.14	313472.86	1619502.00	807.00	-96.28	-82.38	23.81	

- CNX SHR-371-HSM Survey 06 to 22194N MD
- CNX SHR-371-HSM Rev 0 C.V.S 09Nov19
- CNX SHR-371-HSM Rev 1 SLS 06Nov20
- CNX SHR-371-HSM Rev 2 SLS 18Nov20
- CNX SHR-371-HSM Rev 3 SLS 06Nov20
- CNX SHR-371-HSM Rev 4 SLS 06Nov20
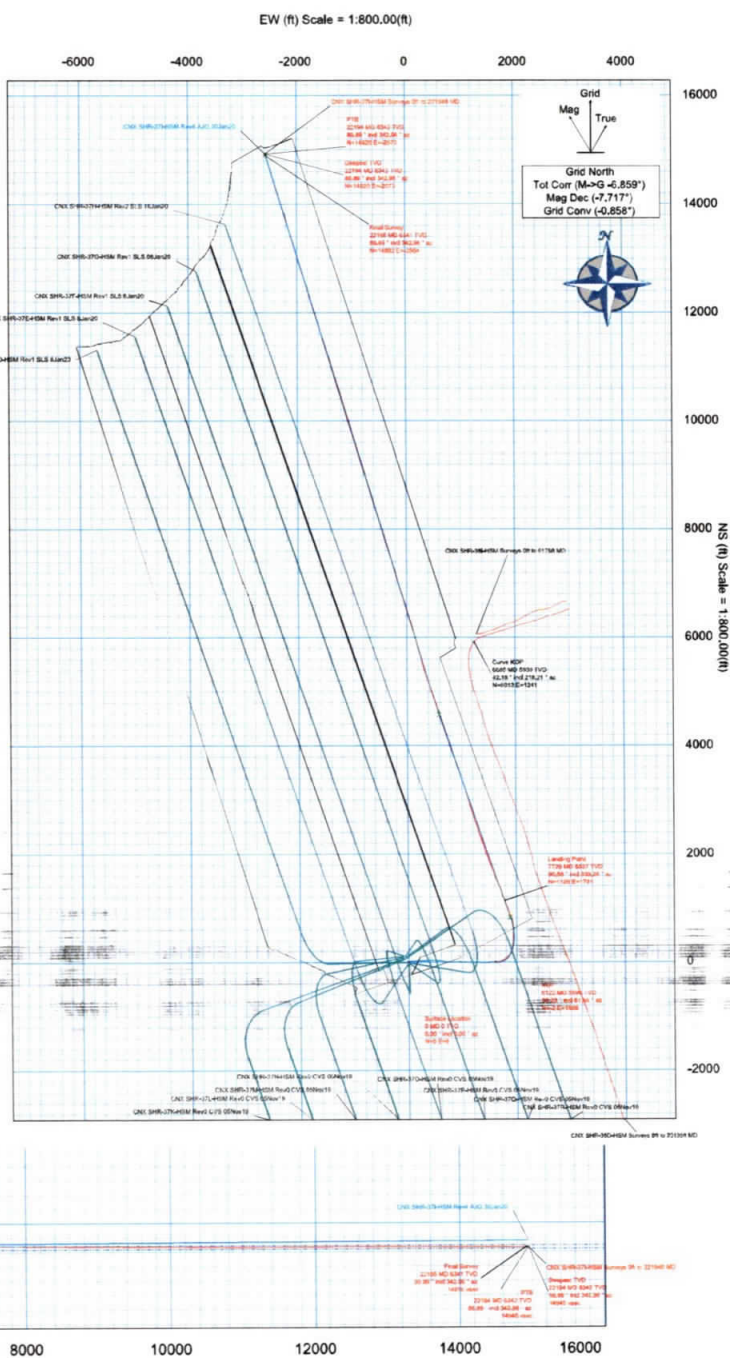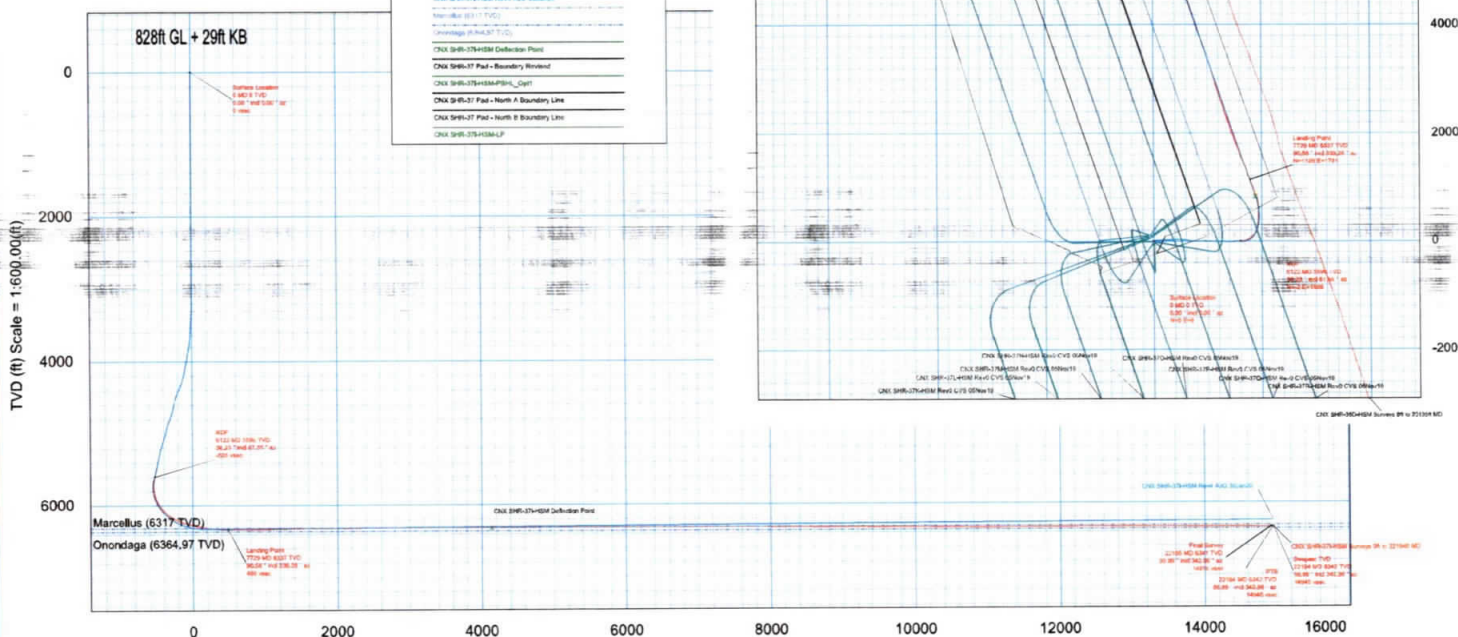

CONTROLLED

Plan ref:	CNX SHR-371-HSM Survey 06 to 22194N MD
Drawing ref:	08/27/2021
Drawn by:	AT
Date:	27-Aug-2021
Checked by:	J. Shannon
Drawn by:	J. Shannon
Drawn by:	J. Shannon

RECEIVED
Office of Oil and Gas

JUL 12 2021

WV Department of
Environmental Protection

08/27/2021

Comments	MD (ft)	Incl (°)	Azim Grid (°)	TVD (ft)	TVDSS (ft)	VSEC (ft)	NS (ft)	EW (ft)	DLS (°/100ft)	TF (°)	BR (°/100ft)	TR (°/100ft)	Northing (ftUS)	Easting (ftUS)	Latitude (°)	Longitude (°)	Directional Difficulty Index
	19721.00	90.17	342.71	8333.33	5476.38	12473.13	12554.07	-1849.58	0.13	147.06R	0.06	-0.12	326159.58	1617630.52	39.38759594	-80.85288811	7.13
	19816.00	90.00	342.82	8333.19	5476.19	12568.08	12645.71	-1877.73	0.21	157.62R	-0.18	0.12	326250.29	1617602.37	39.38784385	-80.85299252	7.14
	19910.00	89.86	342.96	8333.47	5476.47	12662.03	12735.55	-1905.38	0.39	71.57L	-0.36	0.15	326340.12	1617574.72	39.38809933	-80.85309513	7.14
	20005.00	89.78	342.80	8333.93	5476.93	12755.88	12826.29	-1933.51	0.40	128.90R	0.13	-0.38	326430.88	1617546.80	39.38833726	-80.85319046	7.15
	20099.00	89.61	342.81	8334.43	5477.43	12850.94	12918.04	-1961.45	0.29	87.08R	-0.18	0.22	326520.60	1617518.85	39.38858247	-80.85330309	7.15
	20193.00	89.66	343.79	8335.03	5478.03	12944.86	13006.07	-1988.46	1.04	96.47L	0.05	1.04	326610.83	1617491.85	39.38882851	-80.85340344	7.16
	20288.00	89.55	342.82	8335.89	5478.89	13039.78	13097.06	-2015.75	1.03	22.38R	-0.12	-1.02	326701.62	1617464.36	39.38907716	-80.85350483	7.16
	20382.00	89.72	342.80	8336.29	5479.29	13133.73	13188.88	-2043.46	0.20	55.46R	0.18	0.07	326791.43	1617436.65	39.38932259	-80.85360785	7.17
	20476.00	89.83	343.05	8336.66	5479.66	13227.67	13278.78	-2070.99	0.21	90R	0.12	0.17	326881.31	1617409.12	39.38956817	-80.85370983	7.17
	20570.00	89.83	343.07	8336.94	5479.94	13321.61	13366.68	-2098.38	0.02	1.47L	0.00	0.02	326971.22	1617381.73	39.38981388	-80.85381151	7.18
	20665.00	90.22	343.06	8336.89	5479.89	13415.55	13457.56	-2126.05	0.41	135.58L	0.41	-0.01	327062.10	1617354.08	39.39006222	-80.85391425	7.18
	20759.00	89.72	342.57	8336.94	5479.94	13510.50	13547.36	-2153.83	0.74	86.53R	-0.53	-0.52	327151.90	1617326.29	39.39030759	-80.85401728	7.19
	20853.00	89.78	343.56	8337.35	5480.35	13604.44	13637.29	-2181.21	1.06	86.28R	0.06	1.05	327241.82	1617298.91	39.39055330	-80.85411894	7.20
	20948.00	89.89	345.25	8337.83	5480.83	13699.27	13728.79	-2208.75	1.78	97.36L	0.12	1.78	327333.31	1617273.37	39.39080342	-80.85424148	7.20
	21042.00	89.50	342.23	8338.13	5481.13	13793.15	13819.01	-2233.06	3.24	76.61L	-0.41	-3.21	327423.53	1617247.06	39.39105002	-80.85431207	7.21
	21136.00	89.55	342.02	8338.91	5481.91	13887.13	13908.47	-2261.91	0.23	77.87R	0.05	-0.22	327512.99	1617218.21	39.39129440	-80.85441891	7.22
	21231.00	89.78	343.09	8339.46	5482.46	13982.09	13999.10	-2290.39	1.15	32.47R	0.24	1.13	327603.61	1617189.73	39.39154201	-80.85452449	7.22
	21325.00	89.89	343.16	8339.73	5482.73	14076.02	14086.05	-2317.68	0.14	49.76L	0.12	0.07	327693.56	1617162.45	39.39178781	-80.85462582	7.23
	21419.00	90.00	343.03	8339.82	5482.82	14169.96	14178.99	-2345.01	0.18	93.18L	0.12	-0.14	327783.49	1617135.11	39.39203357	-80.85472732	7.23
	21514.00	89.98	342.67	8339.84	5482.84	14264.91	14269.77	-2373.03	0.38	87.51R	-0.02	-0.38	327874.28	1617107.10	39.39228160	-80.85483126	7.24
	21608.00	90.00	343.13	8339.86	5482.86	14358.86	14359.61	-2400.67	0.49	126.87L	0.02	0.49	327964.10	1617079.46	39.39252709	-80.85493384	7.24
	21702.00	89.61	342.61	8340.18	5483.18	14452.81	14449.44	-2428.35	0.69	45R	-0.41	-0.55	328053.93	1617051.78	39.39277253	-80.85503656	7.25
	21797.00	90.00	343.00	8340.50	5483.50	14547.76	14540.19	-2456.44	0.58	117.85R	0.41	0.41	328144.68	1617023.70	39.39302050	-80.85514078	7.25
	21891.00	89.89	343.21	8340.59	5483.59	14641.70	14630.14	-2483.75	0.25	127.48L	-0.12	0.22	328234.61	1616996.38	39.39326627	-80.85524222	7.26
	21985.00	89.66	342.91	8340.96	5483.96	14735.63	14720.06	-2511.14	0.40	23.5L	-0.24	-0.32	328324.53	1616968.99	39.39351196	-80.85534391	7.26
	22080.00	89.89	342.91	8341.33	5484.33	14830.58	14810.84	-2539.14	0.26	90R	0.24	-0.11	328415.31	1616941.00	39.39376002	-80.85544781	7.26
Final Survey	22185.00	89.89	342.96	8341.49	5484.49	14915.54	14892.07	-2564.15	0.18	HS	0.00	0.18	328496.54	1616915.98	39.39399199	-80.85554064	7.27
PTB	22194.00	89.89	342.96	8341.55	5484.55	14944.52	14919.80	-2572.65	0.00		0.00	0.00	328524.28	1616907.49	39.39405775	-80.85557218	7.27

Survey Type: Def Survey

Survey Error Model: ISCWSA Rev 0 *** 3-D 95.000% Confidence 2.7855 sigma
 Survey Program:

Description	Part	MD From (ft)	MD To (ft)	EOU Freq (ft)	Hole Size (in)	Casing Diameter (in)	Survey Tool Type	Borehole / Survey
	1	0.000	29.000	1/08.425	30.000	30.000	NAL_NSG+MSHOT-Depth Only	Original Borehole / CNX SHR-37I-HSM Surveys Off to 22194ft MD
	1	29.000	29.000	Acf Sins	30.000	30.000	NAL_NSG+MSHOT-Depth Only	Original Borehole / CNX SHR-37I-HSM Surveys Off to 22194ft MD
	1	29.000	385.000	Acf Sins	30.000	30.000	NAL_NSG+MSHOT	Original Borehole / CNX SHR-37I-HSM Surveys Off to 22194ft MD
	1	385.000	22194.000	Acf Sins	30.000	30.000	NAL_MWD_1.0_DEG	Original Borehole / CNX SHR-37I-HSM Surveys Off to 22194ft MD

RECEIVED
 Office of Oil and Gas
 JUL 12 2021
 WV Department of
 Environmental Protection