



CNX SHR-37K-HMS Surveys 0ft to 19477ft MD Survey Geodetic Report

(Def Survey)

Report Date: April 18, 2022 - 11:29 AM
Client: CNX
Field: WV Tyler County (NAD 27)
Structure / Slot: CNX SHR-37 Pad / SHR-37K-HSM
Well: SHR-37K-HSM
Borehole: Original Borehole
UWI / API#: Unknown / Unknown
Survey Name: CNX SHR-37K-HMS Surveys 0ft to 19477ft MD
Survey Date: April 10, 2022
Tort / AHD / DDI / ERD Ratio: 318.994 ° / 15025.641 ft / 7.170 / 2.383
Coordinate Reference System: NAD27 West Virginia State Plane, Northern Zone, US Feet
Location Lat / Long: N 39° 21' 12.21683", W 80° 50' 45.41638"
Location Grid N/E Y/X: N 313674.254 ftUS, E 1619404.962 ftUS
CRS Grid Convergence Angle: -0.8584 °
Grid Scale Factor: 0.999952
Version / Patch: 2.10.829.1

Survey / DLS Computation: Minimum Curvature / Lubinski
Vertical Section Azimuth: 161.000 ° (Grid North)
Vertical Section Origin: 0.000 ft, 0.000 ft
TVD Reference Datum: RKB
TVD Reference Elevation: 857.000 ft above MSL
Seabed / Ground Elevation: 828.000 ft above MSL
Magnetic Declination: -7.461 °
Total Gravity Field Strength: 999.3376mgn (9.80665 Based)
Gravity Model: GARM
Total Magnetic Field Strength: 51589.680 nT
Magnetic Dip Angle: 66.190 °
Declination Date: April 10, 2022
Magnetic Declination Model: HDGM 2022
North Reference: Grid North
Grid Convergence Used: -0.8584 °
Total Corr Mag North->Grid North: -6.6026 °
Local Coord Referenced To: Well Head

Comments	MD (ft)	Incl (°)	Azim Grid (°)	TVD (ft)	TVDSS (ft)	VSEC (ft)	NS (ft)	EW (ft)	DLS (°/100ft)	BR (°/100ft)	TR (°/100ft)	Northing (ftUS)	Easting (ftUS)	Latitude (°)	Longitude (°)
Surface Location	0.00	0.00	0.00	0.00	-857.00	0.00	0.00	0.00	N/A	N/A	N/A	313674.25	1619404.96	39.35339356	-80.84594899
	100.00	0.28	119.62	100.00	-757.00	0.18	-0.12	0.21	0.28	0.28	0.00	313674.13	1619405.17	39.35339324	-80.84594824
	125.00	0.20	125.83	125.00	-732.00	0.26	-0.18	0.30	0.34	-0.32	24.84	313674.08	1619405.26	39.35339309	-80.84594792
	150.00	0.22	163.80	150.00	-707.00	0.35	-0.25	0.35	0.55	0.08	151.88	313674.01	1619405.31	39.35339290	-80.84594774
	175.00	0.56	160.79	175.00	-682.00	0.52	-0.41	0.40	1.36	1.36	-12.04	313673.84	1619405.37	39.35339246	-80.84594755
	200.00	0.49	158.31	200.00	-657.00	0.75	-0.62	0.48	0.29	-0.28	-9.92	313673.63	1619405.44	39.35339187	-80.84594725
	225.00	0.24	139.75	225.00	-632.00	0.90	-0.76	0.56	1.09	-1.00	-74.24	313673.49	1619405.52	39.35339149	-80.84594699
	250.00	0.23	192.55	250.00	-607.00	0.99	-0.85	0.58	0.84	-0.04	211.20	313673.40	1619405.54	39.35339125	-80.84594690
	275.00	0.33	218.53	275.00	-582.00	1.08	-0.96	0.52	0.64	0.40	103.92	313673.30	1619405.49	39.35339096	-80.84594709
	300.00	0.39	209.53	300.00	-557.00	1.17	-1.09	0.44	0.33	0.24	-36.00	313673.17	1619405.40	39.35339060	-80.84594739
	325.00	0.35	191.95	325.00	-532.00	1.29	-1.24	0.38	0.48	-0.16	-70.32	313673.02	1619405.34	39.35339018	-80.84594759
	350.00	0.40	155.99	350.00	-507.00	1.45	-1.39	0.40	0.95	0.20	-143.84	313672.86	1619405.36	39.35338976	-80.84594751
	370.00	0.44	157.82	369.99	-487.01	1.59	-1.53	0.46	0.21	0.20	9.15	313672.73	1619405.42	39.35338939	-80.84594730
	422.00	0.34	215.42	421.99	-435.01	1.88	-1.84	0.44	0.74	-0.19	110.77	313672.42	1619405.40	39.35338854	-80.84594733
	515.00	0.62	199.92	514.99	-342.01	2.43	-2.53	0.11	0.33	0.30	-16.67	313671.72	1619405.07	39.35338661	-80.84594847
	609.00	0.81	222.38	608.98	-248.02	3.15	-3.50	-0.51	0.36	0.20	23.89	313670.75	1619404.45	39.35338393	-80.84595061
	702.00	1.14	196.20	701.97	-155.03	4.22	-4.88	-1.21	0.59	0.35	-28.15	313669.38	1619403.75	39.35338013	-80.84595302
	795.00	1.28	236.87	794.95	-62.05	5.23	-6.33	-2.34	0.92	0.15	43.73	313667.92	1619402.62	39.35337608	-80.84595693
	888.00	1.36	233.98	887.93	30.93	5.80	-7.55	-4.10	0.11	0.09	-3.11	313666.70	1619400.86	39.35337267	-80.84596310
	982.00	2.00	228.50	981.89	124.89	6.76	-9.29	-6.23	0.70	0.68	-5.83	313664.96	1619398.73	39.35336780	-80.84597054
	1076.00	2.05	226.43	1075.83	218.83	8.08	-11.54	-8.68	0.09	0.05	-2.20	313662.72	1619396.28	39.35336153	-80.84597907
	1169.00	3.14	232.12	1168.73	311.73	9.60	-14.25	-11.90	1.20	1.17	6.12	313660.01	1619393.07	39.35335396	-80.84599030
	1262.00	3.68	233.25	1261.56	404.56	11.33	-17.60	-16.30	0.59	0.58	1.22	313656.66	1619388.67	39.35334458	-80.84600568
	1356.00	5.07	231.96	1355.29	498.29	13.61	-21.96	-21.99	1.48	1.48	-1.37	313652.29	1619382.98	39.35333237	-80.84602557
	1450.00	5.41	231.30	1448.90	591.90	16.46	-27.29	-28.72	0.37	0.36	-0.70	313646.96	1619376.25	39.35331746	-80.84604908
	1543.00	6.89	232.90	1541.36	684.36	19.67	-33.40	-36.59	1.60	1.59	1.72	313640.86	1619368.38	39.35330037	-80.84607658
	1637.00	9.15	234.91	1634.43	777.43	23.49	-41.10	-47.20	2.42	2.40	2.14	313633.16	1619357.76	39.35327880	-80.84611370
	1730.00	10.82	236.89	1726.02	869.02	27.67	-50.12	-60.56	1.83	1.80	2.13	313624.14	1619344.40	39.35325349	-80.84616047
	1823.00	13.41	232.42	1816.94	959.94	33.24	-61.47	-76.42	2.96	2.78	-4.81	313612.79	1619328.54	39.35322169	-80.84621595
	1918.00	13.67	228.04	1909.31	1052.31	41.13	-75.69	-93.50	1.11	0.27	-4.61	313598.57	1619311.46	39.35318194	-80.84627558
	2010.00	12.42	233.51	1998.93	1141.93	48.34	-88.84	-109.54	1.91	-1.36	5.95	313585.41	1619295.43	39.35314517	-80.84633160
	2104.00	12.58	240.71	2090.71	1233.71	53.21	-99.86	-126.60	1.67	0.17	7.66	313574.40	1619278.43	39.35311422	-80.84639132
	2198.00	14.71	253.97	2182.08	1325.08	54.42	-108.17	-147.00	4.01	2.27	14.11	313566.09	1619257.97	39.35309057	-80.84646303
	2291.00	14.21	256.04	2272.13	1415.13	52.80	-114.18	-169.43	0.77	-0.54	2.23	313560.07	1619235.54	39.35307314	-80.84654200
	2384.00	14.98	254.20	2362.13	1505.13	51.13	-120.21	-192.07	0.97	0.83	-1.98	313554.05	1619212.90	39.35305567	-80.84662174
	2478.00	16.63	251.60	2452.57	1595.57	50.31	-127.77	-216.53	1.91	1.76	-2.77	313546.49	1619188.44	39.35303392	-80.84670781
	2572.00	17.93	252.08	2542.33	1685.33	49.90	-136.46	-243.06	1.39	1.38	0.51	313537.80	1619161.91	39.35300895	-80.84680115
	2665.00	19.08	250.85	2630.50	1773.52	49.67	-145.86	-271.04	1.31	1.24	-1.32	313528.41	1619133.93	39.35298202	-80.84689959
	2763.00	20.58	249.95	2722.70	1865.70	50.02	-157.02	-302.35	1.56	1.53	-0.92	313517.25	1619102.62	39.35295009	-80.84700971
	2856.00	20.57	250.33	2809.77	1952.77	50.51	-168.12	-333.09	0.14	-0.01	0.41	313506.14	1619071.88	39.35291835	-80.84711781
	2950.00	19.00	245.99	2898.23	2041.23	52.04	-179.90	-362.62	2.29	-1.67	-4.62	313494.36	1619042.36	39.35288478	-80.84722160

Schlumberger-Private


Comments	MD (ft)	Incl (°)	Azim Grid (°)	TVD (ft)	TVDSS (ft)	VSEC (ft)	NS (ft)	EW (ft)	DLS (*100ft)	BR (*100ft)	TR (*100ft)	Northing (ftUS)	Easting (ftUS)	Latitude (°)	Longitude (°)
	16552.00	89.88	160.78	6304.34	5447.34	9156.39	-9749.19	-189.37	0.34	-0.33	-0.07	303925.55	1619215.60	39.32662285	-80.84610201
	16646.00	89.84	160.97	6304.57	5447.57	9250.39	-9838.00	-158.56	0.20	-0.04	0.20	303836.75	1619246.41	39.32638032	-80.84598843
Deepest TVD	16739.00	90.10	161.35	6304.62	5447.62	9343.39	-9926.02	-128.53	0.50	0.28	0.42	303748.73	1619276.44	39.32613994	-80.84587763
	16926.00	90.11	160.98	6304.28	5447.28	9530.39	-10103.01	-68.17	0.20	0.00	-0.20	303571.75	1619336.80	39.32565656	-80.84565491
	17018.00	90.05	160.52	6304.16	5447.16	9622.39	-10189.86	-37.84	0.50	-0.07	-0.50	303484.90	1619367.12	39.32541937	-80.84554313
	17112.00	89.62	161.32	6304.43	5447.43	9716.38	-10278.70	-7.11	0.96	-0.46	0.85	303396.07	1619397.85	39.32517677	-80.84542982
	17205.00	90.20	161.52	6304.58	5447.58	9809.38	-10366.85	22.52	0.66	0.63	0.22	303307.92	1619427.48	39.32493600	-80.84532041
	17298.00	89.85	160.93	6304.54	5447.54	9902.38	-10454.90	52.46	0.74	-0.37	-0.63	303219.88	1619457.42	39.32469552	-80.84520995
	17392.00	90.36	161.54	6304.36	5447.36	9996.38	-10543.90	82.70	0.85	0.54	0.65	303130.88	1619487.65	39.32445244	-80.84509838
	17485.00	90.46	162.55	6303.70	5446.70	10089.36	-10632.37	111.36	1.09	0.11	1.08	303042.42	1619516.32	39.32421076	-80.84499238
	17580.00	90.45	161.98	6302.94	5445.94	10184.33	-10722.85	140.30	0.60	-0.01	-0.60	302951.94	1619545.25	39.32396356	-80.84488533
	17673.00	90.42	161.22	6302.22	5445.22	10277.32	-10811.09	169.65	0.82	-0.03	-0.82	302863.70	1619574.61	39.32372253	-80.84477691
	17767.00	90.70	160.81	6301.30	5444.30	10371.32	-10899.97	200.24	0.53	0.29	-0.43	302774.82	1619605.19	39.32347980	-80.84466413
	17861.00	90.23	161.22	6300.54	5443.54	10465.32	-10988.86	230.81	0.67	-0.50	0.44	302685.94	1619635.76	39.32323705	-80.84455136
	17954.00	90.17	161.39	6300.21	5443.21	10558.31	-11076.95	260.62	0.19	-0.07	0.18	302597.85	1619665.56	39.32299645	-80.84444137
	18047.00	91.23	160.57	6299.08	5442.08	10651.30	-11164.87	290.92	1.45	-0.89	-0.89	302509.95	1619695.87	39.32275635	-80.84432961
	18140.00	90.98	161.05	6297.28	5440.28	10744.29	-11252.68	321.49	0.58	-0.26	0.52	302422.14	1619726.44	39.32251655	-80.84421693
	18234.00	91.26	161.08	6295.44	5438.44	10838.27	-11341.57	351.99	0.30	0.29	0.03	302333.25	1619756.94	39.32227377	-80.84410442
	18327.00	90.58	161.26	6293.94	5436.94	10931.25	-11429.59	382.01	0.76	-0.73	0.20	302245.24	1619786.95	39.32203340	-80.84399370
	18421.00	90.91	161.35	6292.72	5435.72	11025.25	-11518.62	412.13	0.36	0.34	0.09	302156.21	1619817.07	39.32179023	-80.84388253
	18514.00	90.73	161.25	6291.39	5434.39	11118.23	-11606.70	441.94	0.22	-0.19	-0.10	302068.13	1619846.88	39.32154966	-80.84377251
	18608.00	90.45	160.69	6290.41	5433.41	11212.23	-11695.56	472.59	0.67	-0.29	-0.60	301979.28	1619877.53	39.32130698	-80.84365952
	18700.00	90.01	160.86	6290.04	5433.04	11304.23	-11782.43	502.88	0.52	-0.49	0.18	301892.41	1619907.82	39.32106976	-80.84354786
	18793.00	89.75	161.66	6290.24	5433.24	11397.23	-11870.50	532.76	0.90	-0.27	0.86	301804.35	1619937.70	39.32082923	-80.84343760
	18887.00	89.72	161.07	6290.67	5433.67	11491.22	-11959.57	562.80	0.62	-0.04	-0.62	301715.29	1619967.74	39.32058595	-80.84332673
	18980.00	90.11	161.46	6290.81	5433.81	11584.22	-12047.64	592.67	0.59	0.42	0.42	301627.22	1619997.61	39.32034541	-80.84321651
	19074.00	90.74	160.73	6290.11	5433.11	11678.22	-12136.56	623.13	1.03	0.67	-0.78	301538.30	1620028.06	39.32010255	-80.84310419
	19169.00	90.59	161.44	6289.01	5432.01	11773.21	-12226.43	653.92	0.76	-0.16	0.75	301448.44	1620058.85	39.31985712	-80.84299061
	19262.00	90.51	161.53	6288.11	5431.11	11866.20	-12314.61	683.45	0.13	-0.09	0.10	301360.26	1620088.38	39.31961626	-80.84288159
	19356.00	90.92	161.43	6286.94	5429.94	11960.19	-12403.73	713.31	0.45	0.44	-0.11	301271.14	1620118.23	39.31937282	-80.84277137
Final SLB_MWD	19449.00	90.11	160.45	6286.11	5429.11	12053.19	-12491.63	743.68	1.37	-0.87	-1.06	301183.25	1620148.60	39.31913278	-80.84265940
PTB	19477.00	90.11	160.45	6286.05	5429.05	12081.18	-12518.01	753.05	0.01	0.01	0.01	301156.87	1620157.97	39.31906074	-80.84262490

Survey Type: Def Survey

Survey Error Model: ISCWSA Rev 3 *** 3-D 95.000% Confidence 2.7955 sigma
 Survey Program:

Description	Part	MD From (ft)	MD To (ft)	EOU Freq (ft)	Hole Size (in)	Casing Diameter (in)	Survey Tool Type	Borehole / Survey
	1	0.000	29.000	1/98.425	17.500	13.375	A020Ga_GYRO-NS-Depth Only	Original Borehole / CNX SHR-37K-HMS Surveys 0ft to 19477ft MD
	1	29.000	29.000	Act Stns	17.500	13.375	A020Ga_GYRO-NS-Depth Only	Original Borehole / CNX SHR-37K-HMS Surveys 0ft to 19477ft MD
	1	29.000	422.000	Act Stns	17.500	13.375	A020Ga_GYRO-NS	Original Borehole / CNX SHR-37K-HMS Surveys 0ft to 19477ft MD
	1	422.000	5248.000	Act Stns	12.250	9.625	A001Mb_MWD	Original Borehole / CNX SHR-37K-HMS Surveys 0ft to 19477ft MD
	1	5248.000	19477.000	Act Stns	8.500	5.500	B006Mb_MWD+IGRF	Original Borehole / CNX SHR-37K-HMS Surveys 0ft to 19477ft MD




Borehole: Original Borehole	Well: SHR-37K-HSM	Field: WV Tyler County (NAD 27)	Structure: Patterson 873
---------------------------------------	-----------------------------	---	------------------------------------

Gravity & Magnetic Parameters Model: HDOM 2022 MagDec: -7.461°	Dip: 66.19° FS: 1589.65nT	Date: 10-Apr-2022 Gravity FS: 999.338mgal (9.80665 Based)	Surface Location NAD27 West Virginia State Plane, Northern Zone, US Feet Lat: N 39 21 12.22 Lon: W 80 50 46.42	Northing: 313674.267US Easting: 161940.948US Grid Conv: -0.8694' Scale Fact: 0.999962	Miscellaneous Slot: SHR-37K-HSM Plan: CNX SHR-37K-HSM Surveys 01 to 19477R MD	TVD Ref: RKB(867R above MSL)
---	------------------------------	--	--	--	--	------------------------------

Target Name	Shape	Dimension	Latitude	Longitude	Height	Grid Coord	True	Local Coord
SHR37_m2_abrvns_fm_1 - 50R setback	Polygon	N/A	N 39 21 12.38	W 80 50 45.57	313680.44	161938.21	857.20	-18.13
SHR37_m2_abrvns_fm_3 - 50R setback	Polygon	N/A	N 39 21 12.38	W 80 50 45.57	313680.44	161938.21	857.20	-18.13
SHR37_m2_abrvns_fm_2 (30x30)	Polygon	N/A	N 39 21 12.38	W 80 50 45.57	313680.44	161938.21	857.20	-18.13
SHR37_m2_abrvns_fm_3	Polygon	N/A	N 39 21 12.38	W 80 50 45.57	313680.44	161938.21	857.20	-18.13
SHR37_m2_abrvns_fm_4	Polygon	N/A	N 39 21 12.38	W 80 50 45.57	313680.44	161938.21	857.20	-18.13
PART	Seq.	Survey Tool	Vendor/Tool	Head Size (in)	Casing Size (in)	Expected (in)	MD From (ft)	MD To (ft)	Survey Frequency (ft)	ESU Size (ft/min Major)	ESU Size (ft/min Minor)	Comments/Contingency
1	1	AD200A_OYDAS-Depth Only		17.5	13.375		0	29	188.475	0.731	0.70	
1	2	AD200A_OYDAS-Depth Only		17.5	13.375		29	29	Ad Stn	0.731	0.70	
1	3	AD200A_OYDAS		17.5	13.375		29	422	Ad Stn	2.479	2.475	
1	4	AD01M_MVD		12.25	9.625		422	5340	Ad Stn	34.509	25.891	
1	5	BD04M_MVD-HDRF		8.5	5.5		5348	19477	Ad Stn	351.861	79.52	

Critical Point	MD	INCL	AZIM	TVD	WVEC	NWVSL	EWVSL	DLS
Surface Location	0.00	0.00	0.00	0.00	0.00	0.00	0.00	
Last Set Point MVD	5248.00	20.71	242.85	5059.83	52.00	-431.87	-1062.10	1.34
First SLS_MVD	5328.00	21.11	240.42	5134.26	57.25	-440.34	-1117.21	1.19

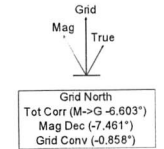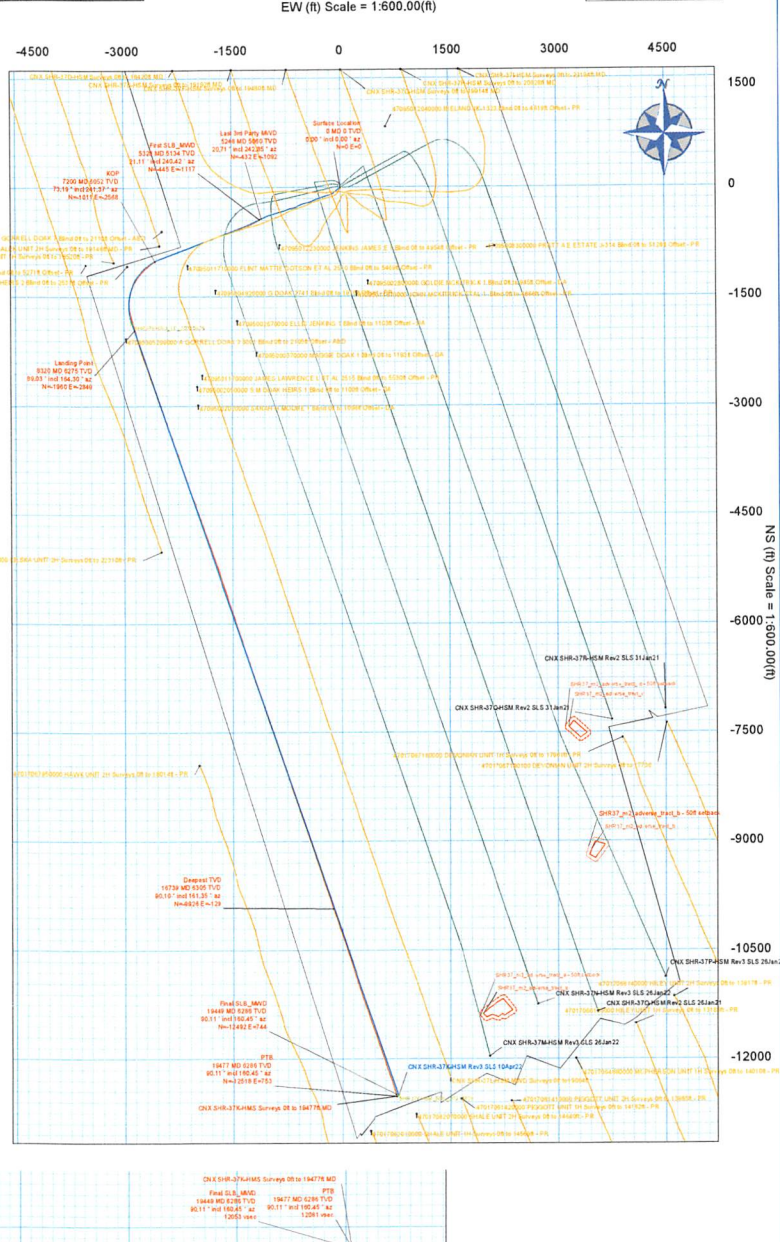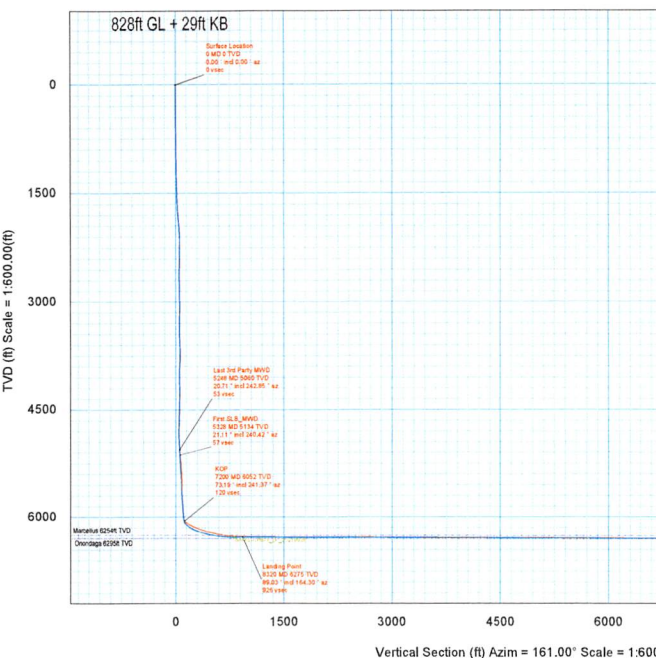

CONTROLLED

Plan of: CNX SHR-37K-HSM Surveys 01 to 19477R MD

Drawn by: [Signature]

Copy number: 3

Date: 19-Apr-2022

Drawn By: S. Shannon

Copy number: [Blank]

03/17/2023