



Tribune Resources




Borehole:	Well:	Field:	Structure:
BFT 1H	BFT 1H	WV Tyler County (NAD 27)	Precision 578

Gravity & Magnetic Parameters	Surface Location	Miscellaneous
Model: HDGM 2024 Dip: 66.166° Date: 02-Jan-2025	NAD27 West Virginia State Plane, Northern Zone, US Feet	Sheet: SPT 1H TVD Ref: RCB (907.000 ft above MSL)
MagDec: -8.032° FS: 61475.812nT Gravity FS: 998.35mgal (SRO665 Based)	Lat: N 39 27 35.78 Northing: 352195.689US Grid Conv: -8.759°	Plan: Tribune Resources SPT 1H Rev'd SLS 02Jan25
	Lon: W 80 41 24.22 Easting: 1854000.349US Scale Fact: 0.99994488	


POST	Int.	Survey Tool Survey Tool Code	Standard	Meas Size (in)	Coating Size (in)	Expected Meas Int (ft)	MD From (ft)	MD To (ft)	Survey Pressure (PSI)	EDU Size (Steel Major) (ft)	EDU Size (Steel Minor) (ft)	Comments Configuration
1	1	ADP100_MWD		17.5	15.75	8	8208	8208	1700.00	52.671	51.807	
1	2	ADP100_MWD		8.75	8.75	8208	8278	1700.00	53.267	51.807		
1	3	EDS100_MWD-4547		8.5	8.5	8278	17007.012	1700.00	53.535	51.804		

Comments	Survey MWD	Survey Pressure	Actual Meas	TVD (ft)	Vel (ft/s)	North	EW (ft)	Surf Elev (ft)	DC (ft)
Surface	0.00	0.00	0.00	0.00	0.00	0.00	0.00	-907.00	1.72
First 3rd Party MWD	6.206.00	37.53	230.29	5.756.08	-491.15	-1.193.07	-1.084.69	4.849.08	2.28
First SLS MWD	6.275.00	37.19	227.76	5.810.92	-499.12	-1.220.52	-1.116.30	4.903.92	10.09
Landing Point	8.247.00	88.31	338.62	6.911.26	278.89	-969.60	-2.234.02	6.004.26	0.21
Final Survey	17.984.00	90.43	329.55	6.781.83	9.508.87	7.409.83	-6.584.35	6.874.83	
PTB	17.917.00	90.43	329.55	6.781.58	9.541.87	7.438.28	-7.001.08	5.874.58	

EW (ft) Scale = 1:650.00(ft)

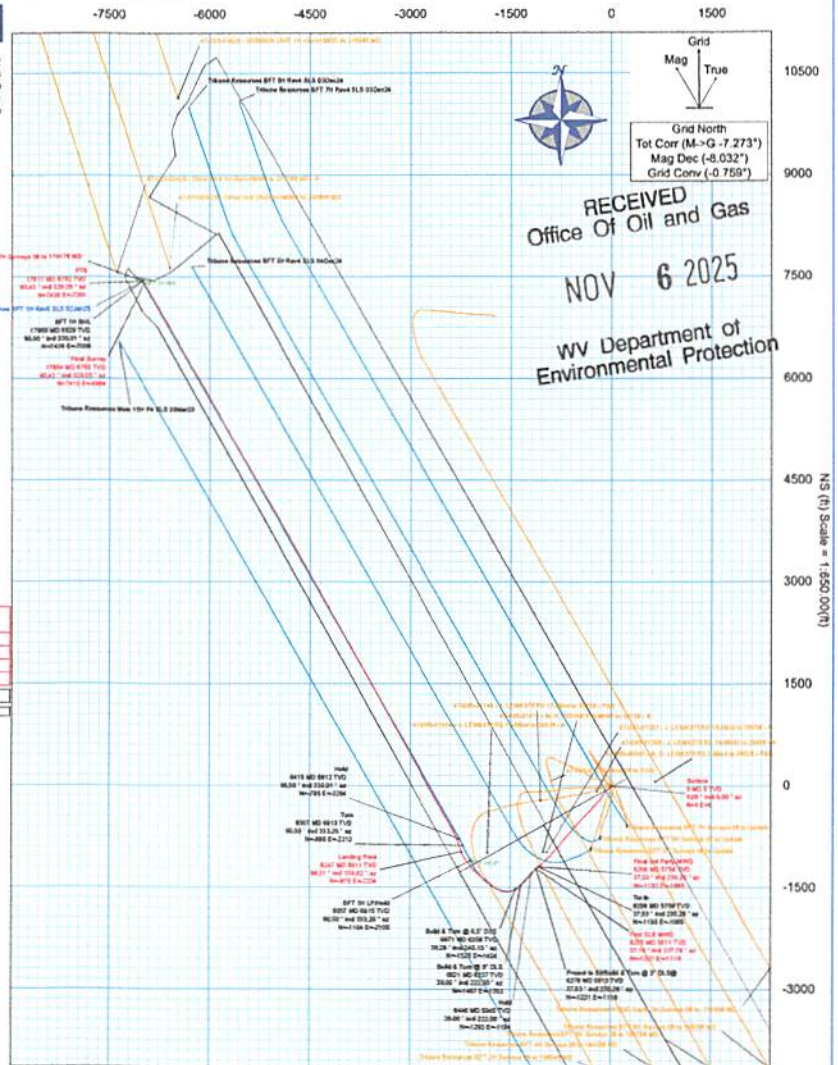

CONTROLLED	
Plan ref	Tribune Resources SPT 1H Rev'd SLS 02Jan25
Drawing ref	
Copy created	of 1
Date	02-Jan-2025
Drawn By	C. Semone
Copy number	for

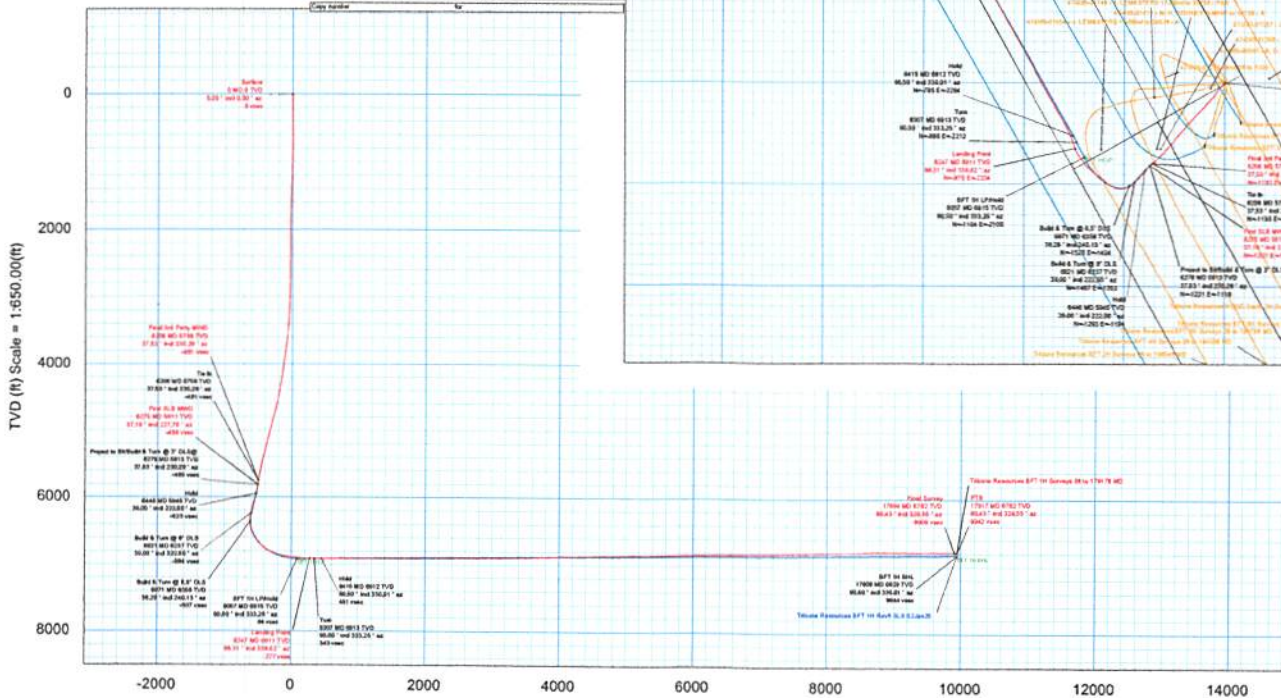

Vertical Section (ft) Azim = 330.01° Scale = 1:650.00(ft) Origin = 0N/-S, 0E/-W

12/12/2025



Tribune Resources BFT 1H Surveys Off to 17917ft MD Survey Geodetic Report
Definitive Survey

Report Date: January 07, 2025 - 05:13 PM (UTC 0)
Client: Tribune Resources
Field: WV Tylene County (NAD 27)
Structure / Skit: Tribune Resources BFT Pad / BFT 1H
Well: BFT 1H
Borehole: BFT 1H
UBH / API / Job Number: Unknown / Unknown
Survey Name / Version: Tribune Resources BFT 1H Surveys Off to 17917ft MD / 1
Survey Date: January 02, 2025
Tort / AHD / DOI / ERD Ratio: 264.700' / 12835.538' / 6.945' / 1.857
Coordinate Reference System: NAD27 West Virginia State Plane, Northern Zone, US Feet
Location Lat / Long: N 39°27'38.7520" W 80°41'24.22561"
Location Grid N/E Y/X: N 352155.679 RUS, E 1664000.342 RUS
CRS Grid Convergence Angle: -0.759"
Grid Scale Factor: 0.99994483(Applied)
Engine Version: 2024.4.0.4

Survey / DLS Computation: Minimum Curvature / Lubinski
Vertical Section Azimuth: 330.010° (Grid North)
Vertical Section Origin: 0.000 R, 0.000 R
TVD Reference Datum: RKB
TVD Reference Elevation: 907.000 R above MSL
Seabed / Ground Elevation: 880.000 R above MSL
Magnetic Declination: -8.032"
Total Gravity Field Strength: 999.3467mgm (9.80665 Based)
Gravity Model: GARM
Total Magnetic Field Strength: 51475.812 nT
Magnetic Dip Angle: 66.169°
Declination Date: January 02, 2025
Magnetic Declination Model: HDGM 2024
North Reference: Grid
Total Corr Mag: -7.273"
Local Coord Referenced To: Well Head

RECEIVED
Office Of Oil and Gas

NOV 6 2025

WV Department of
Environmental Protection

Comments	MD (ft)	Incl (°)	Azim (°)	TVD (ft)	VSEC (ft)	NS (ft)	EW (ft)	TVDSS (ft)	DLS (ft/100ft)	Northing (ft)	Easting (ft)	Latitude (N/S ° ' ")	Longitude (E/W ° ' ")
Surface	0.00	0.00	0.00	0.00	0.00	0.00	0.00	-407.00		352,155.68	1,694,000.34	N 39°27'38.75"	W 80°41'24.22"
	130.00	0.44	306.44	130.00	0.48	0.30	-0.40	-777.00	0.34	352,155.98	1,693,999.94	N 39°27'38.76"	W 80°41'24.23"
	180.00	0.86	273.35	180.00	0.85	0.45	-0.92	-1718.00	0.64	352,156.13	1,693,999.42	N 39°27'38.76"	W 80°41'24.24"
	284.00	1.26	261.59	283.98	1.54	0.33	-2.50	-423.02	0.66	352,156.01	1,693,997.84	N 39°27'38.76"	W 80°41'24.26"
	373.00	1.47	253.54	372.96	2.16	-0.14	-4.57	-534.04	0.32	352,155.54	1,693,995.78	N 39°27'38.75"	W 80°41'24.28"
	481.00	1.20	254.36	480.93	2.96	-0.70	-8.54	-648.07	0.31	352,154.97	1,693,993.81	N 39°27'38.74"	W 80°41'24.31"
	552.00	1.04	247.00	551.92	2.99	-1.28	-8.21	-355.08	0.24	352,154.39	1,693,992.13	N 39°27'38.74"	W 80°41'24.33"
	570.00	1.08	251.45	569.91	3.05	-1.40	-8.52	-337.09	0.51	352,154.28	1,693,991.82	N 39°27'38.74"	W 80°41'24.33"
	652.00	1.16	241.36	661.90	3.24	-2.12	-10.16	-245.10	0.23	352,153.55	1,693,990.18	N 39°27'38.73"	W 80°41'24.35"
	732.00	1.27	230.29	731.88	3.13	-2.86	-11.38	-175.12	0.37	352,152.72	1,693,988.96	N 39°27'38.72"	W 80°41'24.37"
	821.00	2.80	208.56	820.82	1.83	-5.50	-13.18	-86.18	1.80	352,150.18	1,693,987.16	N 39°27'38.70"	W 80°41'24.39"
	911.00	2.99	212.26	910.71	-0.41	-8.41	-15.48	3.71	0.30	352,146.28	1,693,984.98	N 39°27'38.68"	W 80°41'24.42"
	1,000.00	3.39	214.60	909.57	-2.62	-13.54	-18.22	82.57	0.47	352,142.14	1,693,982.13	N 39°27'38.62"	W 80°41'24.46"
	1,090.00	3.13	213.76	1,089.42	-4.85	-17.78	-21.09	182.42	0.29	352,137.90	1,693,978.25	N 39°27'38.57"	W 80°41'24.49"
	1,179.00	2.70	208.13	1,178.31	-7.03	-21.65	-23.43	271.31	0.58	352,134.03	1,693,976.91	N 39°27'38.54"	W 80°41'24.52"
	1,268.00	2.83	203.15	1,269.20	-9.49	-25.56	-25.31	361.20	0.30	352,130.12	1,693,975.04	N 39°27'38.50"	W 80°41'24.54"
	1,358.00	2.63	198.61	1,357.10	-12.16	-29.51	-26.82	450.10	0.33	352,126.17	1,693,973.52	N 39°27'38.45"	W 80°41'24.57"
	1,448.00	2.61	198.56	1,447.01	-14.88	-33.41	-28.13	540.01	0.02	352,122.27	1,693,972.21	N 39°27'38.42"	W 80°41'24.58"
	1,537.00	3.21	218.03	1,535.90	-17.15	-37.30	-30.31	628.90	1.29	352,118.38	1,693,970.03	N 39°27'38.38"	W 80°41'24.61"
	1,627.00	3.59	220.62	1,625.74	-19.03	-41.42	-33.70	718.74	0.48	352,114.26	1,693,968.05	N 39°27'38.34"	W 80°41'24.65"
	1,716.00	2.99	223.03	1,714.59	-20.63	-45.23	-37.10	807.89	0.69	352,110.45	1,693,963.25	N 39°27'38.30"	W 80°41'24.69"
	1,806.00	1.83	230.09	1,804.51	-21.34	-47.69	-39.93	897.51	1.48	352,106.00	1,693,960.41	N 39°27'38.28"	W 80°41'24.73"
	1,895.00	2.27	232.49	1,893.45	-21.60	-49.49	-42.55	988.45	0.56	352,106.19	1,693,957.80	N 39°27'38.26"	W 80°41'24.76"
	1,985.00	2.23	234.84	1,983.38	-21.99	-51.58	-45.39	1,076.38	0.11	352,104.10	1,693,954.95	N 39°27'38.24"	W 80°41'24.80"
	2,075.00	2.58	232.90	2,073.30	-22.39	-53.81	-48.44	1,166.30	0.40	352,101.87	1,693,951.90	N 39°27'38.21"	W 80°41'24.83"
	2,164.00	2.89	240.93	2,162.20	-22.61	-56.11	-52.00	1,255.20	0.55	352,099.57	1,693,948.34	N 39°27'38.19"	W 80°41'24.88"
	2,254.00	2.62	230.70	2,252.10	-22.90	-58.52	-55.58	1,345.10	0.62	352,097.17	1,693,944.77	N 39°27'38.17"	W 80°41'24.92"
	2,344.00	2.23	230.30	2,342.02	-23.83	-61.16	-58.30	1,435.02	0.65	352,094.53	1,693,942.05	N 39°27'38.14"	W 80°41'24.95"
	2,433.00	2.23	216.71	2,430.95	-25.10	-63.86	-60.45	1,523.95	0.16	352,091.82	1,693,938.89	N 39°27'38.11"	W 80°41'24.99"
	2,523.00	2.51	224.40	2,520.87	-26.32	-66.68	-62.88	1,613.87	0.47	352,089.01	1,693,937.47	N 39°27'38.09"	W 80°41'25.02"
	2,612.00	2.54	220.33	2,609.79	-27.51	-69.57	-65.52	1,702.79	0.20	352,086.11	1,693,934.83	N 39°27'38.06"	W 80°41'25.05"
	2,702.00	2.53	222.77	2,699.70	-28.77	-72.55	-68.16	1,792.70	0.12	352,083.13	1,693,932.19	N 39°27'38.03"	W 80°41'25.08"
	2,792.00	2.89	222.82	2,789.60	-30.03	-75.67	-71.05	1,882.60	0.40	352,080.01	1,693,929.30	N 39°27'38.00"	W 80°41'25.12"
	2,882.00	2.74	222.93	2,879.49	-31.33	-78.91	-74.06	1,972.49	0.17	352,078.77	1,693,926.29	N 39°27'37.96"	W 80°41'25.16"
	2,972.00	2.61	216.78	2,969.44	-32.65	-82.20	-76.40	2,062.44	0.70	352,075.16	1,693,924.94	N 39°27'37.95"	W 80°41'25.17"
	3,062.00	2.59	216.58	3,018.35	-33.74	-85.94	-77.95	2,151.35	0.02	352,071.74	1,693,922.40	N 39°27'37.91"	W 80°41'25.21"
	3,111.00	4.42	217.15	3,108.17	-35.89	-88.34	-81.28	2,201.17	2.03	352,067.35	1,693,919.09	N 39°27'37.87"	W 80°41'25.25"
	3,200.00	6.51	218.37	3,196.76	-39.12	-95.09	-88.51	2,289.76	2.46	352,060.80	1,693,913.84	N 39°27'37.80"	W 80°41'25.31"
	3,200.00	8.59	215.94	3,285.96	-43.77	-104.59	-93.67	2,378.96	2.23	352,051.09	1,693,908.66	N 39°27'37.71"	W 80°41'25.40"
	3,300.00	10.96	218.21	3,374.70	-49.57	-116.52	-102.72	2,467.70	2.23	352,039.17	1,693,897.63	N 39°27'37.59"	W 80°41'25.52"
	3,400.00	12.79	216.52	3,461.86	-56.53	-130.84	-113.62	2,554.86	2.53	352,024.84	1,693,886.72	N 39°27'37.44"	W 80°41'25.65"
	3,500.00	14.89	214.56	3,549.24	-65.47	-148.37	-126.11	2,642.24	2.39	352,007.31	1,693,874.24	N 39°27'37.27"	W 80°41'25.81"
	3,600.00	17.11	216.18	3,635.75	-75.79	-158.99	-140.49	2,728.75	2.52	351,990.85	1,693,860.86	N 39°27'37.10"	W 80°41'25.99"
	3,700.00	18.52	216.90	3,720.48	-86.63	-170.45	-156.71	2,813.48	1.60	351,965.23	1,693,843.64	N 39°27'36.85"	W 80°41'26.19"
	3,820.00	20.87	220.33	3,805.21	-97.64	-214.11	-175.67	2,898.21	2.91	351,941.58	1,693,824.68	N 39°27'36.61"	W 80°41'26.41"
	3,917.00	22.52	222.17	3,887.90	-108.20	-238.83	-197.37	2,980.90	2.01	351,916.86	1,693,802.98	N 39°27'36.37"	W 80°41'26.70"
	4,007.00	22.75	221.82	3,970.57	-118.91	-264.57	-220.55	3,063.97	0.30	351,891.12	1,693,779.81	N 39°27'36.11"	W 80°41'26.99"
	4,097.00	23.71	222.19	4,053.67	-129.88	-290.95	-244.30	3,148.67	1.08	351,864.74	1,693,756.05	N 39°27'35.85"	W 80°41'27.29"
	4,186.00	24.14	222.13	4,135.03	-140.95	-317.71	-268.53	3,228.03	0.48	351,837.99	1,693,731.83	N 39°27'35.58"	W 80°41'27.60"
	4,276.00	25.70	221.52	4,216.65	-152.79	-345.97	-293.81	3,309.65	1.76	351,808.73	1,693,708.55	N 39°27'35.27"	W 80°41'27.91"
	4,365.00	28.98	224.17	4,295.70	-164.79	-375.89	-321.63	3,388.70	3.93	351,779.81	1,693,678.73	N 39°27'35.00"	W 80°41'28.26"
	4,455.00	32.08	224.42	4,373.21	-177.17	-408.61	-353.56	3,466.21	3.45	351,747.10	1,693,646.80	N 39°27'34.67"	W 80°41'28.69"
	4,545.00	36.00	224.97	4,447.77	-190.46	-444.40	-389.00	3,540.77	4.37	351,711.30	1,693,611.37	N 39°27'34.31"	W 80°41'29.11"
	4,634.00	38.67	224.50	4,517.95	-204.88	-483.27	-427.49	3,610.95	4.36	351,672.44	1,693,572.87	N 39°27'33.92"	W 80°41'29.59"
	4,724.00	37.13	221.66	4,588.39	-221.15	-524.15	-465.78	3,681.39	3.62	351,631.58	1,693,534.59	N 39°27'33.51"	W 80°41'30.07"
	4,814.00	36.30	220.66	4,661.20	-238.32	-564.17	-500.78	3,754.00	2.14	351,591.54	1,693,499.59	N 39°27'33.11"	W 80°41'30.51"
	4,903.00	36.46	220.29	4,733.11	-255.77	-603.85	-536.64	3,826.11	1.33	351,551.86	1,693,465.74	N 39°27'32.72"	W 80°41'30.94"
	4,993.00	37.41	220.79	4,805.05	-273.79	-644.95	-569.79	3,898.05	1.11	351,510.77	1,693,430.59	N 39°27'32.30"	W 80°41'31.38"
	5,083.00	38.13	222.42	4,876.19	-291.19	-686.16	-608.39	3,969.19	1.37	351,469.56	1,693,393.98	N 39°27'31.89"	W 80°41'31.84"
	5,173.00	39.42	223.36	4,946.36	-307.77	-727.45	-644.76	4,036.36	1.58	351,428.27	1,693,355.62	N 39°27'31.48"	W 80°41'32.32"
	5,262.00	39.49	222.32	5,015.08	-324.47	-768.92	-683.21	4,108.08	0.75	351,386.80	1,693,317.17	N 39°27'31.06"	W 80°41'32.81"
	5,352.00	38.68	220.13	5,084.84	-342.73	-811.59	-720.61	4,177.94	1.78	351,344.14	1,693,278.78	N 39°27'30.64"	W 80°41'33.27"
	5,442.00	37.72	220.01	5,155.66	-361.71	-854.18	-756.44	4,248.66	1.07	351,301.55	1,693,243.95	N 39°27'30.21"	W 80°41'33.72"
	5,531.00	38.5											

