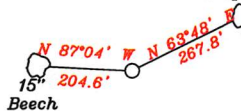


Sleepy 1B

17" Sugar
Maple

Notes:

- All wells within 500' of the horizontal leg are shown on this plat based upon information taken from DEP mapping, well plats, & aerial photos.
- Ties to wells and corners are based on State Plane Grid North-WV North Zone NAD 83.

— LEGEND —

- 500' from Bore Path
- Well Lateral
- Unit Boundary
- Lease Tracts
- Surface Tracts
- Well Bore Tracts

RECEIVED
Office of Oil and Gas

JUL 28 2025

WV Department of
Environmental ProtectionAs Drilled Leg
Proposed Leg

NUMBER	DIRECTION	DISTANCE
L1	S20°02'E	1,747.1'
L2	S27°02'W	2,717.6'

NUMBER	DIRECTION	DISTANCE	CURVE
L3	S34°33'W	1,311.1'	1,903.7'

Top Hole

Geo- 39.475448 N, 80.738896 W
UTM NAD 83(Meters)-4369572.20 N, 522457.40 E
UTM NAD 83(Feet)-14335838.14 N, 1714095.66 E

Landing Point

Geo- 39.472662 N, 80.741634 W
UTM NAD 83(Meters)-4369262.40 N, 522222.78 E
UTM NAD 83(Feet)-14334821.71 N, 1713325.89 E

Bottom Hole

Geo- 39.429678 N, 80.708676 W
UTM NAD 83(Meters)-4364500.63 N, 525072.97 E
UTM NAD 83(Feet)-14319199.16 N, 1722676.90 E

Top Hole

Geo- 39.475448 N, 80.738896 W
UTM NAD 83(Meters)-4369572.22 N, 522457.39 E
UTM NAD 83(Feet)-14335838.17 N, 1714095.62 E

Landing Point


Geo- 39.472455 N, 80.741477 W
UTM NAD 83(Meters)-4369239.45 N, 522236.36 E
UTM NAD 83(Feet)-14334746.44 N, 1713370.47 E

Bottom Hole

Geo- 39.430045 N, 80.708922 W
UTM NAD 83(Meters)-4364541.34 N, 525051.70 E
UTM NAD 83(Feet)-14319332.73 N, 1722607.10 E

3. No water wells were found within 250' of the well location. No dwellings or buildings were found within 625' from the center of the proposed pad. No perennial streams are located within 100' of LOD. No producing trout stream is located within 300' of LOD.

NORTH

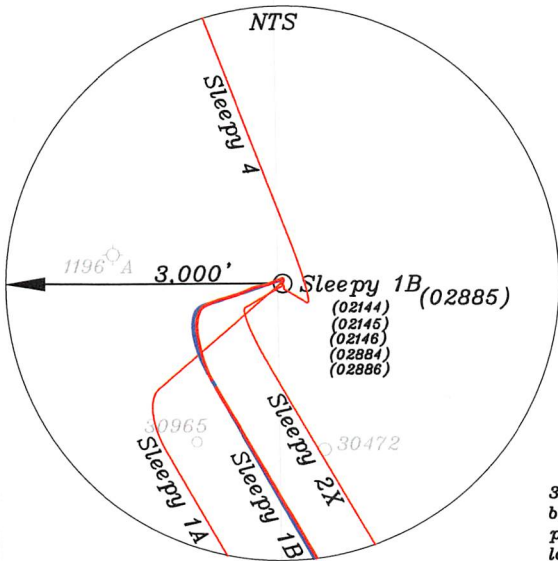

(+) DENOTES LOCATION OF WELL ON UNITED STATES TOPOGRAPHIC MAPS

FILE NO. _____
DRAWING NO. 1
SCALE 1" = 2000'
MINIMUM DEGREE OF
ACCURACY 1 in 200
PROVEN SOURCE OF
ELEVATION GPS
submeter unit


I THE UNDERSIGNED, HEREBY CERTIFY THAT
THIS PLAT IS CORRECT TO THE BEST OF MY
KNOWLEDGE AND BELIEF AND SHOWS ALL THE
INFORMATION REQUIRED BY LAW AND THE RULES
ISSUED AND PRESCRIBED BY THE DEPARTMENT
OF ENVIRONMENTAL PROTECTION.

(SIGNED)

David L Jackson

R.P.E.

P.S. 708

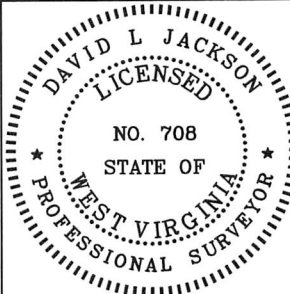

STATE OF WEST VIRGINIA
Division of Environmental Protection
OFFICE OF OIL AND GAS


DATE December 26, 2024OPERATOR'S WELL NO. Sleepy 1B

API WELL NO.


47 — 095 — 02885WELL TYPE: OIL GAS X LIQUID INJECTION WASTE DISPOSAL STATE 47 COUNTY 095 PERMIT 02885(IF "GAS") PRODUCTION X STORAGE DEEP SHALLOW XLOCATION: ELEVATION 1,112.8' WATER SHED Walnut Fork of Outlet Middle Island Creek (HUC-10)DISTRICT McElroy COUNTY TylerQUADRANGLE Center Point 7 1/2'SURFACE OWNER Brent A & Emma K Weimer ACREAGE 102 Ac.OIL & GAS ROYALTY OWNER Paula M. Byers, Et Al LEASE ACREAGE 102 Ac.LEASE NO. See Page 2PROPOSED WORK: DRILL CONVERT DRILL DEEPER REDRILL FRACTURE ORSTIMULATE PLUG OFF OLD FORMATION PERFORATE NEWFORMATION OTHER PHYSICAL CHANGE IN WELL (SPECIFY) As DrilledPLUG AND ABANDON CLEAN OUT AND REPLUGTARGET FORMATION Marcellus ESTIMATED DEPTH TVD = 7,040'; TMD = 25,591'WELL OPERATOR Jay-Bee Oil & Gas, Inc. DESIGNATED AGENT Deborah Broda-MorganADDRESS 16 South Avenue W, Ste 118, Cranford NJ 07016 ADDRESS 429 Simonton Road, Ellenboro, WV 26346LONGITUDE 80-42-30 W (TH) Top Hole 8,943'
LONGITUDE 80-42-30 W (BH) Bottom Hole 10,304'

08/29/2025


form ww6

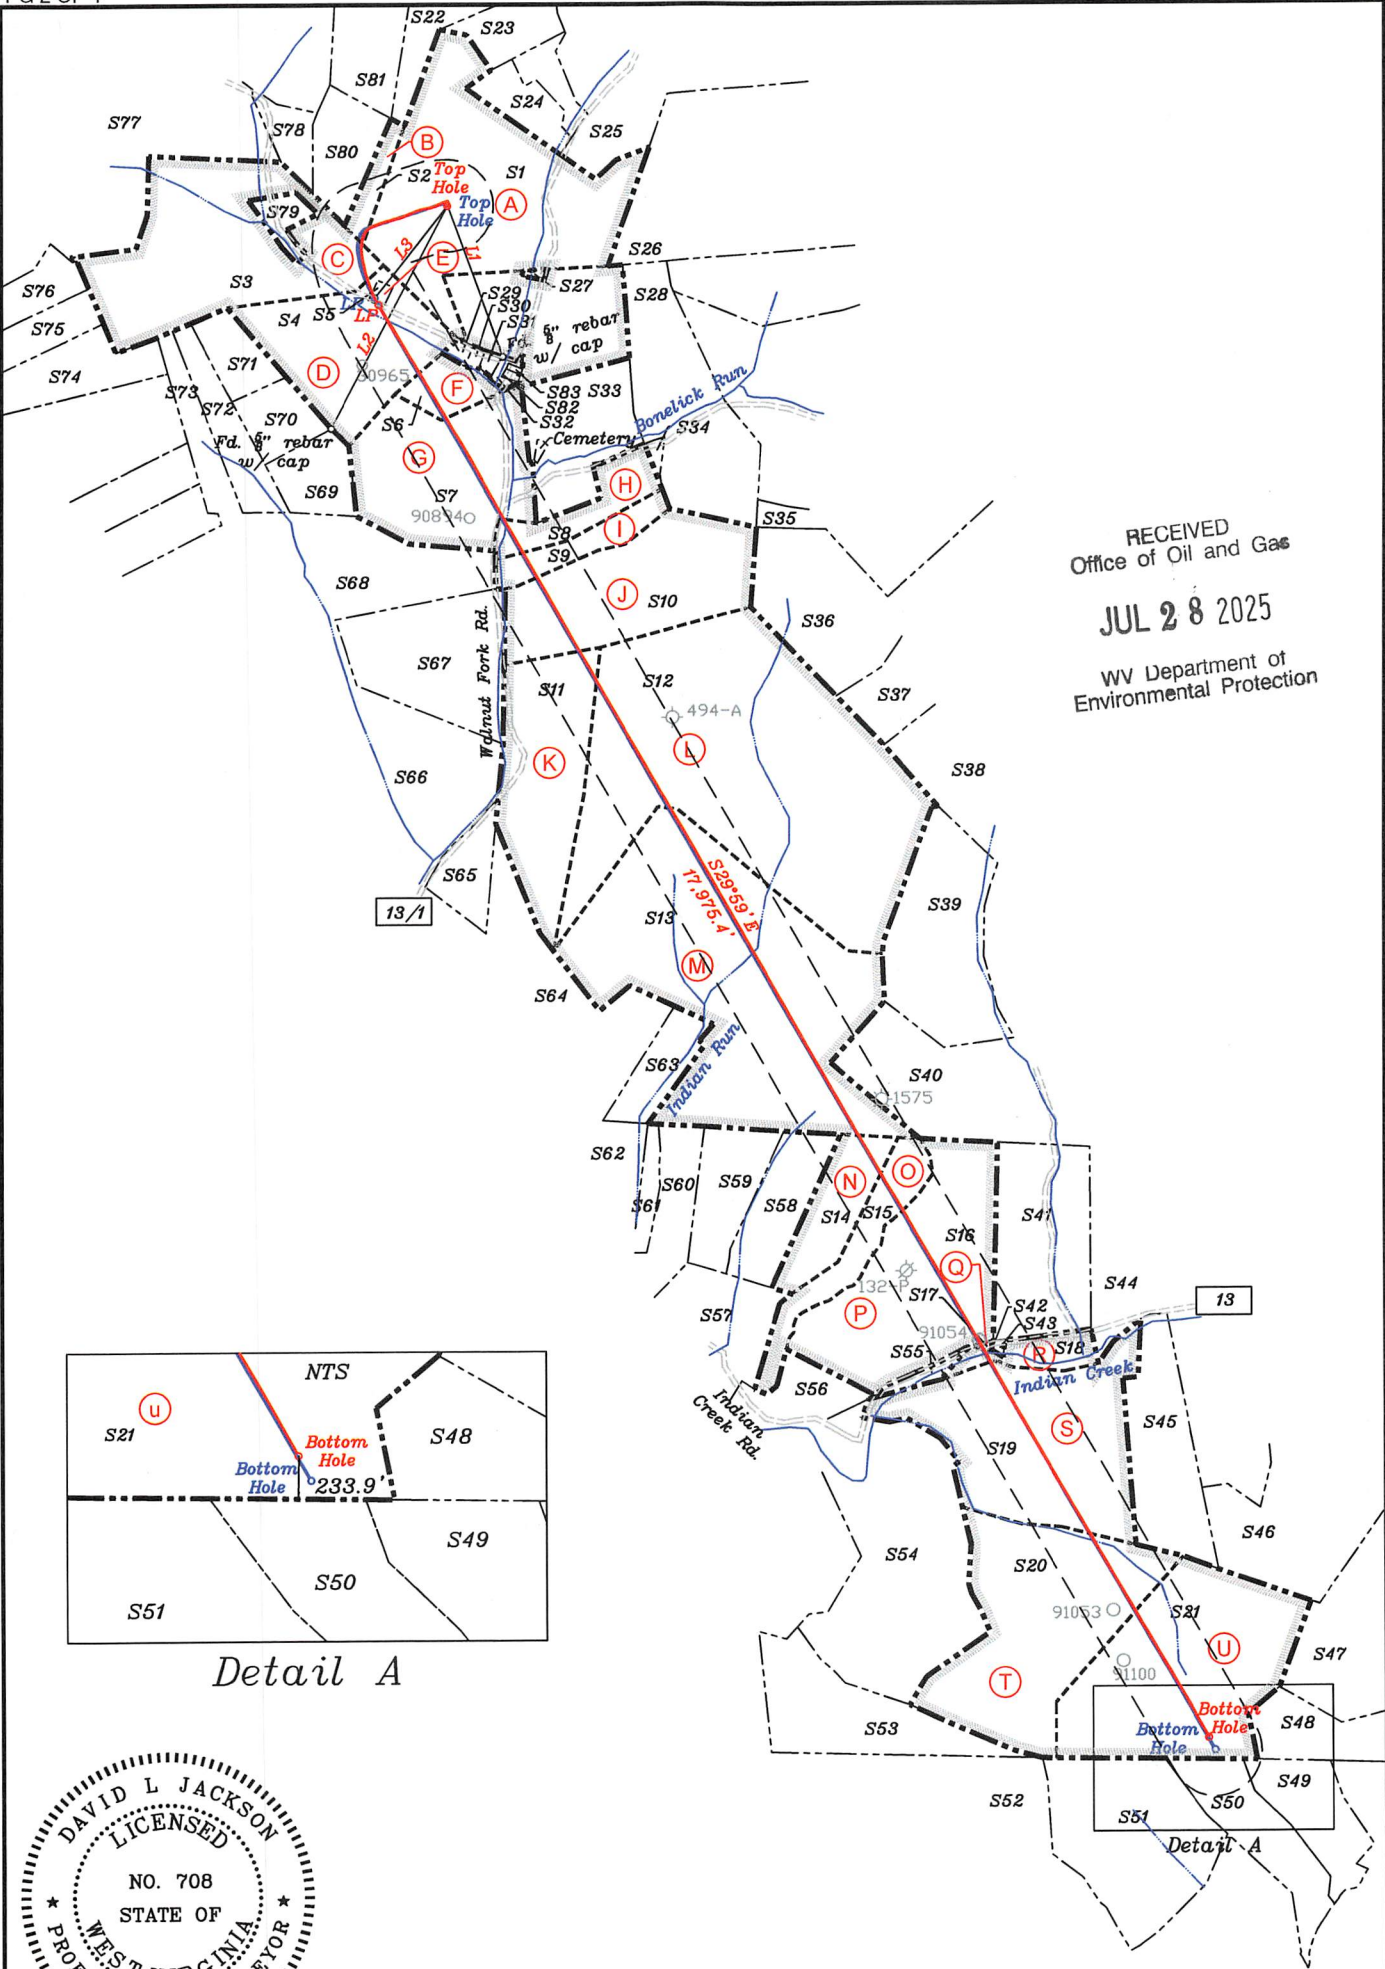

RECEIVED
Office of Oil and Gas
JUL 28 2025
WV Department of
Environmental Protection

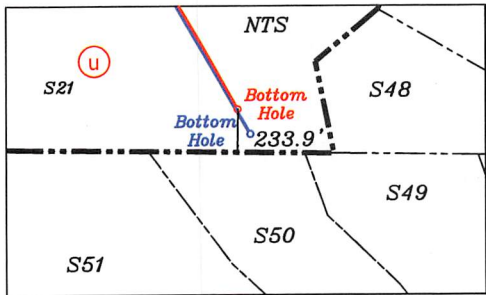


Detail A

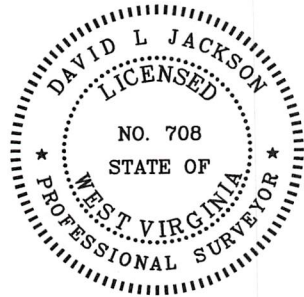

P.S. 708 *David L Jackson*



08/29/2025

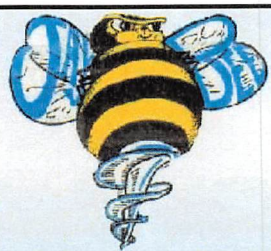

Jay Bee
Oil & Gas
DRILLING
into the future

API #: 47-095-02885
WELL #: SLEEPY 1B
DISTRICT: McELROY
COUNTY: TYLER
STATE: WV

WELL PLAT
PAGE 2 OF 4
DATE: 12/26/2024

RECEIVED
Office of Oil and Gas

JUL 28 2025

WV Department of
Environmental Protection



P.S. 708 *David L Jackson*

Tags	Number	Tax Map - Parcel	Surface Owner	Acres
A	S1	5-3-23	Brent A & Emma K Weimer	102
B	S2	5-3-22	Brent A & Emma K Weimer	6.22
C	S3	5-7-1.1	Jay-Bee Oil & Gas Inc	88.6
D	S4	5-7-1	Jay-Bee Royalty LLC	45.84
E	S5	5-7-1.2	Ronald E Thompson, Jarrett M Thompson	1
F	S6	5-7-8	Barbara A (Mead) Meade	59.728
G	S7	5-7-7	Ronald E & Janet R Thompson	68.38
H	S8	5-7-2.7	Ronald E & Janet R Thompson	16.5
I	S9	5-7-2.8	Freda L Thompson	16
J	S10	5-7-2.9	Douglas Allen Thomas	63.11
K	S11	5-7-40	Joseph M Pachuta	75.38
L	S12	5-7-40.1	Sabrina Ann Haught	200
M	S13	5-7-41	Dallison Lumber Inc	157.5
N	S14	5-12-1.5	Jerry L Walters	20.5
O	S15	5-12-1.6	Marian White (Life)	21.7
P	S16	5-12-20	Rover	80
Q	S17	5-12-32	Alvy Community Club	0.029
R	S18	5-12-31	Ascent Resources Marcellus Minerals LLC	10.423
S	S19	5-12-30	Larry R & Kim Henthorn- 1/2 Int & Ronald & Kayla Henthorn- 1/2 Int	95.7
T	S20	5-12-29	Larry R & Kim Henthorn- 1/2 Int & Ronald & Kayla Henthorn- 1/2 Int	77.84
U	S21	5-12-28	Larry R & Kim Henthorn- 1/2 Int & Ronald & Kayla Henthorn- 1/2 Int	107.14
	S22	5-3-5	Gregory Allen Rayburn	35.4
	S23	5-3-19	Coastal Forest Resources Co, Coastal Timberlands Co	9.96
	S24	5-3-24	Brent A & Emma K Weimer	13.05
	S25	5-3-17	Darrell & Marian Larsen Trust & Irene Fleck Trust UTD	50.38
	S26	5-3-2.5	Leo M & Nancy M Schumacher	134
	S27	5-7-8.6	Duane & Rebecca Thomas	0.52
	S28	5-7-10	Vickie L Tippins	55.75
	S29	5-7-8.4	Elia A Tippins	1.124
	S30	5-7-8.3	Vickie L Tippins	0.75
	S31	5-7-8.5	Barbara Ann Meade (Mead)	0.942
	S32	p/o 5-7-8	Eli Henthorn	1.372
	S33	5-7-9	Douglas & Suzan W Thomas	40
	S34	5-7-10.1	Glenda B Brooks & Victoria L Falcon	1.2
	S35	5-7-3.2	Douglas A & Suzan W Thomas	3.65
	S36	5-7-3.4	Samuel R Pflugh, Neal W Pflugh & Craig & Kathryn Felici	45.25
	S37	5-7-3.5	Vickie L Tippins-3/4 Int, Thomas H Headley Est-1/4 Int	15
	S38	5-7-4.3	WSD Properties LLC	12.5
	S39	5-7-4.2	Jeffrey A Davis	54
	S40	5-12-2.1	Jeffrey A Davis	62.26
	S41	5-12-20.1	Glen D Glover	49.311
	S42	5-12-31.1	Alvy Community Club	0.03
	S43	5-12-31.2	Alvy Community Club	0.387
	S44	5-12-2.5	Jeffrey D & Loretta A Winkle	25.49
	S45	5-12-2.7	(Lulu Spencer HRS) Margarette M Spencer, Ronald L Spencer, Rodney A Spencer & James Spencer	36
	S46	5-13-3.7	Barbara K Lemasters, Chad W Lemasters & Zoe Lemasters	32.2
	S47	5-13-3.6	Barbara K Lemasters, Chad W Lemasters & Zoe Lemasters	54
	S48	5-13-3.5	Dorsey Baker EST Et Al	139.81
	S49	5-5-3	Brandon M Cerullo	59.5
	S50	5-5-2	Robert L & Carrie L Wolfe (SURV)	56.71
	S51	5-5-1	Robert L Wolfe	58
	S52	5-17-3	Coastal Forest Resources Co	766
	S53	5-12-3.3	Jerry Walters	50
	S54	5-12-3.4	Larry R & Kim Henthorn- 1/2 Int & Ronald & Kayla Henthorn- 1/2 Int	96.69
	S55	5-12-3.6	Randy Lancaster, DBA Heritage Oil & Gas	1
	S56	5-12-1.9	Laura L Hill	14.75
	S57	5-12-1.7	Jerry L Walters	30.02
	S58	5-12-1.4.1	Jerry L Walters	23.02
	S59	5-12-1.4	Jerry L Walters	23.4
	S60	5-12-1.3	Douglas & Karen J Dosk	25.088
	S61	5-12-1.3.1	Gary Braucher	4.912
	S62	5-12-1.1	Gary Braucher	30
	S63	5-7-50	Joseph Pachuta	13
	S64	5-12-1.2	Joseph M Pachuta	73.5
	S65	5-7-3.8.1	Ronnie Dean Curtis Stevens Et Al	12.447
	S66	5-7-3.8	David A Sr & Connie L Griffin	143.78
	S67	5-7-2.6	Ronald Eugene & Janet Rae Thompson	50
	S68	5-7-2.5	Ronald E & Janet R Thompson	31.75
	S69	5-7-6	Ronald E & Janet R Thompson	11.66
	S70	5-7-5	Ronald E & Janet Thompson	11.66
	S71	5-7-4	Ronald E & Janet Thompson	11.66
	S72	5-7-3	Ronald E & Janet R Thompson	17.5
	S73	5-7-2	Ronald E & Janet R Thompson	17.5
	S74	5-6-1.7	Ronald E & Janet R Thompson	26.36
	S75	5-6-1.6	Gregory Allen Rayburn	15.82
	S76	5-6-1.5	Edgar Ronald McHenry Trust	15.81
	S77	5-2-2.6	Dwight Lemasters Et Al	87.06
	S78	5-3-20	Eli J Henthorn & Alpheus Tennant HRS	15
	S79	5-7-1.3	Thompson Ronald E	5
	S80	5-3-2.1	Eli Henthorn	18.66
	S81	5-3-3	Edgen Ronald McHenry Trust	37.79
	S82	5-7-8.1	Eli Henthorn	0.5
	S83	No Tax ID	Board of Education	

08/29/2025



Jay Bee
Oil & Gas

DRILLING
into the future

API #: 47-095-02885
WELL #: SLEEPY 1B
DISTRICT: McELROY
COUNTY: TYLER
STATE: WV

WELL PLAT
PAGE 3 OF 4
DATE: 12/26/2024

form ww6

Jay-Bee Oil & Gas, Inc. - Sleepy 1B Permit - WW-6A1 Exhibit					
Tract	District Tax Map/Parcel	JB Tract #	Lessor, Grantor, Etc.	Deed Book/Page	Acres
A	05-3-23	T3036	Paula M. Byers et al	390/838	102
B	05-3-22	T3076C	Richard D. Tustin et al	390/838	6.220
C	05-7-1.1	T3043B	Marian Lea Buck et al	406/803	88.6
D	05-7-1	T3043C	Five Star Resources et al	131/205	45.84
E	05-7-1.2	T3043C	Marian Lea Buck et al	406/803	1.000
F	05-7-8	T1-08	OXY USA, Inc. et al	399/183	59.728
G	05-7-7	T3037	Terry Bennett et al	369/300	68.38
H	05-7-27	T3035B	Emmanuel Baptist Church of New Martinsville et al	389/391	16.500
I	05-7-28	T3035B	Rebecca L. Albanese et al	390/444	16.000
J	05-7-29	T3034	Douglas A. or Suzan W. Thomas et al	450/668	63.770
K	05-7-40	T3022	Barbara J. Gibson Yoak et al	298/1	75.38
L	05-7-40.1	T3022	Barbara J. Gibson Yoak et al	298/1	200
M	05-7-41	T3012, T3012A	Nancy L. Rittenour et al	301/114 301/119	157.5
N	05-12-15	T3011	Paul Brunner Estate et al	485/197	20.5
O	05-12-16	T3011	James L. Walters et al	406/694	21.7
P	05-12-20	T3011C	Waco Oil & Gas Company, Inc. et al	401/442	80
Q	05-12-32	Tri2	Joseph McCormick et al	23/16	0.029
R	05-12-31	W701pt1	Sharon Foell et al	396/234	10.423
S	05-12-30	W701B	Elisabeth Moy Wilkerson et al	624/252	95.7
T	05-12-29	W701	Sharon Lou Foell et al	396/234	77.84
U	05-12-28	T3007C1	Harold S. & Calantha Anne Yost et al	393/333	107.1

RECEIVED
Office of Oil and Gas

JUL 28 2025

WV Department of
Environmental Protection



P.S.
708

David L Jackson

08/29/2025



Jay Bee
Oil & Gas

DRILLING
into the future

API #: 47-095-02885
WELL #: SLEEPY 1B
DISTRICT: McELROY
COUNTY: TYLER
STATE: WV

WELL PLAT

PAGE 4 OF 4

DATE: 12/26/2024

References:

Sleepy 1B

17" Sugar
MapleN 87°04' W N 63°48' E
15" 204.6' 267.8'
Beech

FORM WW-6

LATITUDE 39-27-30 N (BH)

Bottom Hole 166'

Notes:


1. All wells within 500' of the horizontal leg are shown on this plat based upon information taken from DEP mapping, well plats, & aerial photos.
2. Ties to wells and corners are based on State Plane Crd North-WV North Zone NAD 83.

— LEGEND —

- 500' from Bore Path
- - - - Well Lateral
- · - · - Unit Boundary
- - - - Lease Tracts
- - - - Surface Tracts
- (A) Well Bore Tracts

As Drilled Leg

Proposed Leg

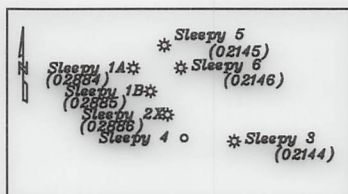

NUMBER	DIRECTION	DISTANCE
L1	S20°02'E	1,747.1'
L2	S27°02'W	2,717.6'

NUMBER	DIRECTION	DISTANCE	CURVE
L3	S34°33'W	1,311.1'	1,903.7'

Top Hole

Geo- 39.475448 N, 80.738896 W
UTM NAD 83(Meters)-4369572.20 N, 522457.40 E
UTM NAD 83(Feet)-14335838.14 N, 1714095.66 E

Landing Point

Geo- 39.472662 N, 80.741634 W
UTM NAD 83(Meters)-4369262.40 N, 522222.78 E
UTM NAD 83(Feet)-14334821.71 N, 1713325.89 E

Bottom Hole

Geo- 39.429678 N, 80.708676 W
UTM NAD 83(Meters)-4364500.63 N, 525072.97 E
UTM NAD 83(Feet)-14319199.16 N, 1722676.90 E

Top Hole

Geo- 39.475448 N, 80.738896 W
UTM NAD 83(Meters)-4369572.22 N, 522457.39 E
UTM NAD 83(Feet)-14335838.17 N, 1714095.62 E

Landing Point


Geo- 39.472455 N, 80.741477 W
UTM NAD 83(Meters)-4369239.45 N, 522236.36 E
UTM NAD 83(Feet)-14334746.44 N, 1713370.47 E

Bottom Hole

Geo- 39.430045 N, 80.708922 W
UTM NAD 83(Meters)-4364541.34 N, 525051.70 E
UTM NAD 83(Feet)-14319332.73 N, 1722607.10 E

3. No water wells were found within 250' of the well location. No dwellings or buildings were found within 625' from the center of the proposed pad. No perennial streams are located within 100' of LOD. No producing trout stream is located within 300' of LOD.

NORTH

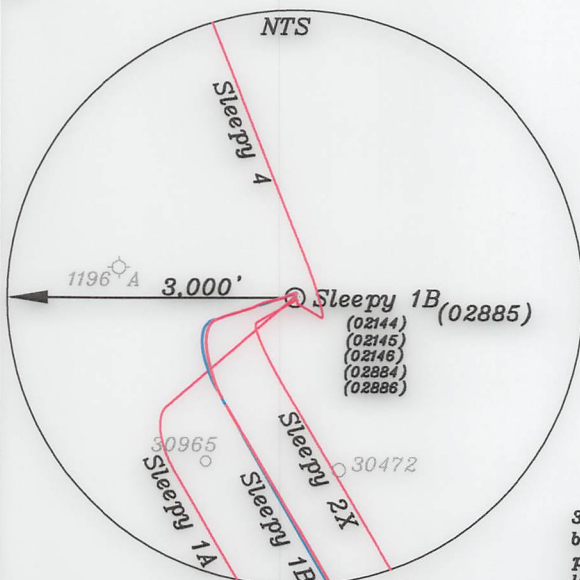TH
7 1/2'

(+) DENOTES LOCATION OF WELL ON UNITED STATES TOPOGRAPHIC MAPS

FILE NO. _____
DRAWING NO. 1
SCALE 1" = 2000'
MINIMUM DEGREE OF
ACCURACY 1 in 200
PROVEN SOURCE OF
ELEVATION GPS
submeter unit


I THE UNDERSIGNED, HEREBY CERTIFY THAT
THIS PLAT IS CORRECT TO THE BEST OF MY
KNOWLEDGE AND BELIEF AND SHOWS ALL THE
INFORMATION REQUIRED BY LAW AND THE RULES
ISSUED AND PRESCRIBED BY THE DEPARTMENT
OF ENVIRONMENTAL PROTECTION.

(SIGNED)

David L Jackson

R.P.E.

P.S. 708

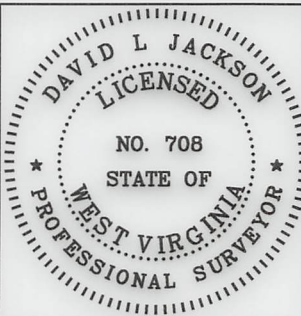

STATE OF WEST VIRGINIA
Division of Environmental Protection
OFFICE OF OIL AND GAS

DATE December 26, 2024OPERATOR'S WELL NO. Sleepy 1B
API WELL NO.

WELL TYPE: OIL GAS X LIQUID INJECTION WASTE DISPOSAL STATE COUNTY PERMIT
(IF "GAS") PRODUCTION X STORAGE DEEP SHALLOW X
LOCATION: ELEVATION 1,112.8' WATER SHED Walnut Fork of Outlet Middle Island Creek (HUC-10)
DISTRICT McElroy COUNTY Tyler
QUADRANGLE Center Point 7 1/2'

SURFACE OWNER Brent A & Emma K WeimerACREAGE 102 Ac.OIL & GAS ROYALTY OWNER Paula M. Byers, Et AlLEASE ACREAGE 102 Ac.LEASE NO. See Page 2

PROPOSED WORK: DRILL CONVERT DRILL DEEPER REDRILL FRACTURE OR
STIMULATE PLUG OFF OLD FORMATION PERFORATE NEW
FORMATION OTHER PHYSICAL CHANGE IN WELL (SPECIFY) As Drilled

PLUG AND ABANDON CLEAN OUT AND REPLUG

TARGET FORMATION Marcellus ESTIMATED DEPTH TVD = 7,040'; TMD = 25,591'WELL OPERATOR Jay-Bee Oil & Gas, Inc.DESIGNATED AGENT Deborah Broda-MorganADDRESS 16 South Avenue W, Ste 118, Cranford NJ 07016 ADDRESS 429 Simonton Road, Ellenboro, WV 26346BH
7 1/2'

(BH)

W

80-42-30

W

LONGITUDE

80-42-30

W















A circular professional seal for a surveyor. The outer ring contains the text "DAVID L JACKSON" at the top and "PROFESSIONAL SURVEYOR" at the bottom, separated by two stars. The inner circle contains the text "LICENSED" at the top, "NO. 708" in the center, and "STATE OF WEST VIRGINIA" at the bottom.

David L Jackson

API #: 47-095-02885
WELL #: SLEEPY 1B
DISTRICT: McELROY
COUNTY: TYLER
STATE: WV

DATE: 12/26/2024

Tags	Number	Tax Map -Parcel	Surface Owner	Acres
A	S1	5-3-23	Brent A & Emma K Weimer	102
B	S2	5-3-22	Brent A & Emma K Weimer	6.22
C	S3	5-7-1.1	Jay-Bee Oil & Gas Inc	88.6
D	S4	5-7-1	Jay-Bee Royalty LLC	45.84
E	S5	5-7-1.2	Ronald E Thompson, Jarrett M Thompson	1
F	S6	5-7-8	Barbara A (Mead) Meade	59.728
G	S7	5-7-7	Ronald E & Janet R Thompson	68.38
H	S8	5-7-27	Ronald E & Janet R Thompson	16.5
I	S9	5-7-28	Freda L. Thompson	16
J	S10	5-7-29	Douglas Allen Thomas	63.11
K	S11	5-7-40	Joseph M Pachuta	75.38
L	S12	5-7-40.1	Sabrina Ann Haight	200
M	S13	5-7-41	Dallison Lumber Inc	157.5
N	S14	5-12-15	Jerry L Walters	20.5
O	S15	5-12-16	Marian White (Life)	21.7
P	S16	5-12-20	Rover	80
Q	S17	5-12-32	Alvy Community Club	0.029
R	S18	5-12-31	Ascent Resources Marcellus Minerals LLC	10.423
S	S19	5-12-30	Larry R & Kim Henthorn- 1/2 Int & Ronald & Kayla Henthorn- 1/2 Int	95.7
T	S20	5-12-29	Larry R & Kim Henthorn- 1/2 Int & Ronald & Kayla Henthorn- 1/2 Int	77.84
U	S21	5-12-28	Larry R & Kim Henthorn- 1/2 Int & Ronald & Kayla Henthorn- 1/2 Int	107.14
	S22	5-3-5	Gregory Allen Rayburn	35.4
	S23	5-3-19	Coastal Forest Resources Co, Coastal Timberlands Co	9.96
	S24	5-3-24	Brent A & Emma K Weimer	13.05
	S25	5-3-17	Darrell & Marian Larsen Trust & Irene Fleck Trust UTD	50.38
	S26	5-3-25	Leo M & Nancy M Schumacher	134
	S27	5-7-8.6	Duane & Rebecca Thomas	0.52
	S28	5-7-10	Vickie L Tippins	55.75
	S29	5-7-8.4	Elia A Tippins	1.124
	S30	5-7-8.3	Vickie L Tippins	0.75
	S31	5-7-8.5	Barbara Ann Meade (Mead)	0.942
	S32	p/o 5-7-8	Eli Henthorn	1.372
	S33	5-7-9	Douglas & Suzan W Thomas	40
	S34	5-7-10.1	Glenda B Brooks & Victoria L Falcon	1.2
	S35	5-7-32	Douglas A & Suzan W Thomas	3.65
	S36	5-7-34	Samuel R Pflugh, Neal W Pflugh & Craig & Kathryn Felici	45.25
	S37	5-7-35	Vickie L Tippins-3/4 Int, Thomas H Headley Est-1/4 Int	15
	S38	5-7-43	WSD Properties LLC	125
	S39	5-7-42	Jeffrey A Davis	54
	S40	5-12-21	Jeffrey A Davis	62.26
	S41	5-12-20.1	Glen D Glover	49.311
	S42	5-12-31.1	Alvy Community Club	0.03
	S43	5-12-31.2	Alvy Community Club	0.387
	S44	5-12-25	Jeffrey D & Loretta A Winkle	25.49
	S45	5-12-27	(Lulu Spencer HRS) Margarette M Spencer, Ronald L Spencer, Rodney A Spencer & James Spencer	36
	S46	5-13-37	Barbara K Lemasters, Chad W Lemasters & Zoe Lemasters	32.2
	S47	5-13-36	Barbara K Lemasters, Chad W Lemasters & Zoe Lemasters	54
	S48	5-13-35	Dorsey Baker EST Et Al	139.81
	S49	5-5-3	Brandon M Cerullo	59.5
	S50	5-5-2	Robert L & Carrie L Wolfe (SURV)	56.71
	S51	5-5-1	Robert L Wolfe	58
	S52	5-17-3	Coastal Forest Resources Co	766
	S53	5-12-33	Jerry Walters	50
	S54	5-12-34	Larry R & Kim Henthorn- 1/2 Int & Ronald & Kayla Henthorn- 1/2 Int	96.69
	S55	5-12-36	Randy Lancaster, DBA Heritage Oil & Gas	1
	S56	5-12-19	Laura L Hill	14.75
	S57	5-12-17	Jerry L Walters	30.02
	S58	5-12-14.1	Jerry L Walters	23.02
	S59	5-12-14	Jerry L Walters	23.4
	S60	5-12-13	Douglas & Karen J Doak	25.088
	S61	5-12-13.1	Gary Braucher	4.912
	S62	5-12-11	Gary Braucher	30
	S63	5-7-50	Joseph Pachuta	13
	S64	5-12-12	Joseph M Pachuta	73.5
	S65	5-7-38.1	Ronnie Dean Curtis Stevens Et Al	12.447
	S66	5-7-38	David A Sr & Connie L Griffin	143.78
	S67	5-7-26	Ronald Eugene & Janet Rae Thompson	50
	S68	5-7-25	Ronald E & Janet R Thompson	31.75
	S69	5-7-6	Ronald E & Janet R Thompson	11.66
	S70	5-7-5	Ronald E & Janet Thompson	11.66
	S71	5-7-4	Ronald E & Janet Thompson	11.66
	S72	5-7-3	Ronald E & Janet R Thompson	17.5
	S73	5-7-2	Ronald E & Janet R Thompson	17.5
	S74	5-6-17	Ronald E & Janet R Thompson	26.36
	S75	5-6-16	Gregory Allen Rayburn	15.82
	S76	5-6-15	Edgar Ronald McHenry Trust	15.81
	S77	5-2-26	Dwight Lemasters Et Al	87.06
	S78	5-3-20	Eli J Henthorn & Alpheus Tennant HRS	15
	S79	5-7-1.3	Thompson Ronald E	5
	S80	5-3-21	Eli Henthorn	18.66
	S81	5-3-3	Edgen Ronald McHenry Trust	37.79
	S82	5-7-8.1	Eli Henthorn	
	S83	No Tax ID	Board of Education	

08/29/2025



P.S. 708
David L Jackson



Jay Bee
Oil & Gas
DRILLING
into the future

API #: 47-095-02885
WELL #: SLEEPY 1B
DISTRICT: McELROY
COUNTY: TYLER
STATE: WV

WELL PLAT
PAGE 3 OF 4
DATE: 12/26/2024

Jay-Bee Oil & Gas, Inc. - Sleepy 1B Permit - WW-6A1 Exhibit					
Tract	District Tax Map/Parcel	JB Tract #	Lessor, Grantor, Etc.	Deed Book/Page	Acres
A	05-3-23	T3036	Paula M. Byers et al	390/838	102
B	05-3-22	T3076C	Richard D. Tustin et al	390/838	6.220
C	05-7-1.1	T3043B	Marian Lea Buck et al	406/803	88.6
D	05-7-1	T3043C	Five Star Resources et al	131/205	45.84
E	05-7-1.2	T3043C	Marian Lea Buck et al	406/803	1.000
F	05-7-8	T1-08	OXY USA, Inc. et al	399/183	59.728
G	05-7-7	T3037	Terry Bennett et al	369/300	68.38
H	05-7-27	T3035B	Emmanuel Baptist Church of New Martinsville et al	389/391	16.500
I	05-7-28	T3035B	Rebecca L. Albanese et al	390/444	16.000
J	05-7-29	T3034	Douglas A. or Suzan W. Thomas et al	450/668	63.770
K	05-7-40	T3022	Barbara J. Gibson Yoak et al	298/1	75.38
L	05-7-40.1	T3022	Barbara J. Gibson Yoak et al	298/1	200
M	05-7-41	T3012, T3012A	Nancy L. Rittenour et al	301/114 301/119	157.5
N	05-12-15	T3011	Paul Brunner Estate et al	485/197	20.5
O	05-12-16	T3011	James L. Walters et al	406/694	21.7
P	05-12-20	T3011C	Waco Oil & Gas Company, Inc. et al	401/442	80
Q	05-12-32	Tri2	Joseph McCormick et al	23/16	0.029
R	05-12-31	W701pt1	Sharon Foell et al	396/234	10.423
S	05-12-30	W701B	Elisabeth Moy Wilkerson et al	624/252	95.7
T	05-12-29	W701	Sharon Lou Foell et al	396/234	77.84
U	05-12-28	T3007C1	Harold S. & Calantha Anne Yost et al	393/333	107.1



P.S.
708

David L Jackson

08/29/2025



Jay Bee
Oil & Gas

DRILLING
into the future

API #:	47-095-02885
WELL #:	SLEEPY 1B
DISTRICT:	McELROY
COUNTY:	TYLER
STATE:	WV

WELL PLAT
PAGE 4 OF 4
DATE: 12/26/2024