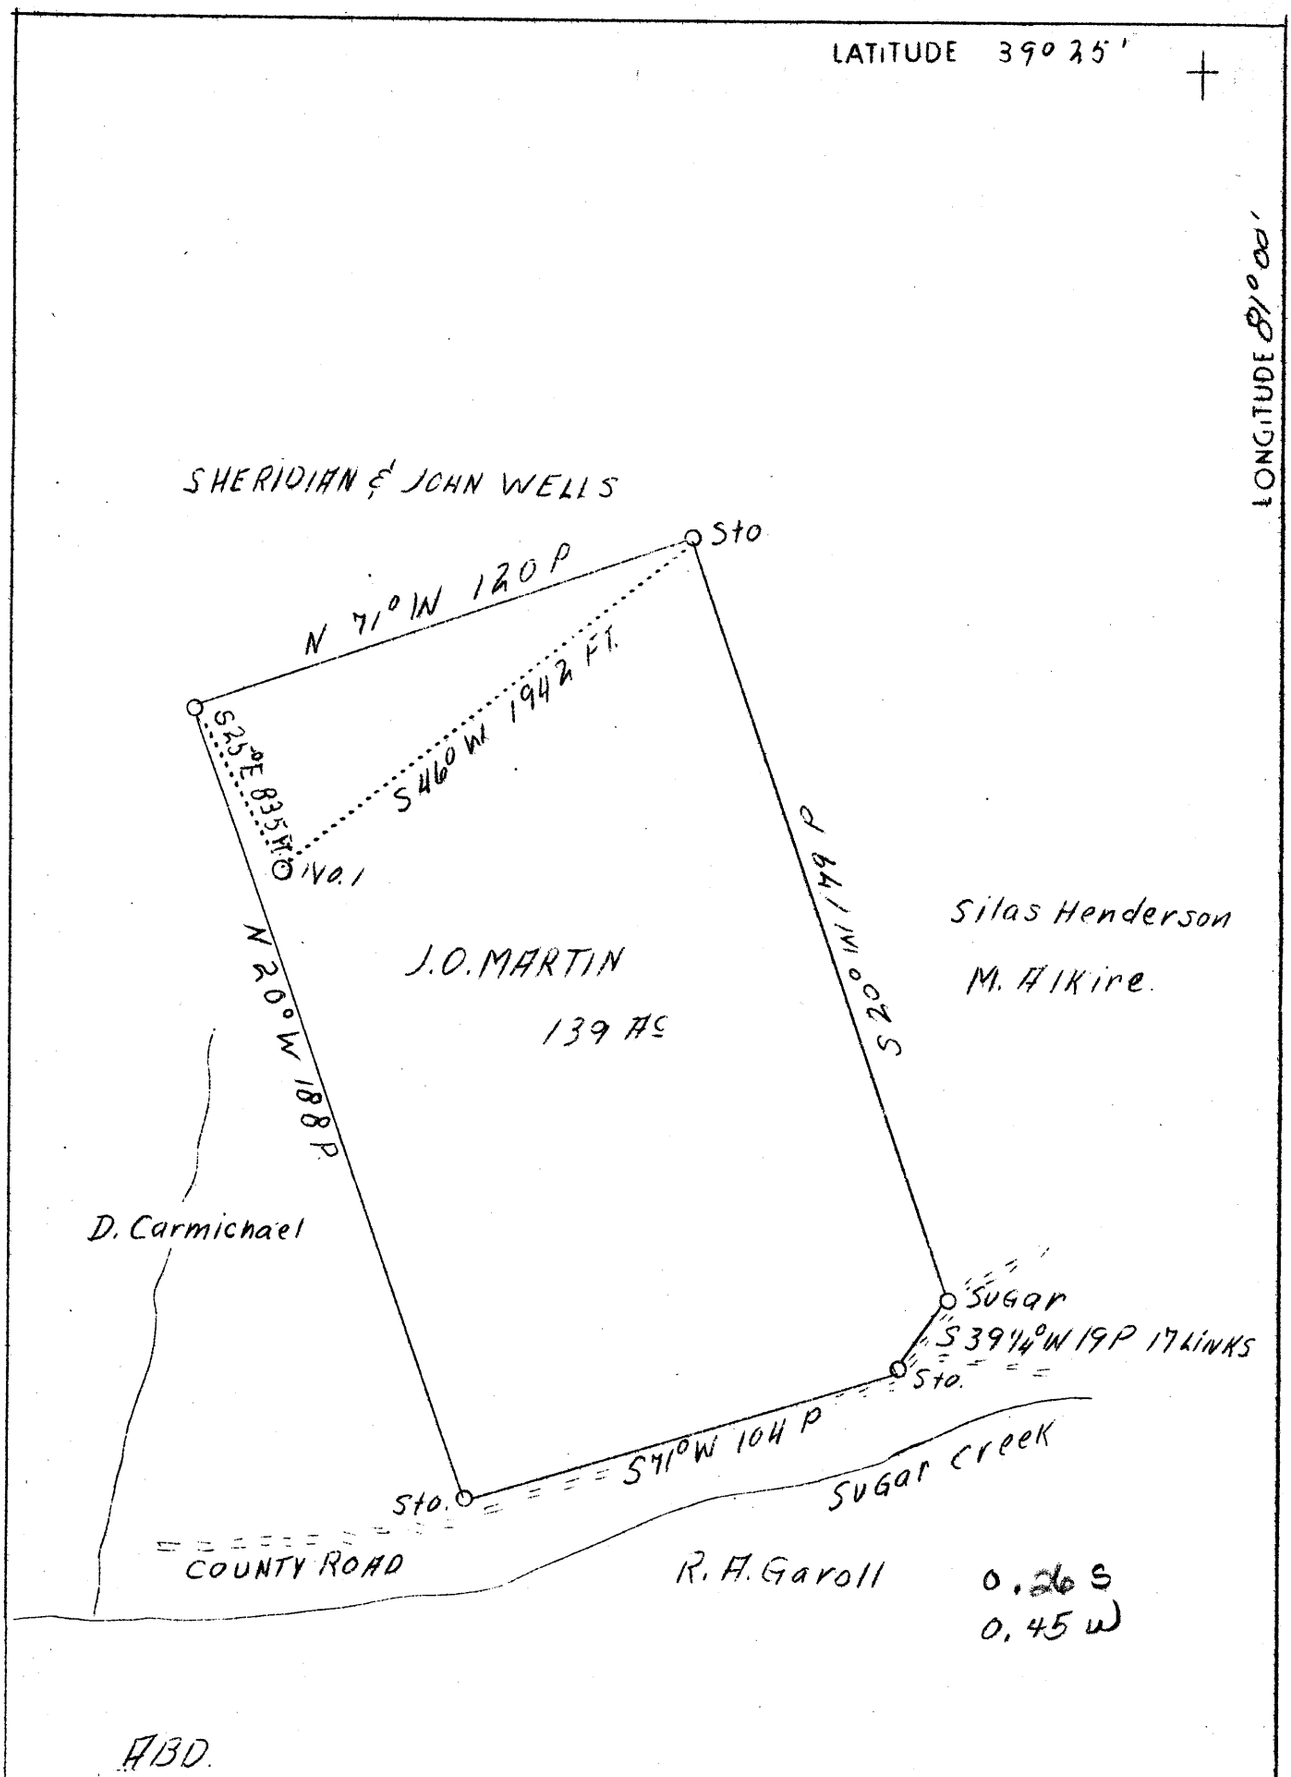


ABD.

| | |
|---|---|
| Company | C asto Oil Co. |
| Address | Charleston, W.Va. |
| Farm | J. O. Martin |
| Tract | 10 |
| Acres | 139 |
| Well(Farm)No. | 1 |
| El.(Sp. L.) | 790 |
| Quadrangle | St. Mary's E |
| County | Tyler |
| District | Meade |
| Eng. | J. V. Dunbar |
| Eng. reg. No. | 65 |
| File No. | C 23 - L - |
| Date | 4/16/39 |
| Scale | 1" - 40 Rds. |

STATE OF WEST VIRGINIA
Department of Mines
OIL AND GAS DIVISION
Charleston

WELL LOCATION MAP

File No. TYI-203-A

x Denotes location of well on U.S. Topographic Maps, scale 1 to 62,500, latitude and longitude lines being represented by border lines as shown.

- Denotes one inch spaces on border line of original tracing.