LATITUDE 39° 35'

LONGITUDE 80° 45'

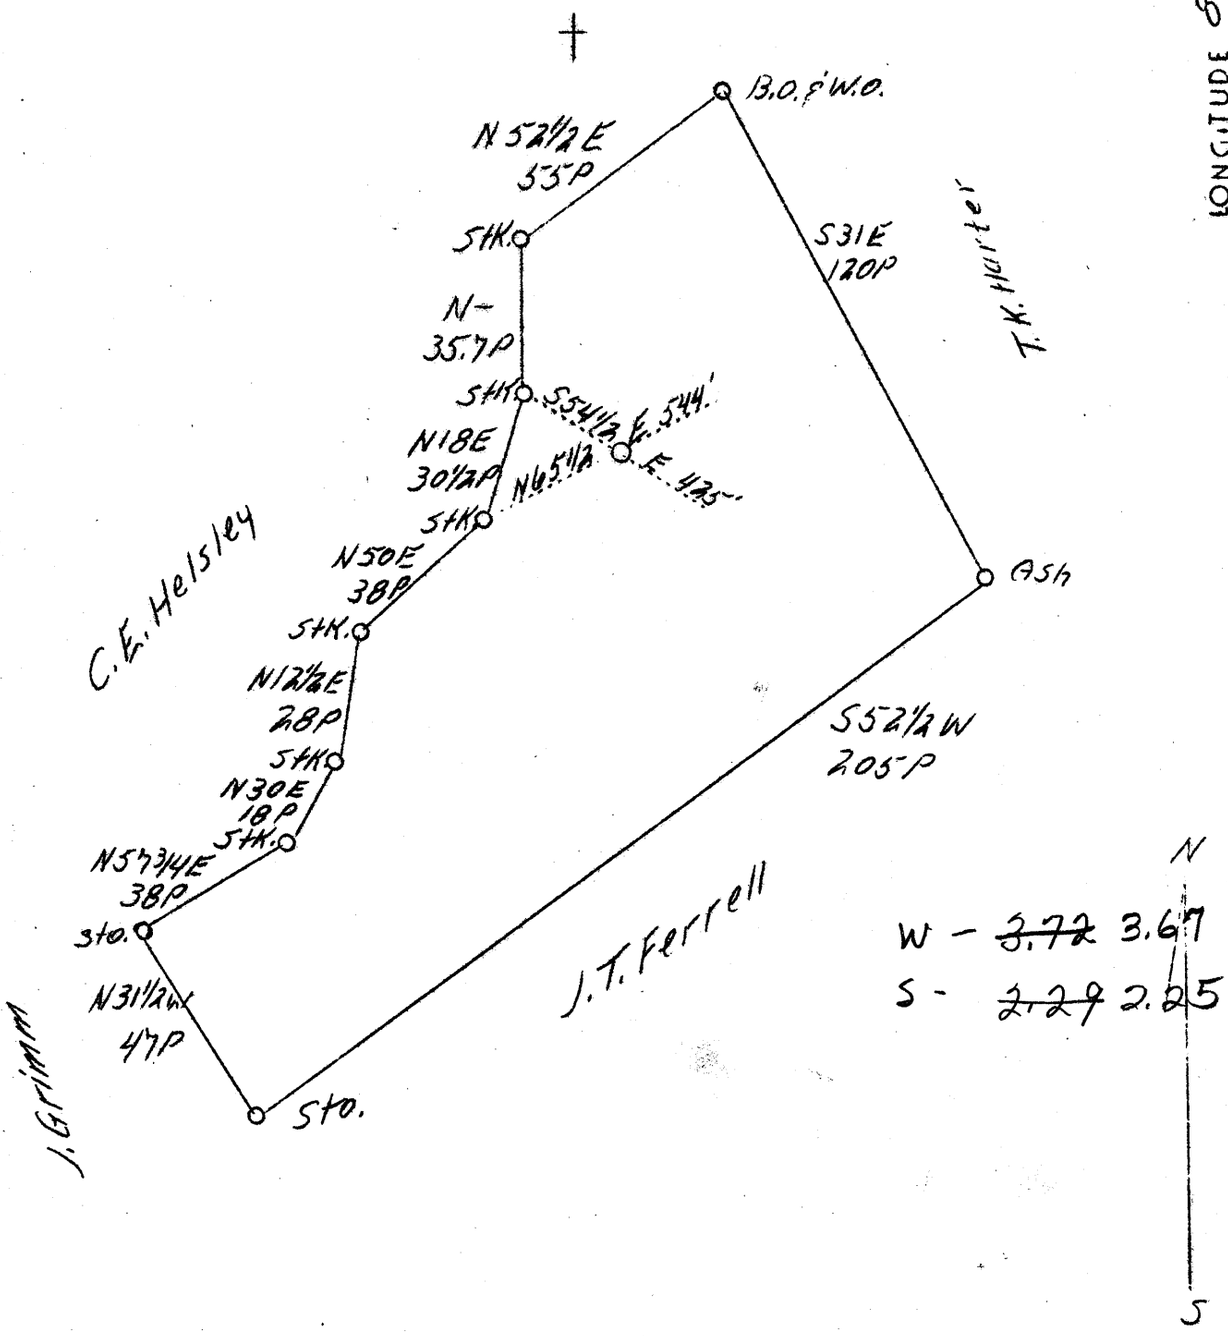

ABD.

Sheet No 2

Company	McIntyre & Wright
Address	Alvy, W. Va.
Farm	C. E. Helsley
Tract	1
Acres	98
Well (Farm) No.	1
Elevation (SL)	1117
Quadrangle	New Martinsville SE
County	Tyler
District	Ellsworth
Engineer	J. S. Haught
Eng. Reg. No.	Co. Surveyor
Date	August 15, 1939
Scale	1" - 40 rods

STATE OF WEST VIRGINIA
Department of Mines
OIL & GAS DIVISION
Charleston

WELL LOCATION MAP

File No. TVI-209-A

x Denotes location of well on U. S. Topographic Maps, scale 1 to 62,500, latitude and longitude lines being represented by border lines as shown.

- Denotes one inch spaces on border line of original tracing.