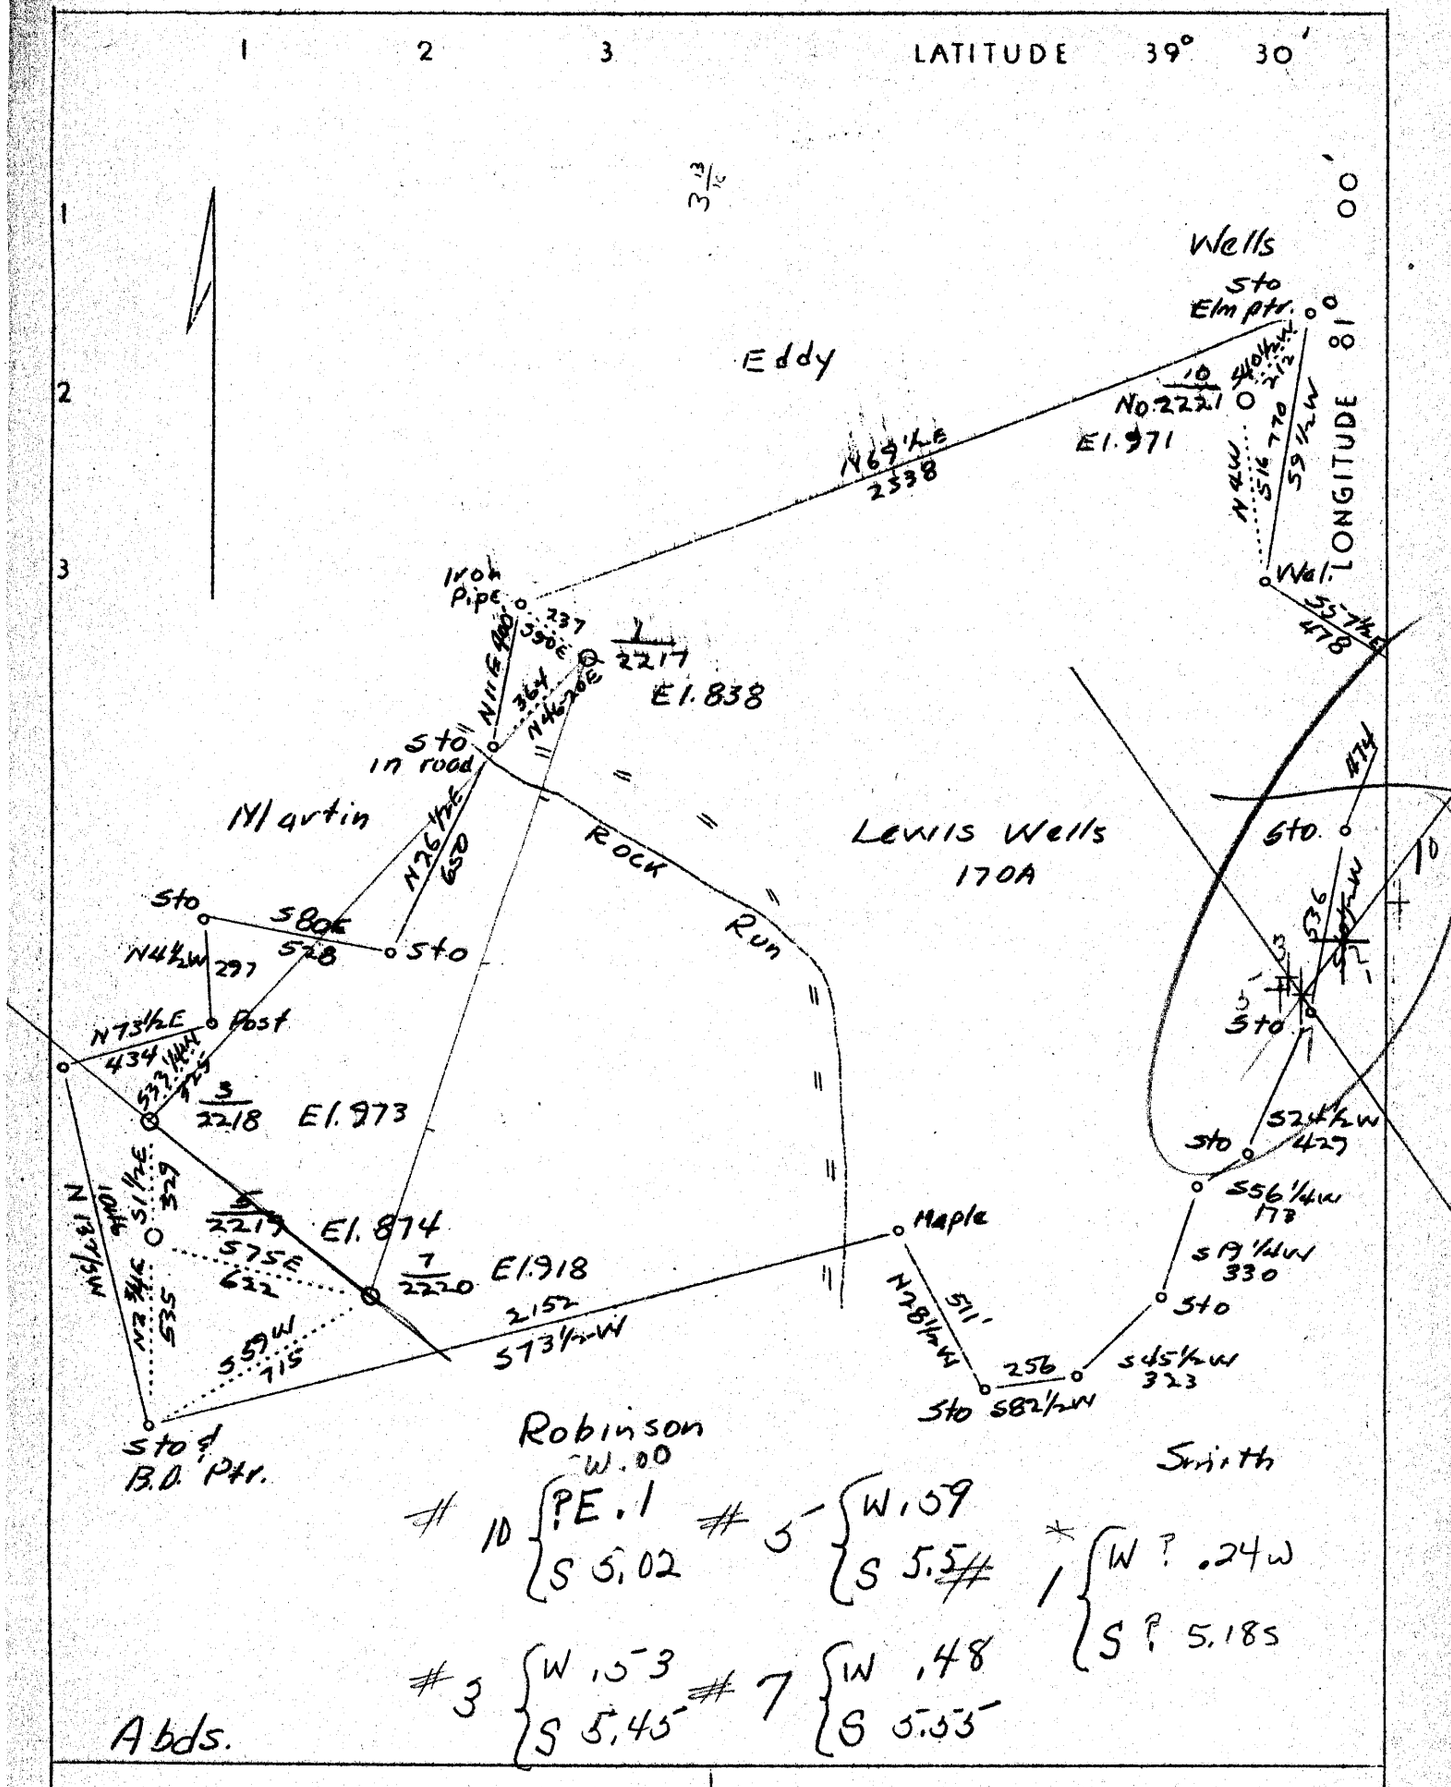

Company	F. S. Deem
Address	Harrisville, W. Va.
Farm	Lewis Wells
Acres	170
Well (Farm) No.	1, 3, 5, 7 and 10
Elevation (SL)	838, 973, 874, 918 & 971
Quadrangle	St. Marys NE.
County	Tyler
District	Meade
Engineer	B. F. Rinehart
Eng. Reg. No.	648
Drawing No.	206-M-T
Date	Sept. 30, 1939
Scale	1" - 500'

STATE OF WEST VIRGINIA
Department of Mines
OIL & GAS DIVISION
Charleston

WELL LOCATION MAP

File No. TYL-229 to 233A
INCLUSIVE

x Denotes location of well on U. S. Topographic Maps, scale 1 to 62,500, latitude and longitude lines being represented by border lines as shown.

- Denotes one inch spaces on border line of original tracing.

Tyl 231 orginal 229