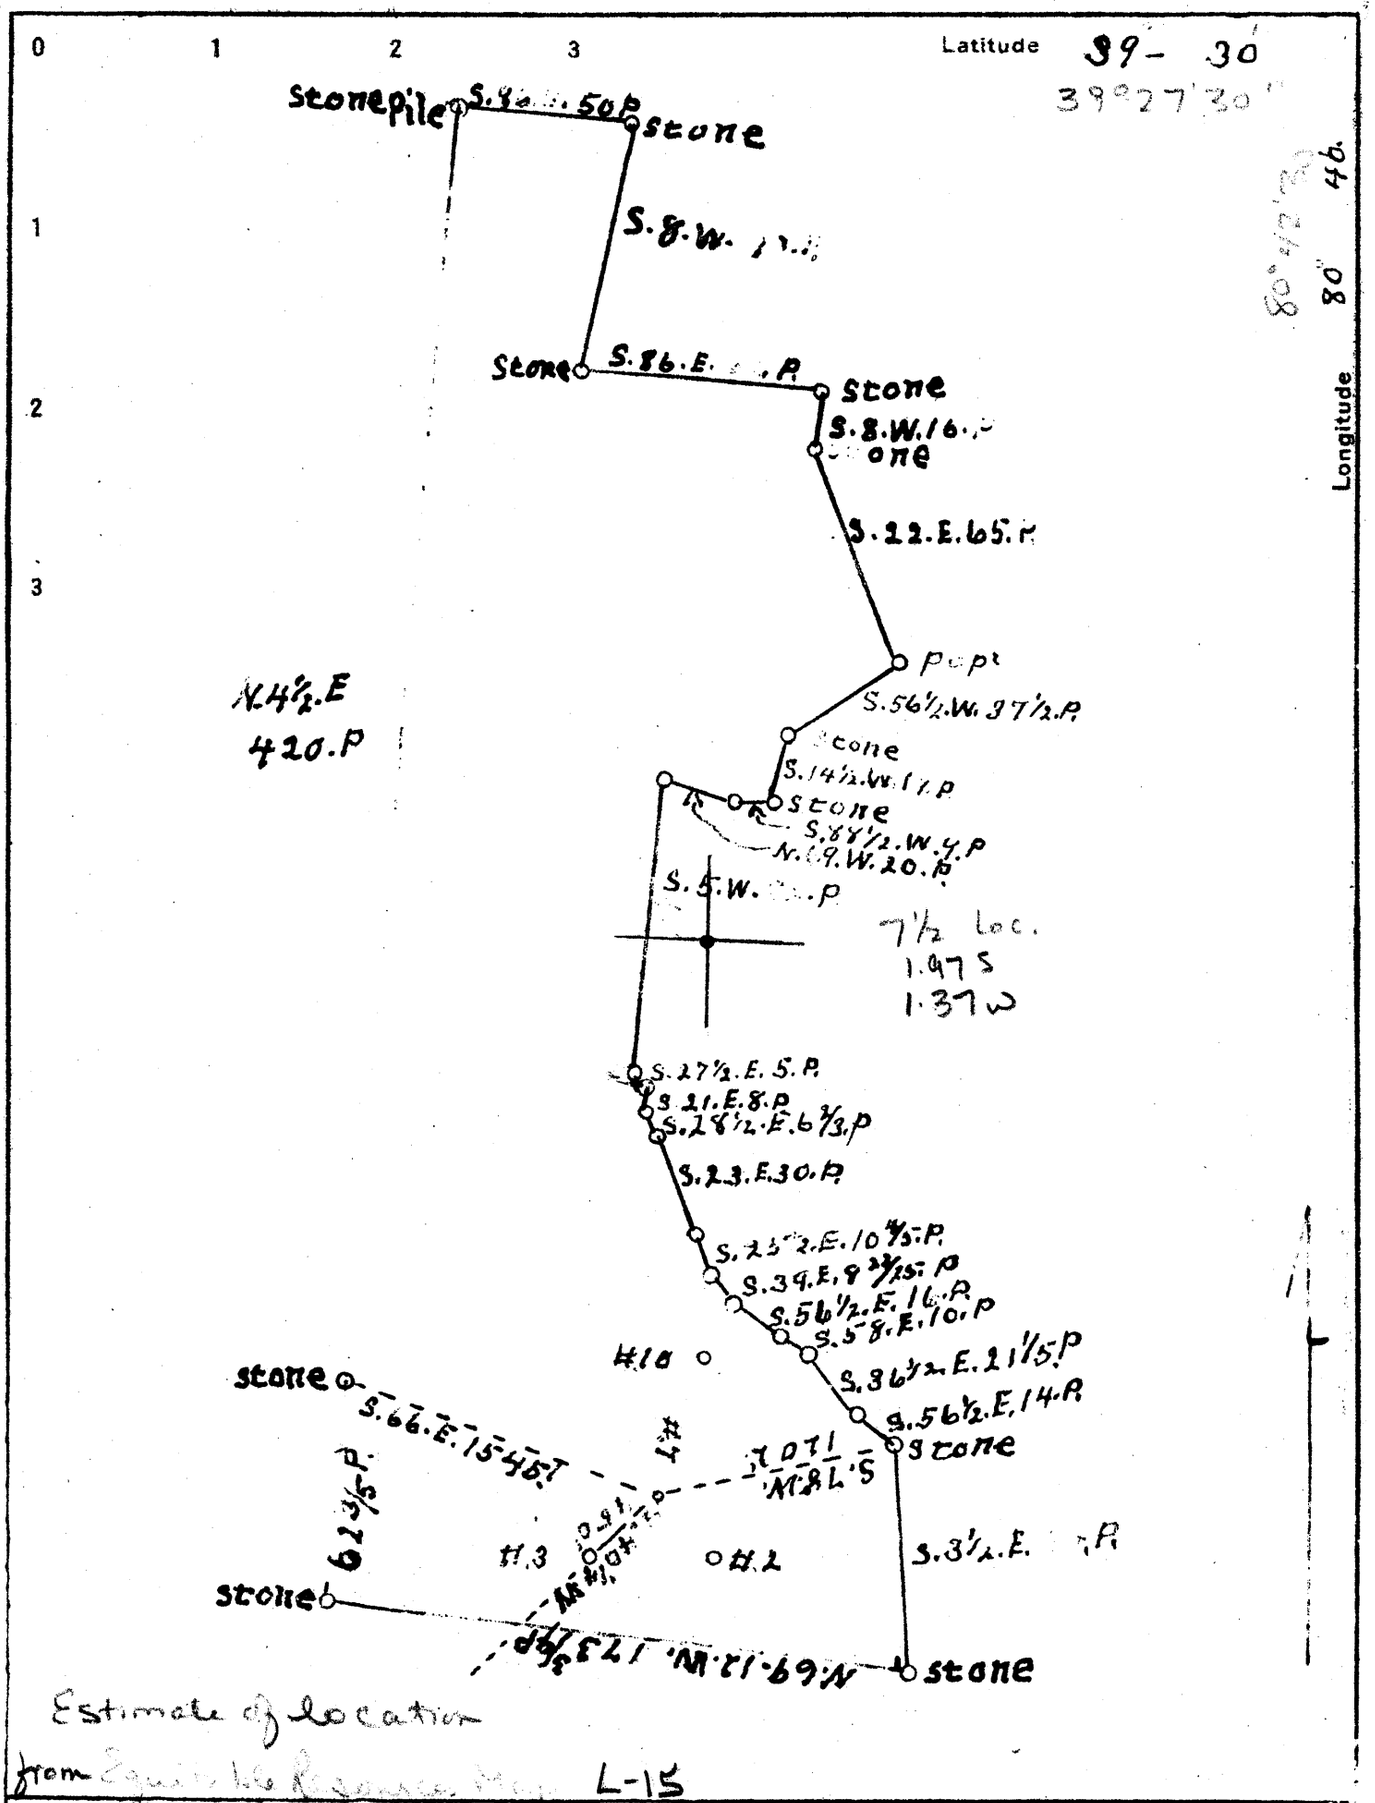

Estimate of location
from Equitable Resources Map L-15

Company American Oil & Dev. Co
Address Sistersville Iowa
Farm Jesse White
Tract 1 Acres 245. Lease No.
Well (Farm) No. 3. Serial No.
Elevation (Spirit Level) 760'
Quadrangle Center Point 7½
County Tyler District McElroy
Engineer J. S. Haught
Engineer's Registration No. Co. Surv.
File No. Drawing No.
Date 3-[illegible]-37 Scale 1" = 50 rds

STATE OF WEST VIRGINIA
DEPARTMENT OF MINES
OIL AND GAS DIVISION
CHARLESTON

WELL LOCATION MAP

FILE NO. TYL-234A

+ Denotes location of well on United States Topographic Maps, scale 1 to 62,500, latitude and longitude lines being represented by border lines as shown.

— Denotes one inch spaces on border line of original tracing.

PRINTED ON "IMPERIAL" TRACING