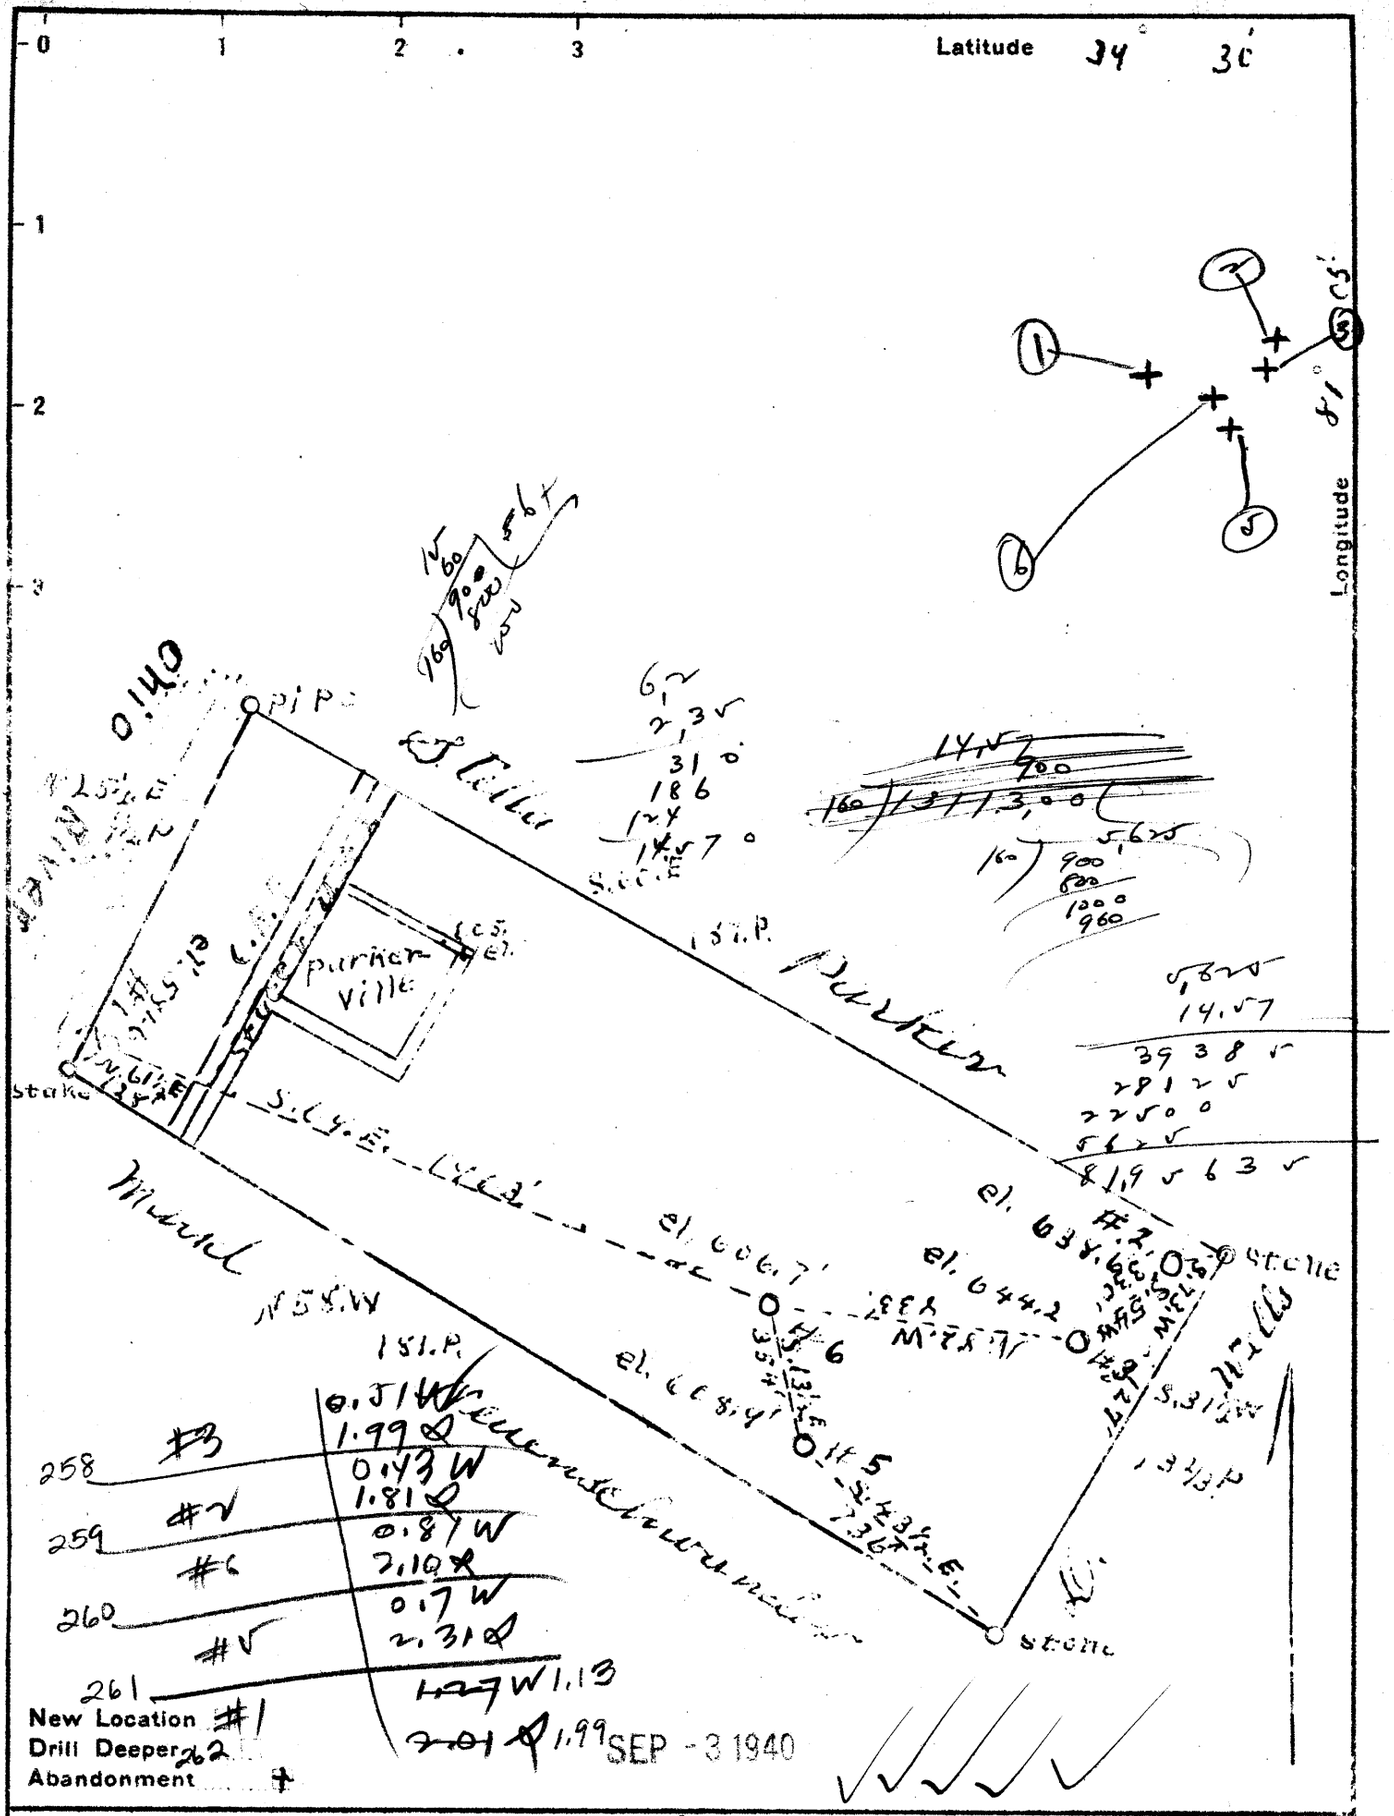

Company Lando & Kirkbride

Address Friendly W. Va.

Farm J. D. Powers

Tract 1 Acres 50 Lease No.

Well (Farm) No. 2.1.3.5.6 Serial No.

Elevation (Spirit Level) #2-638.6'

Quadrangle St Marys

County Tyler District Union

Engineer J. D. Hamilton

Engineer's Registration No. [illegible]

File No. Drawing No.

Date 8-20-1940 Scale 1" = 30. rds

NU

STATE OF WEST VIRGINIA
DEPARTMENT OF MINES
OIL AND GAS DIVISION
CHARLESTON

WELL LOCATION MAP

FILE NO. TYL-258A To 262A
WELLS 3,2,6,5 & 1

+ Denotes location of well on United States Topographic Maps, scale 1 to 62,500, latitude and longitude lines being represented by border lines as shown.

— Denotes one inch spaces on border line of original tracing.

J. B. Holmes NOS. 3,2,6,5,& 1 - LANDO & KIRKBRIDE - TYL-258-A to 262-A.