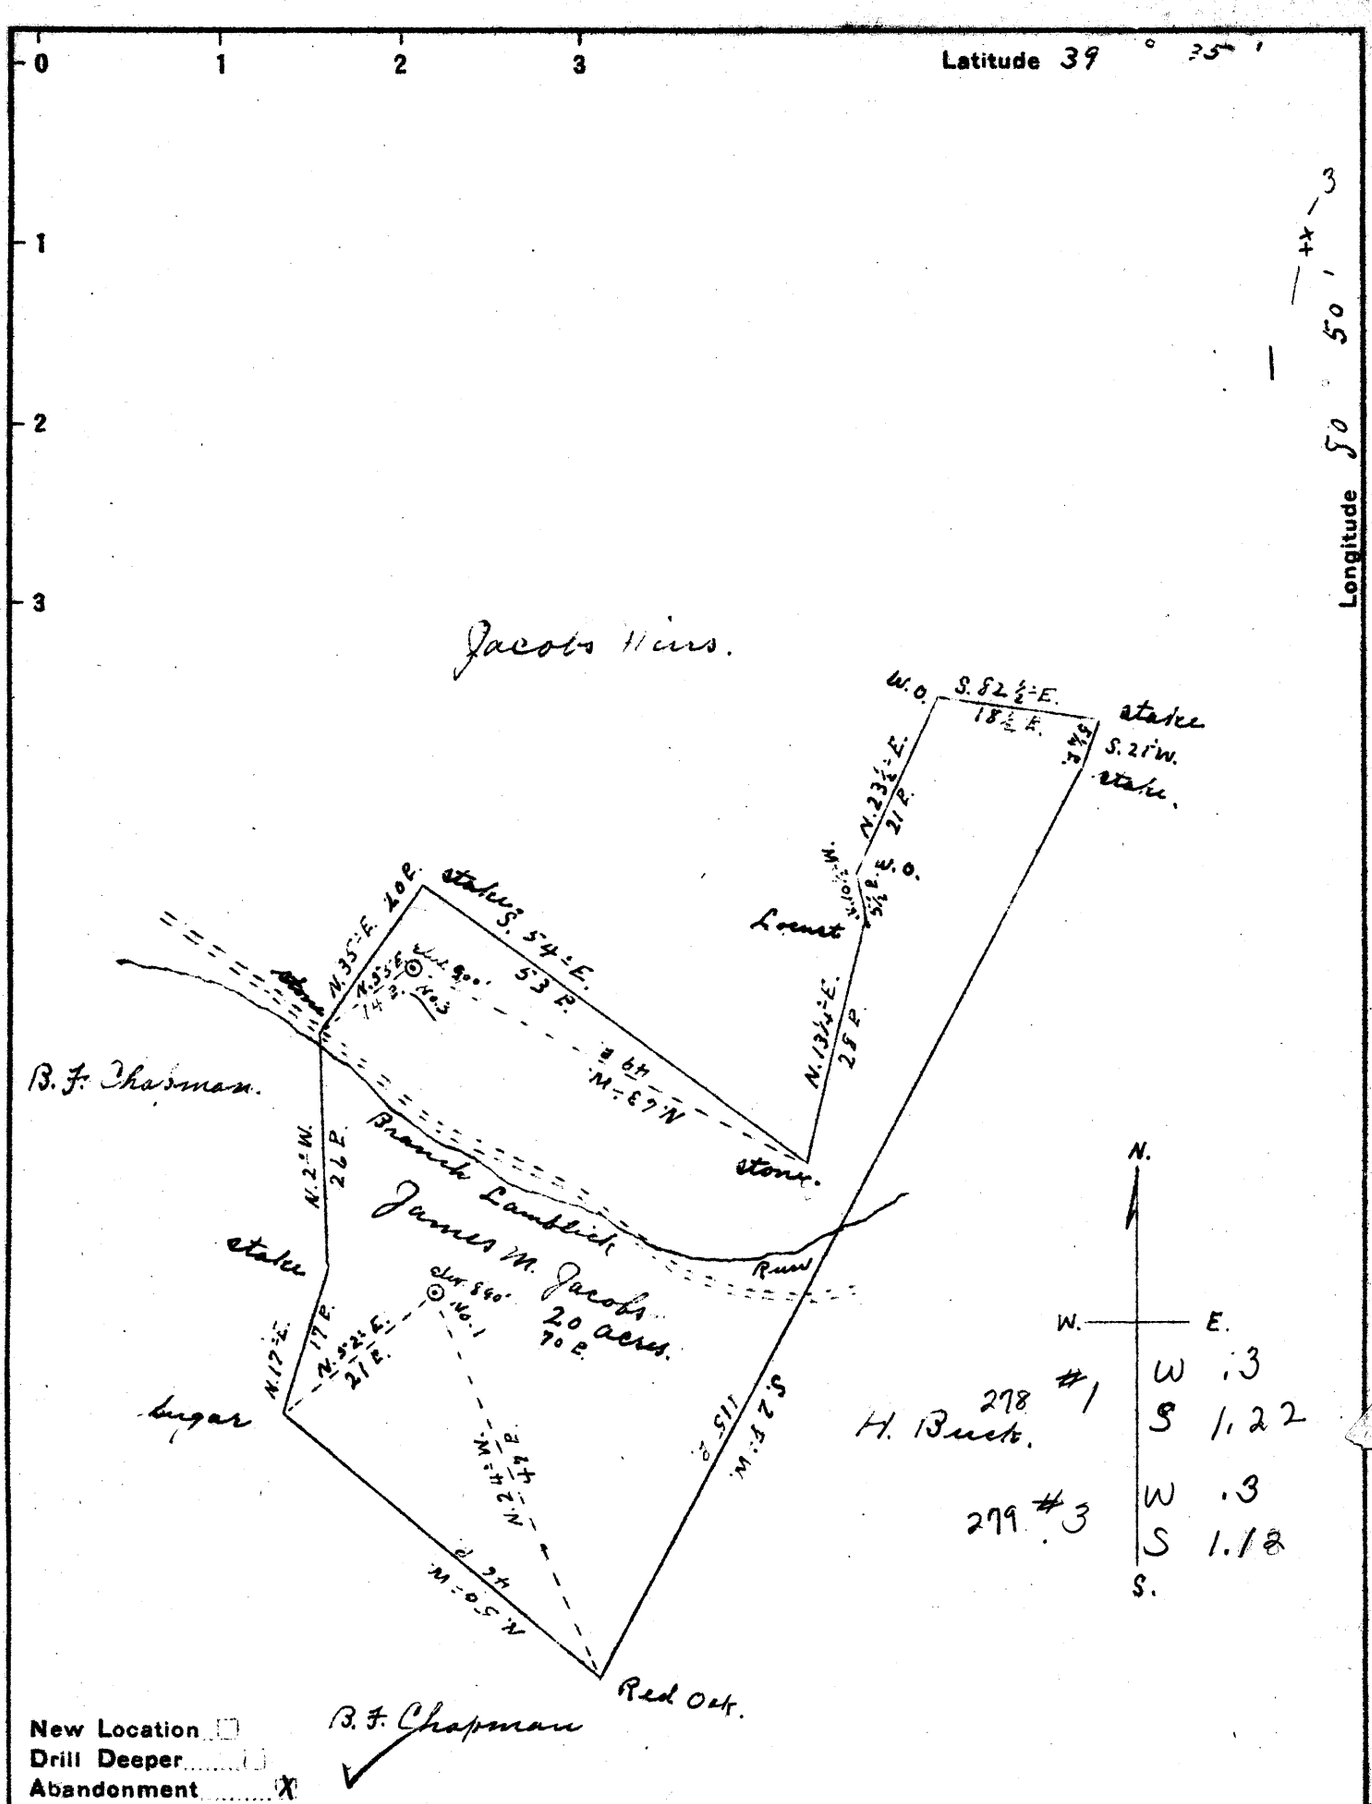

New Location ☐
Drill Deeper ☐
Abandonment ☒

Company Reno Oil Co.
Address Listersville W.Va.
Farm James M. Jacobs
Tract ____ Acres 20+ Lease No. ____
Well (Farm) No. 1 & 3 Serial No. ____
Elevation (Spirit Level) No1 890' No.3 900'
Quadrangle New Martinsville SC
County Tyler District Ellsworth
Engineer Sno Triplett
Engineer's Registration No. ____
File No. ____ Drawing No. ____
Date April 5, 1941 Scale 20 P = 1"

STATE OF WEST VIRGINIA
DEPARTMENT OF MINES
OIL AND GAS DIVISION
CHARLESTON

WELL LOCATION MAP

FILE NO. TYL-278A/279A
1 3

+ Denotes location of well on United States Topographic Maps, scale 1 to 62,500, latitude and longitude lines being represented by border lines as shown.

— Denotes one inch spaces on border line of original tracing.

PRINTED ON "IMPERIAL" TRACING