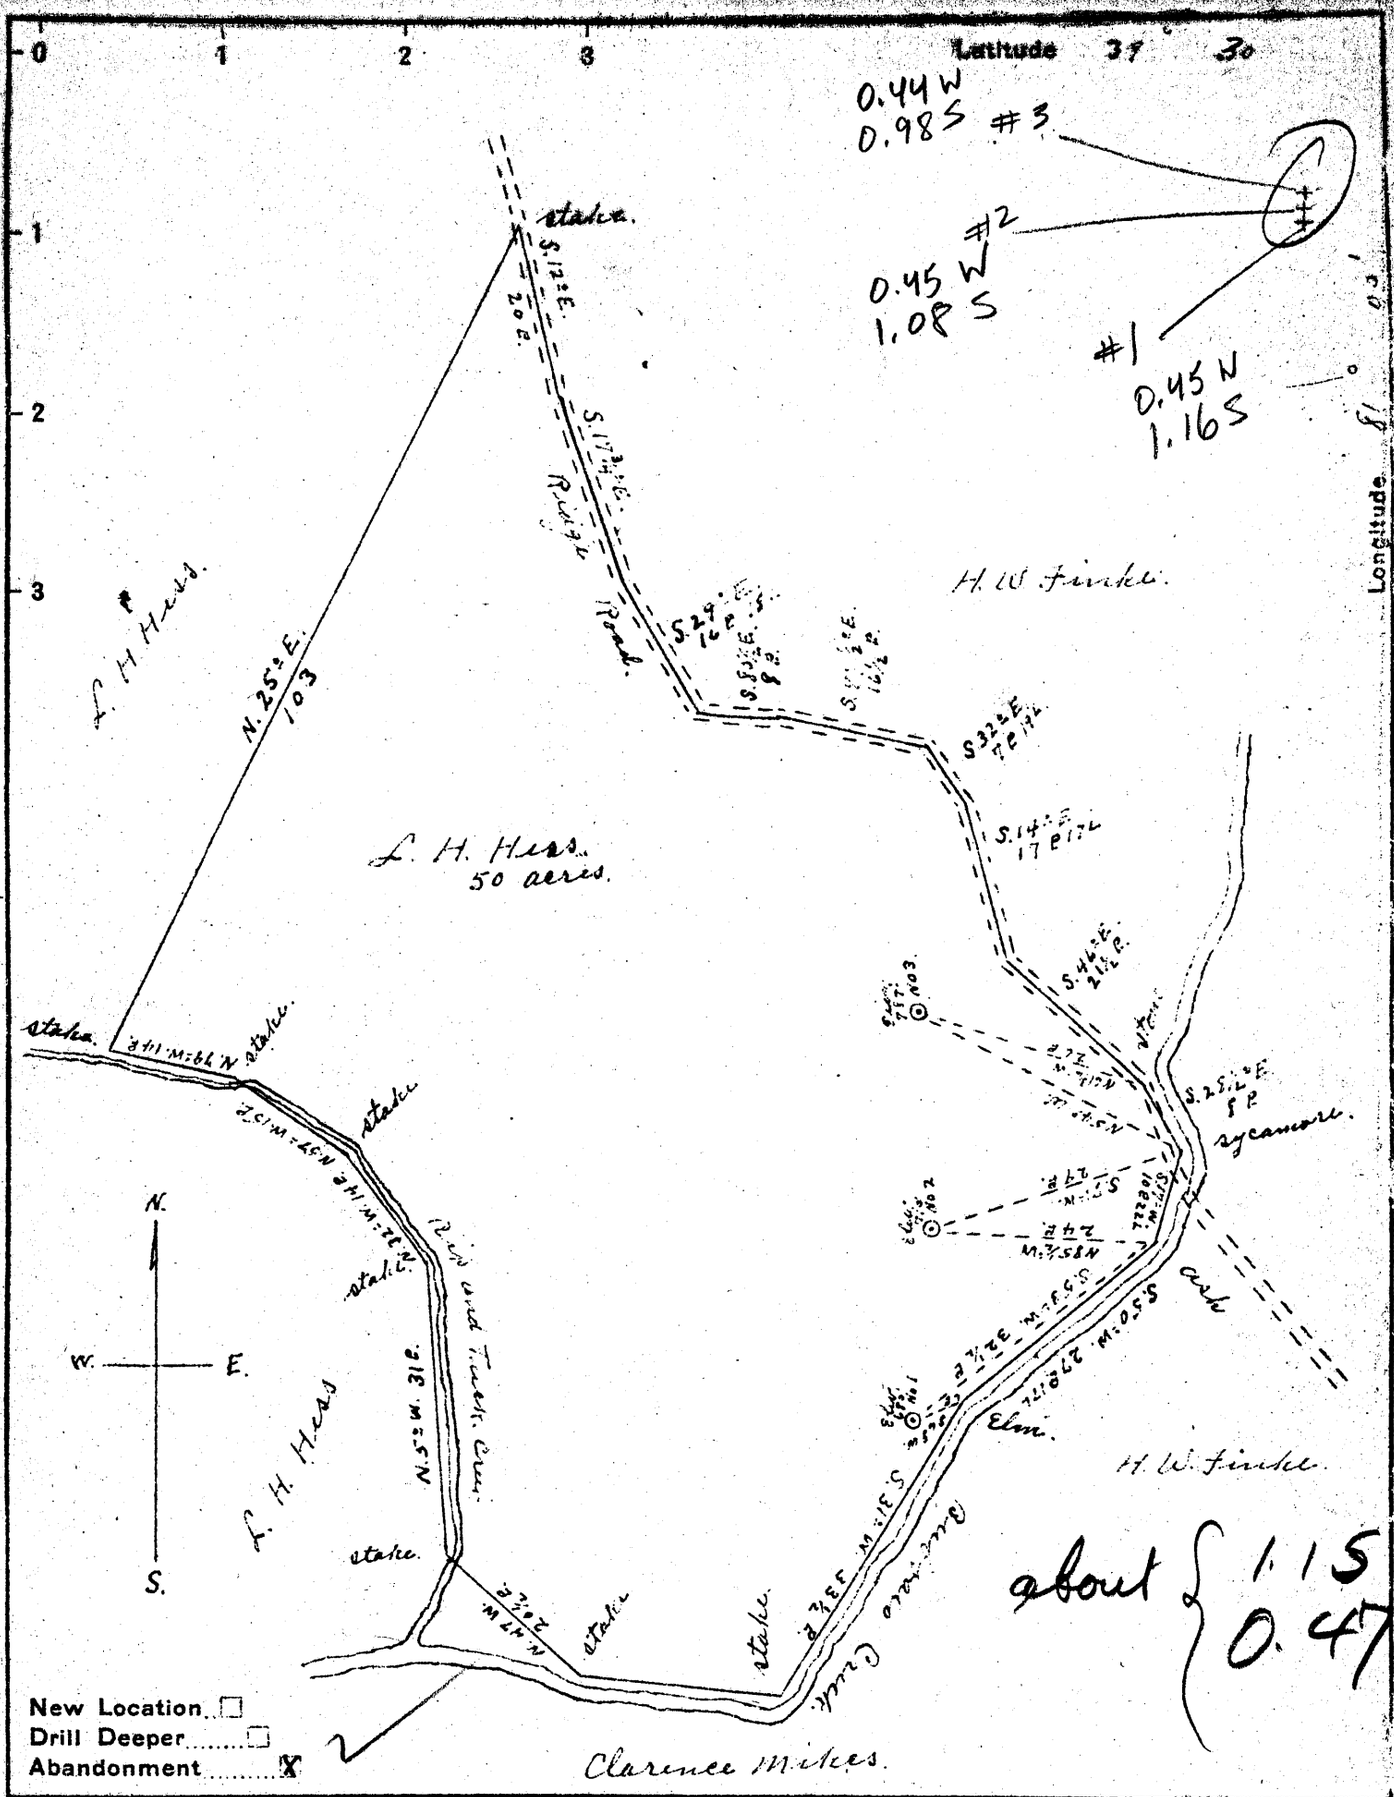

New Location ☐
Drill Deeper ☐
Abandonment X

Company Hess Oil Company
Address Route #1 Friendly West Va.
Farm L. H. Hess
Tract ____ Acres 50 Lease No. ____
Well (Farm) No. 1, 2, & 3 Serial No. ____
Elevation (Spirit Level) No. 1 680', No. 2 710', No. 3 787'
Quadrangle St Marys
County Tyler District Union
Engineer Jno. Triplett
Engineer's Registration No. ____
File No. ____ Drawing No. ____
Date Feb. 21, 1922 Scale 20 P. to 1"

STATE OF WEST VIRGINIA
DEPARTMENT OF MINES
OIL AND GAS DIVISION
CHARLESTON

WELL LOCATION MAP

FILE NO. DVL-302-A-Well #1
TYL-303-A-Well #2
TYL-304-A-Well #3

+ Denotes location of well on United States Topographic Maps, scale 1 to 62,500, latitude and longitude lines being represented by border lines as shown.

— Denotes one inch spaces on border line of original tracing.

"IMPERIAL" TRACING CLOTH
K & E CO., N. Y.