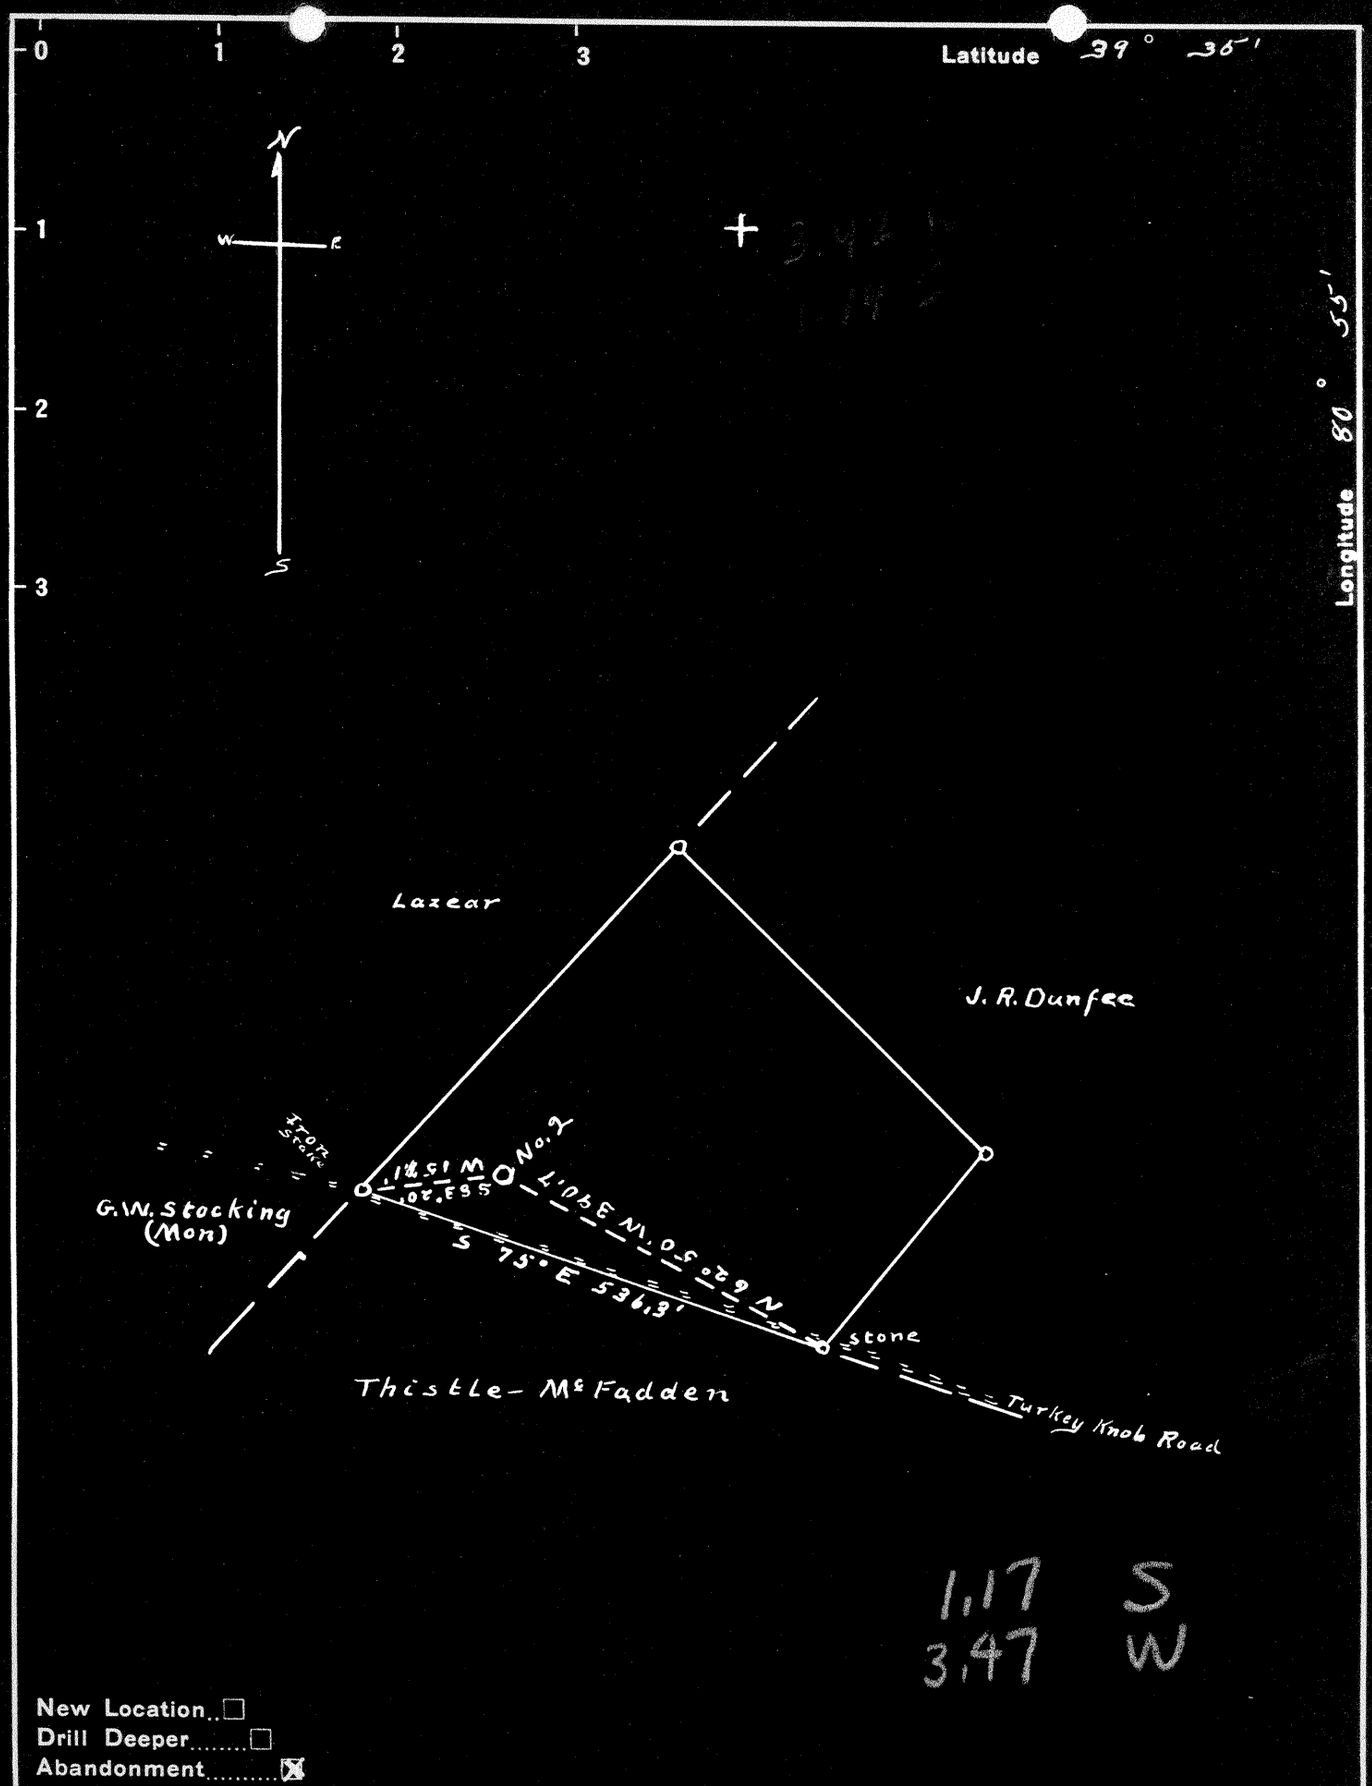

New Location..☐
Drill Deeper.....☐
Abandonment.....☒

Company J. R. Bull
Address Sistersville, W. Va.
Farm Russell (N.Y.) Hrs.
Tract 1 Acres 7 Lease No. 6097
Well (Farm) No. 2 Serial No.
Elevation (Spirit Level) 1049' SW
Quadrangle New Martinsville
County Tyler District Lincoln
Engineer Approved by George R. Clarke Don L. Riggle
Engineer's Registration No. 102
File No. 046-SP 11 Drawing No. 1394
Date May 19, '48 Scale 1" = 200'

STATE OF WEST VIRGINIA
DEPARTMENT OF MINES
OIL AND GAS DIVISION
CHARLESTON

WELL LOCATION MAP

FILE NO. JYL-583-A

+ Denotes location of well on United States Topographic Maps, scale 1 to 62,500, latitude and longitude lines being represented by border lines as shown.

— Denotes one inch spaces on border line of original tracing.

"IMPERIAL" TRACING CLOTH
K & E CO., N. Y.