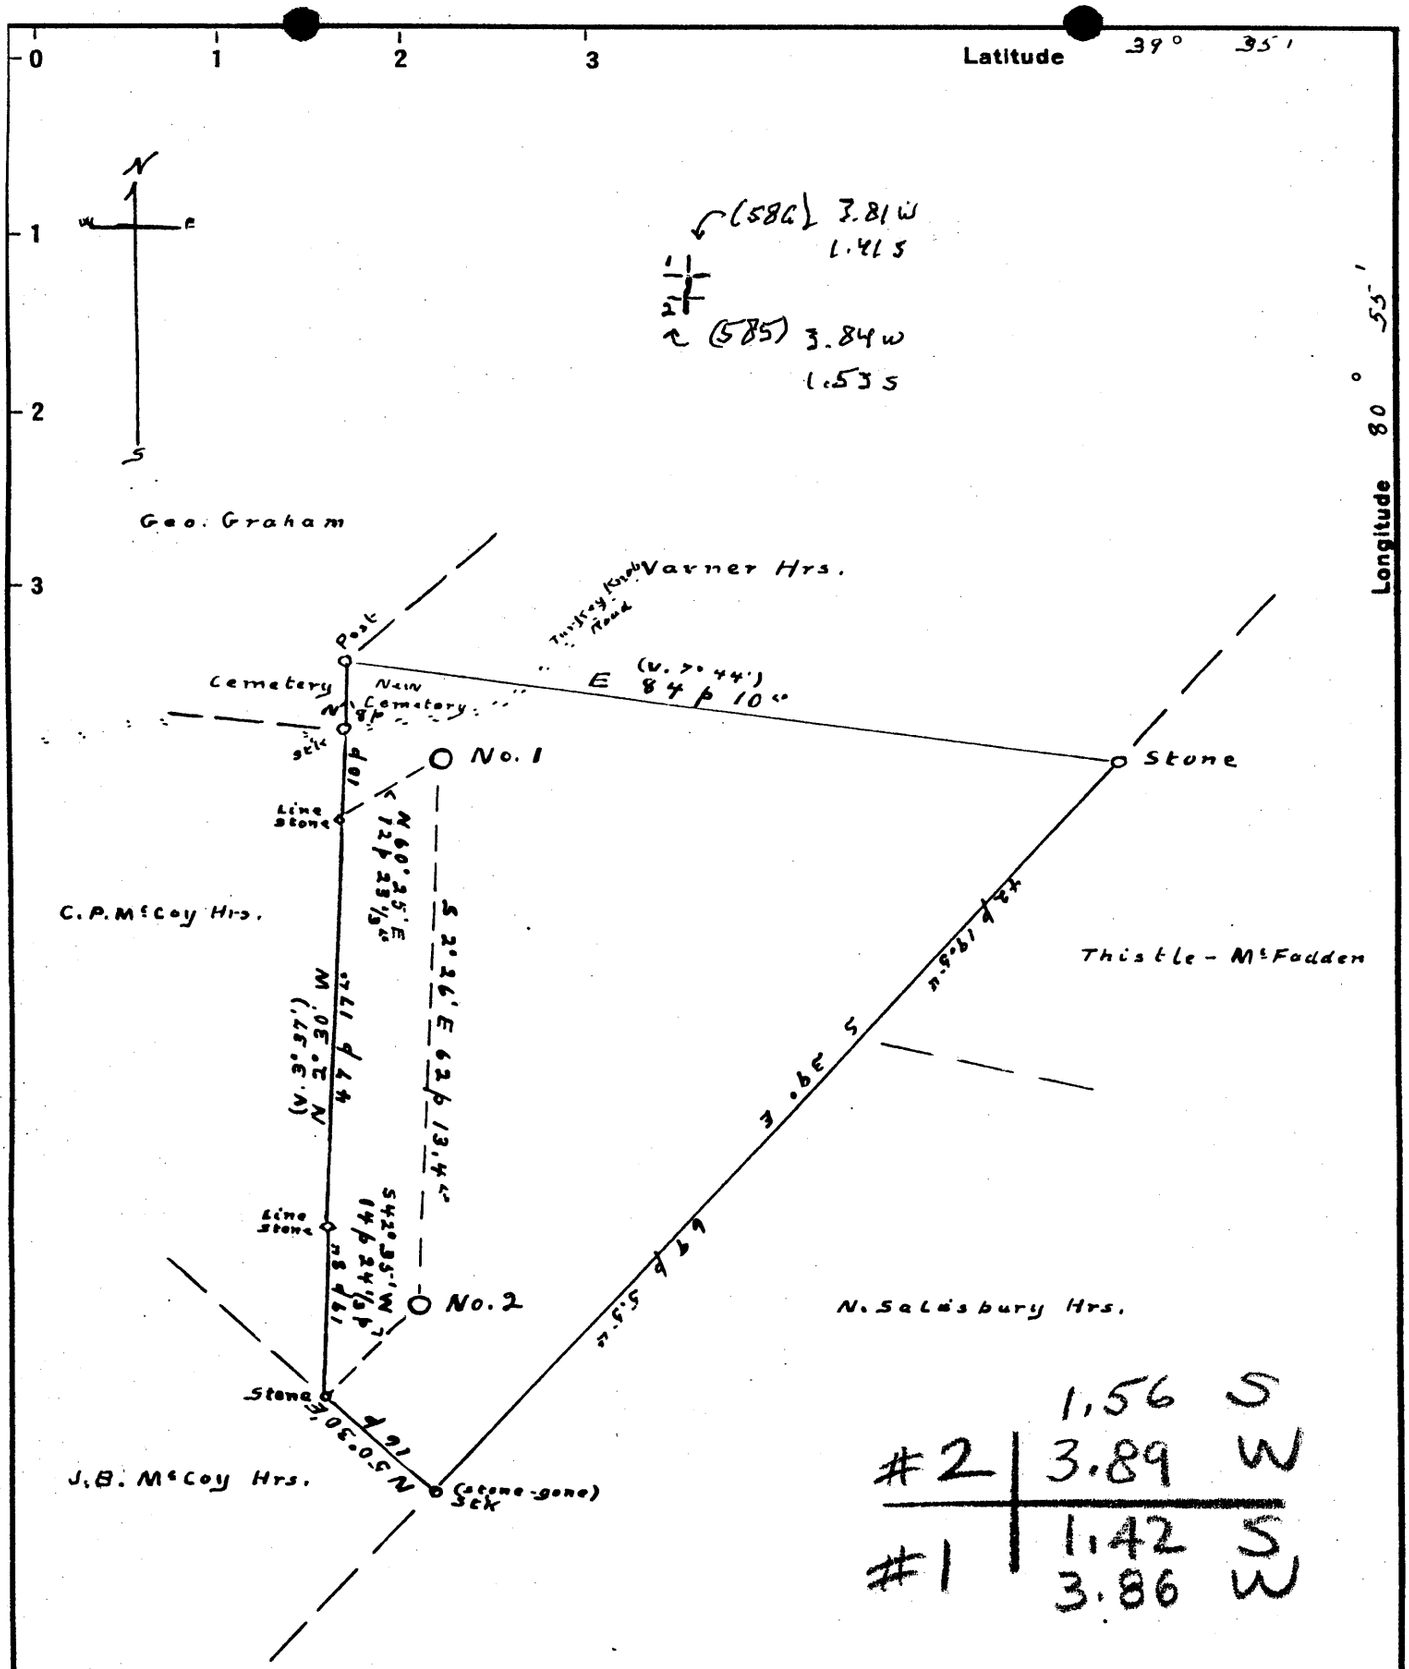

New Location ☐
Drill Deeper ☐
Abandonment ☒

(No. 1 Coseing head +1') (No. 2 casing head + 1.9')
(No. 1 Well has previously been located on Topo. Sheet)

Company Roy W. Confer Co.
Address 515 Allen St., Titusville, Pa.
Farm McCoy Hrs.
Tract 1 Acres 30 Lease No. SW
Well (Farm) No. 2 + 1 Serial No.
Elevation (Spirit Level) No. 2 - 966.095 No. 1 - 789.092'
Quadrangle New Martinsville
County Tyler District Lincoln
Engineer Don L. Riggle
Engineer's Registration No.
File No. 046-SR 11 Drawing No. 1393-B
Date May 19, '48 Scale 1" = 20 p

STATE OF WEST VIRGINIA
DEPARTMENT OF MINES
OIL AND GAS DIVISION
CHARLESTON

WELL LOCATION MAP

FILE NO. JYL-585-A-#2
JYL-586-A-#1

✚ Denotes location of well on United States Topographic Maps, scale 1 to 62,500, latitude and longitude lines being represented by border lines as shown.

— Denotes one inch spaces on border line of original tracing.

"IMPERIAL" TRACING CLOTH
K & E CO., N. Y.