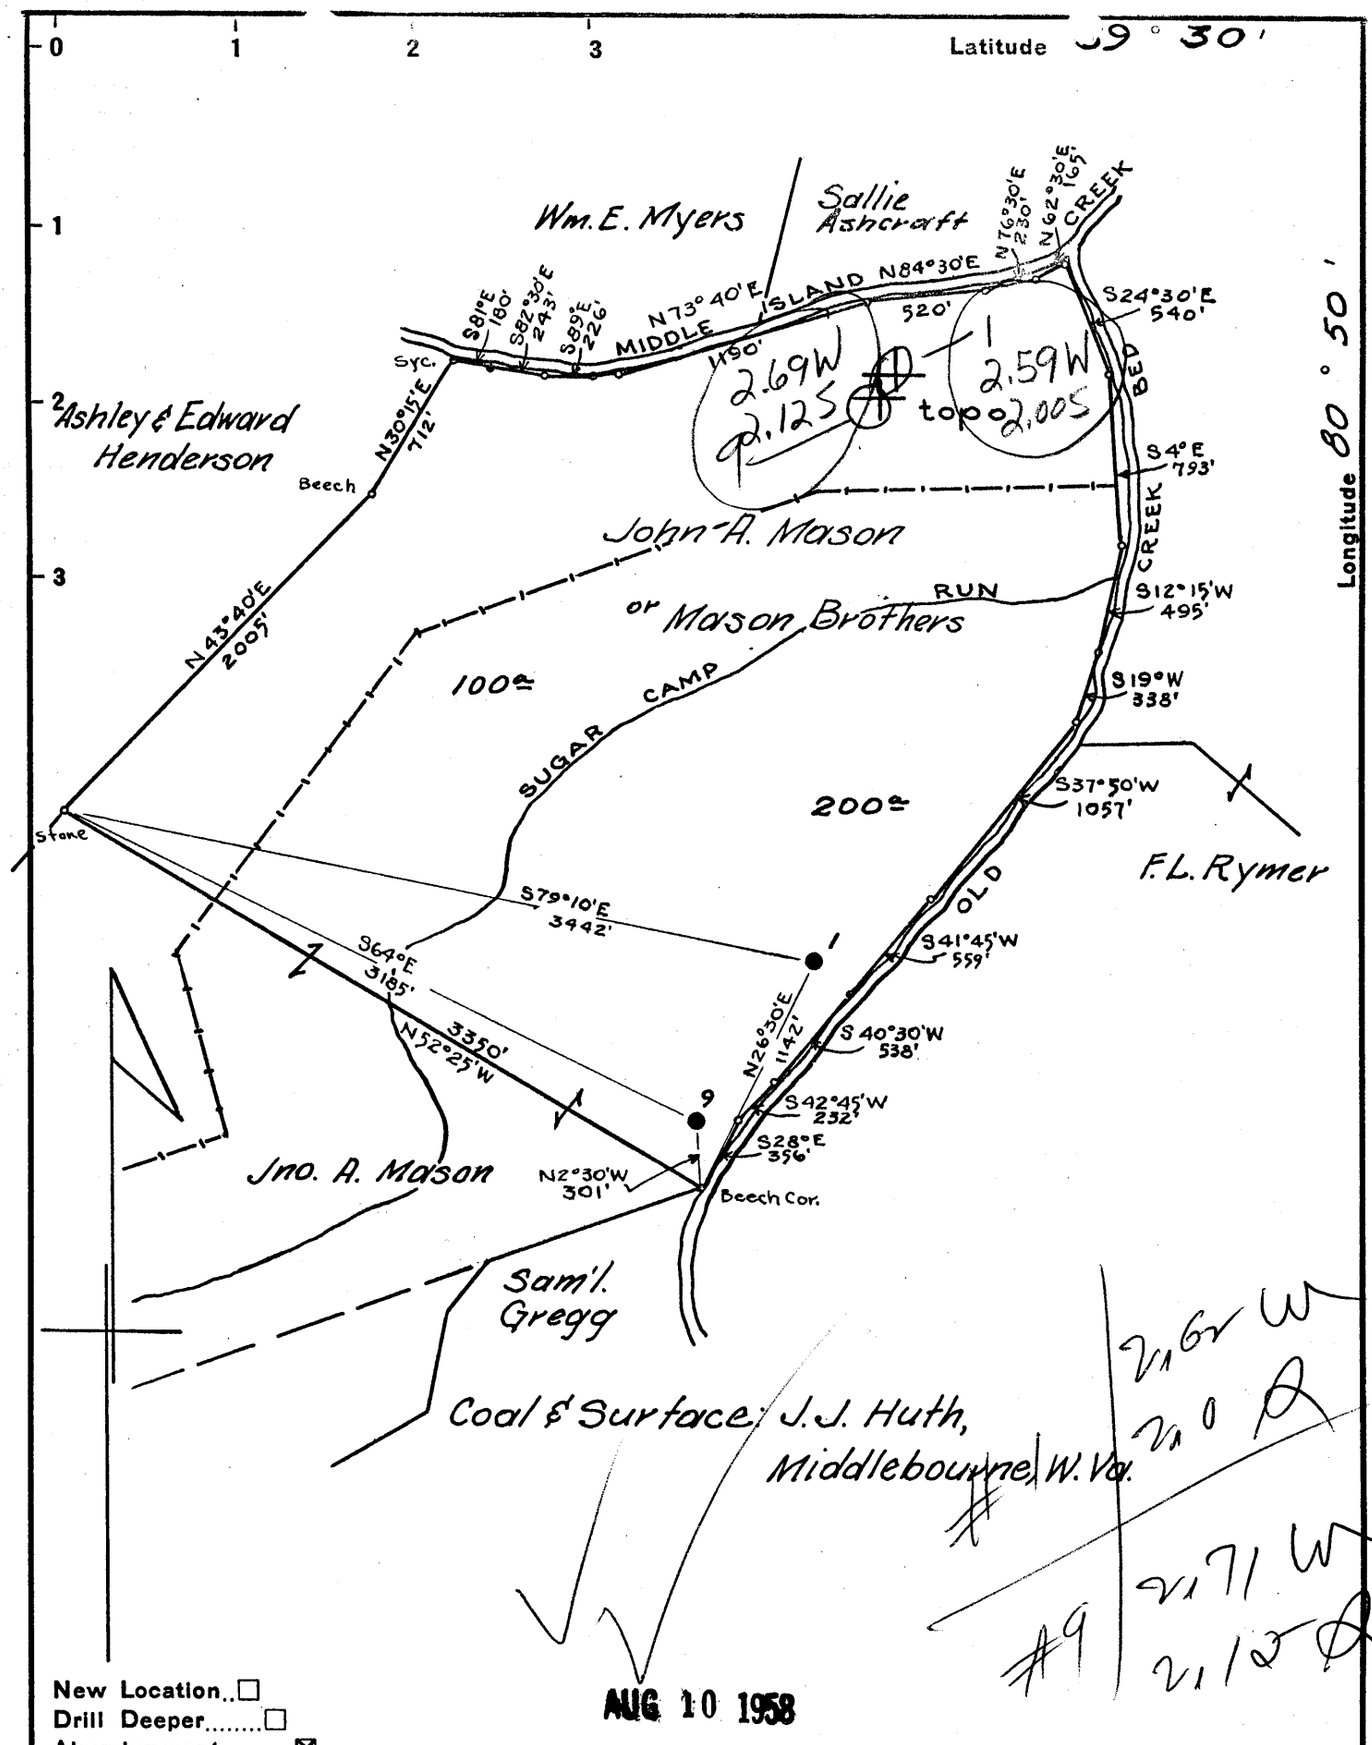


New Location ☐
Drill Deeper ☐
Abandonment ☒

AUG 10 1958

Map N46 N3, W15

Company South Penn Natural Gas Co.
Address Parkersburg, W. Va.
Farm Mason Brothers
Tract _____ Acres 200 Lease No. 52950
Well (Farm) No. 1 & 9 Serial No. _____
Elevation (Spirit Level) #(1) 715.42 Floor #(9) 745.63 Floor
Quadrangle West Union
County Tyler District Ellsworth
Engineer A.C. Willeit
Engineer's Registration No. 2534
File No. _____ Drawing No. _____
Date June 6, 1958 Scale 1" = 800'

STATE OF WEST VIRGINIA
DEPARTMENT OF MINES
OIL AND GAS DIVISION
CHARLESTON

## WELL LOCATION MAP

FILE NO. ~~JYL-898-A-#1~~ JYL-899-A-#9

+ Denotes location of well on United States Topographic Maps, scale 1 to 62,500, latitude and longitude lines being represented by border lines as shown.

— Denotes one inch spaces on border line of original tracing.

MASON BROS. NOS. 1 & 9 — SOUTH PENN N, 6, 6, — JYL-898-9-A