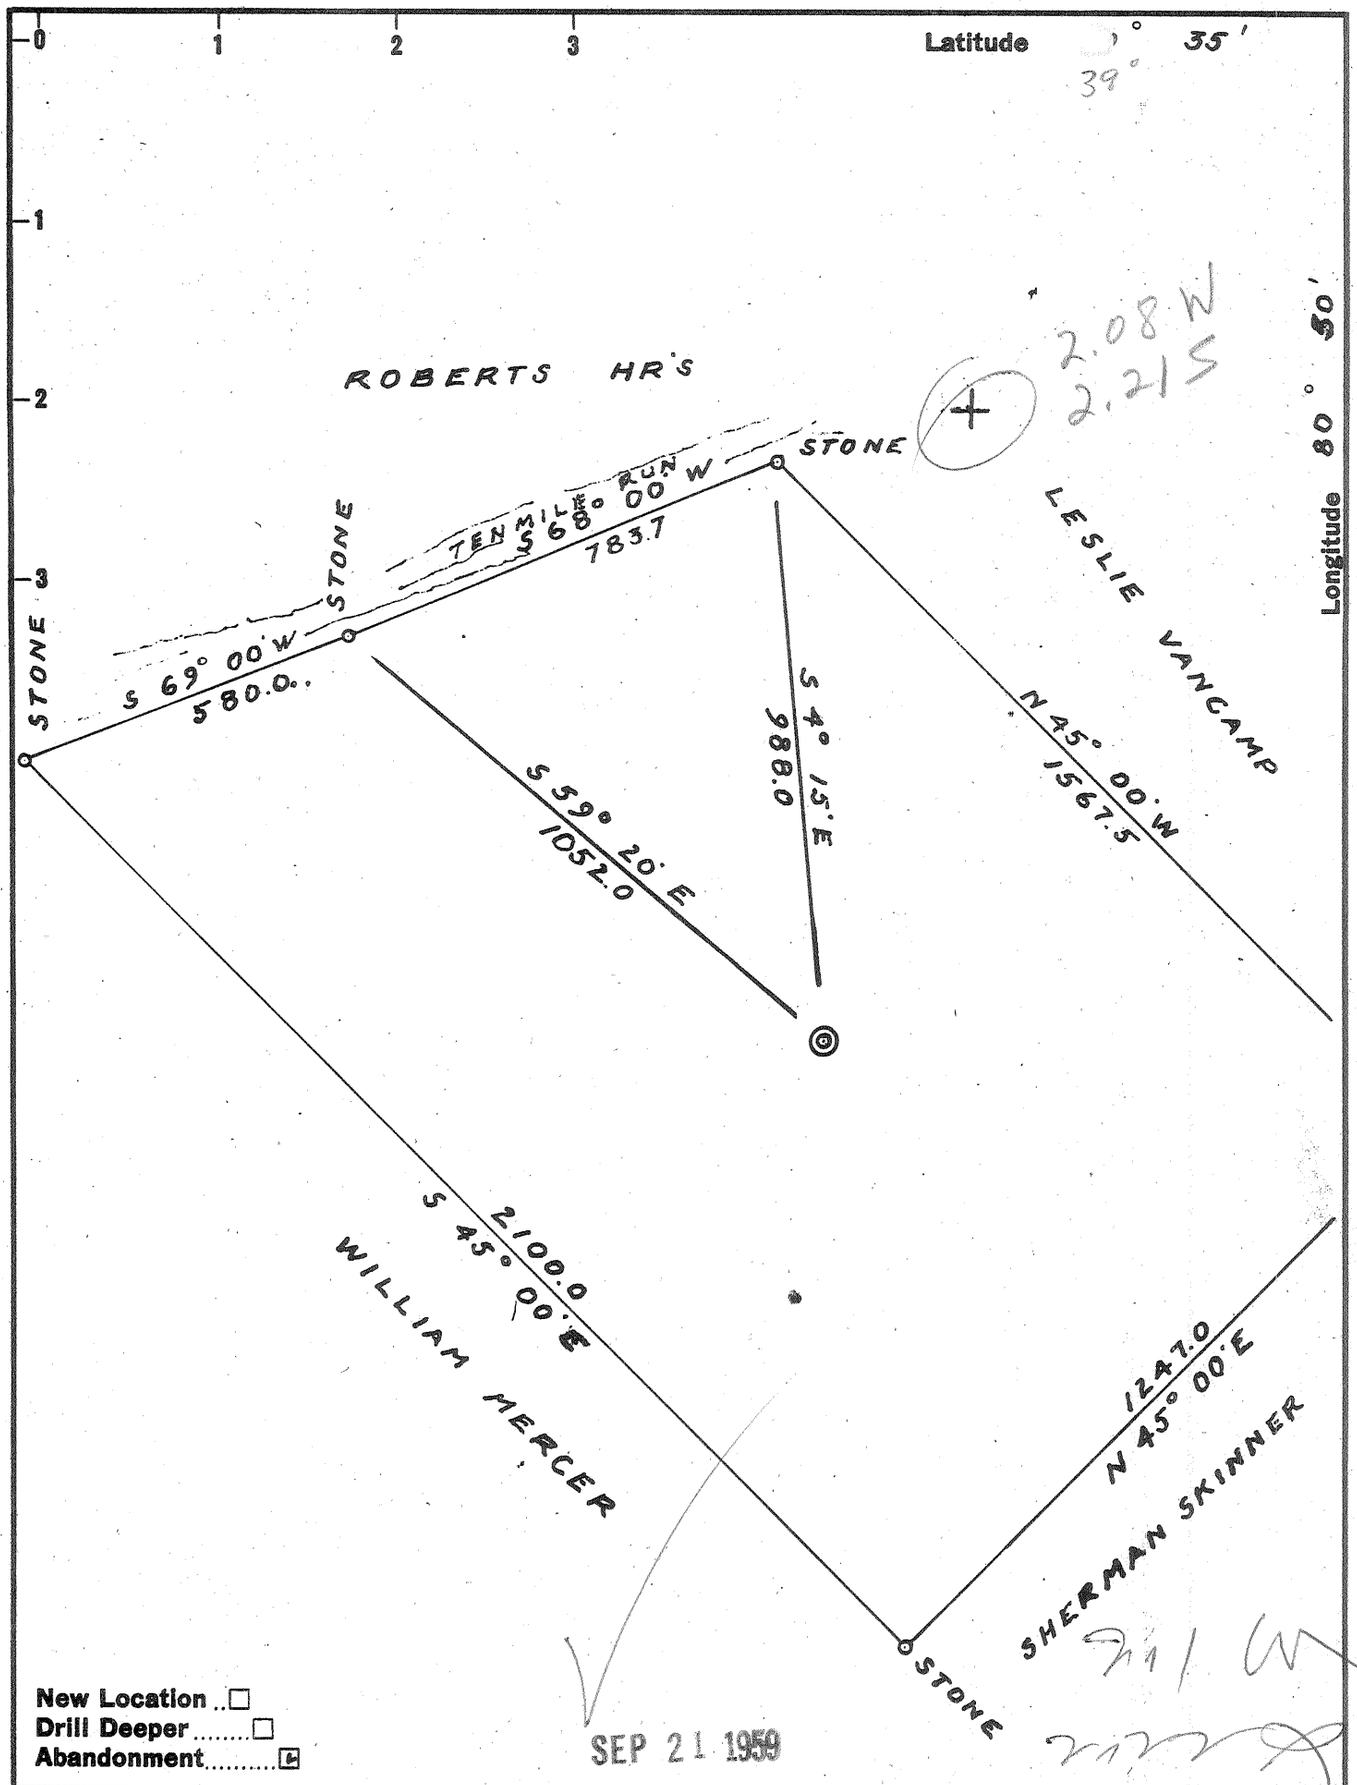

New Location ..☐
Drill Deeper.....☐
Abandonment.....☒

SEP 21 1959

Company DANIEL HENTHORN
Address MIDDLEBOURNE W.Va.
Farm T.B. BOOR
Tract _____ Acres 35 Lease No. _____
Well (Farm) No. 2 Serial No. _____
Elevation (Spirit Level) 1032
Quadrangle NEW MARTINSVILLE
County TYLER District ELLSWORTH
Engineer G.L. McINTIRE
Engineer's Registration No. 1187
File No. _____ Drawing No. _____
Date 5/15/59 Scale 1" = 300'

STATE OF WEST VIRGINIA
DEPARTMENT OF MINES
OIL AND GAS DIVISION
CHARLESTON

WELL LOCATION MAP

FILE NO. TYL-905-A

+ Denotes location of well on United States Topographic Maps, scale 1 to 62,500, latitude and longitude lines being represented by border lines as shown.

— Denotes one inch spaces on border line of original tracing.

T. B. BOOR No. 2 — DANIEL HENTHORN — TYL-905-A