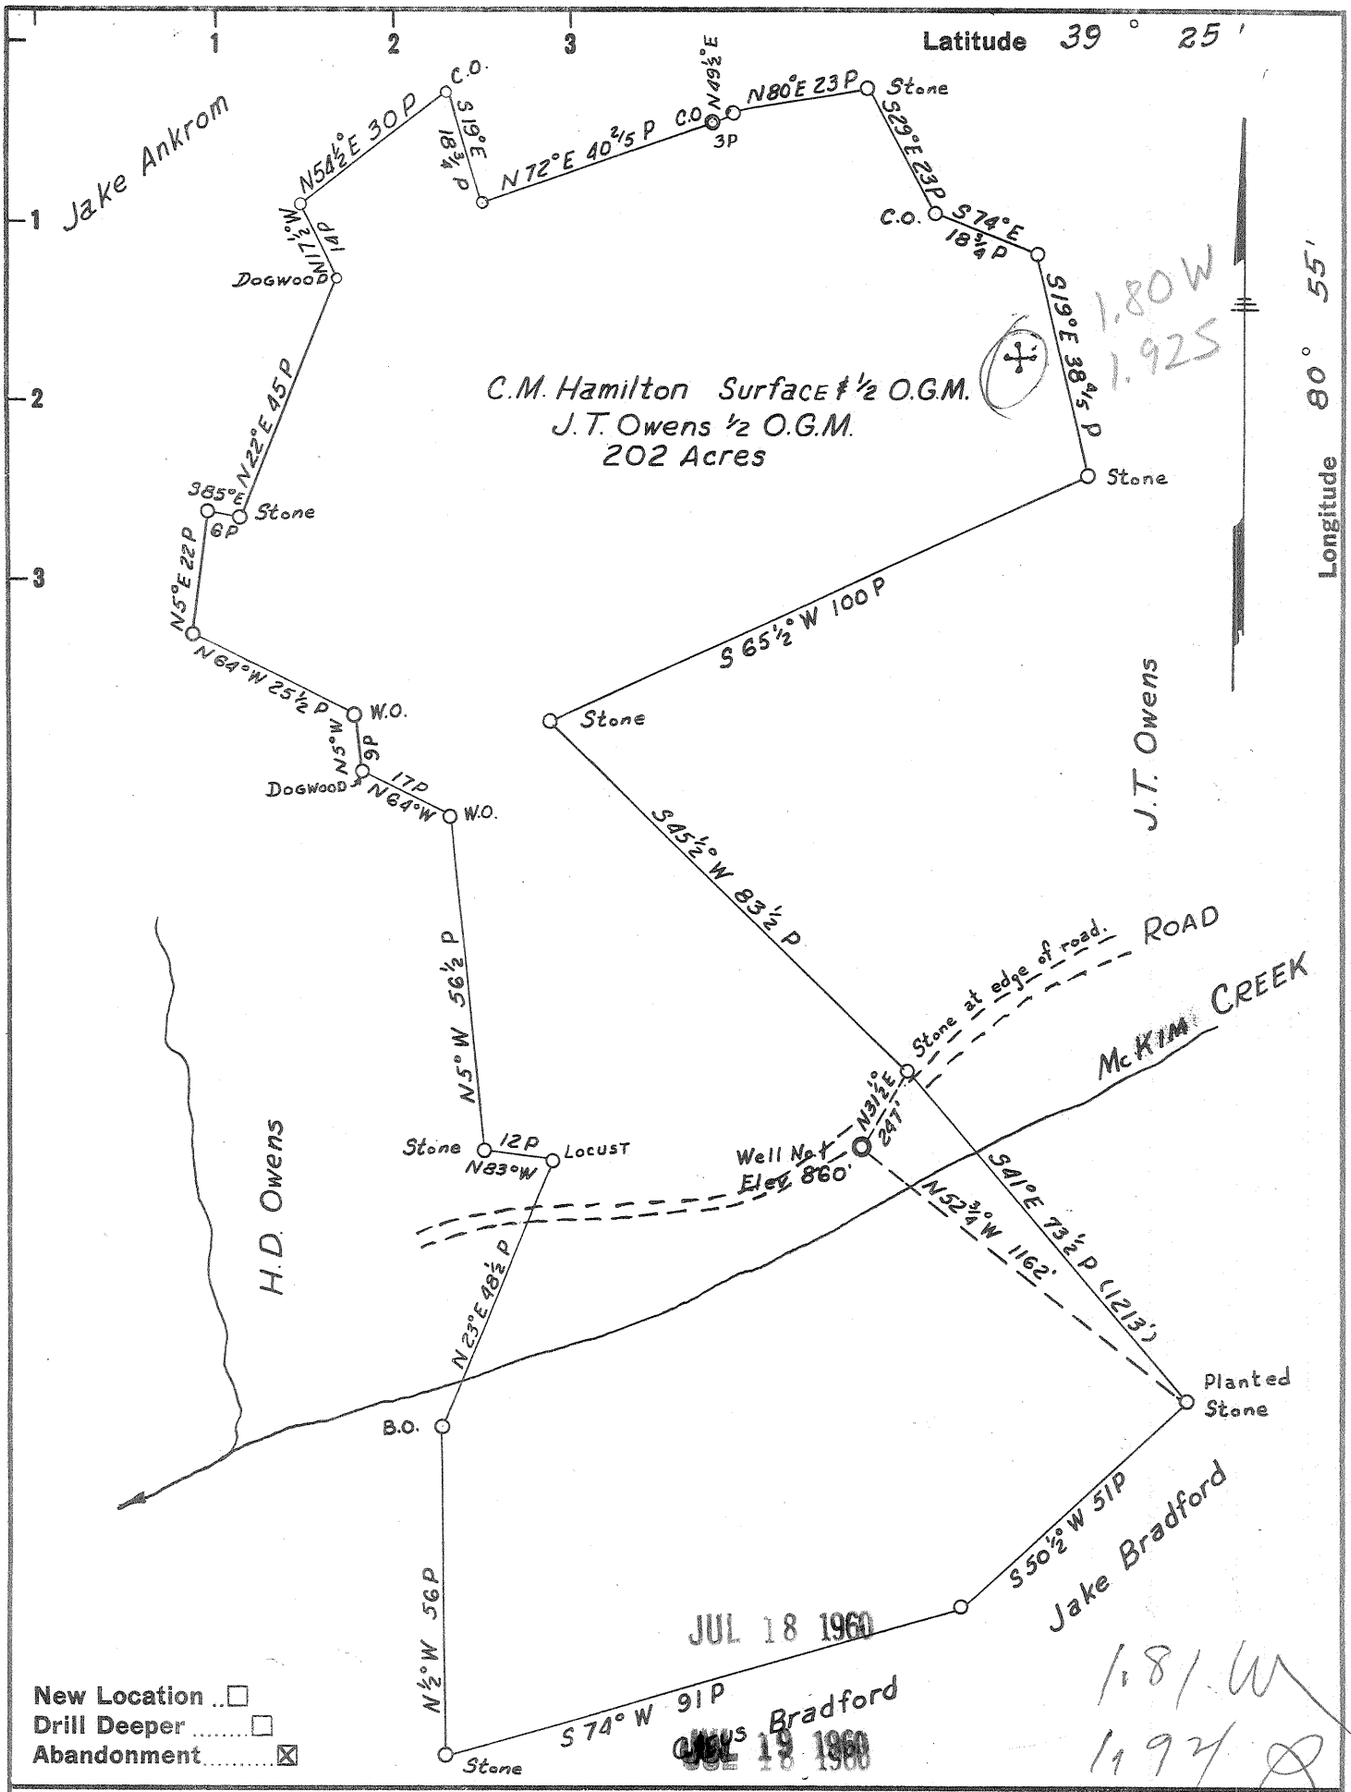

Company A.S. McCULLOUGH HRS., KENNETH McCULLOUGH, AGT.

Address ST. MARYS, W.VA., R.F.D. 39

Farm C.M. Hamilton Surf. & J.T. Owens ½ Min. ½ Min.

Tract 1 Acres 202 Lease No.

Well (Farm) No. 1 Serial No.

Elevation (Spirit Level) 860'

Quadrangle WEST UNION

County TYLER District MEADE

Engineer Parker E. Peters
Field - W.P. Ireland

Engineer's Registration No. 485

File No. Drawing No.

Date JUNE 14, 1960 Scale 1" = 30 P

STATE OF WEST VIRGINIA
DEPARTMENT OF MINES
OIL AND GAS DIVISION
CHARLESTON

WELL LOCATION MAP

FILE NO. TYL-913-A

+ Denotes location of well on United States Topographic Maps, scale 1 to 62,500, latitude and longitude lines being represented by border lines as shown.

— Denotes one inch spaces on border line of original tracing.

C.M. HAMILTON Surf. & ½ Min. 1 — A.S. McCULLOUGH HRS.
(J.T. OWENS ½ Min.) — (KENNETH McCULLOUGH, AGENT) — TYL-913-A