


LATITUDE 39°32'30"

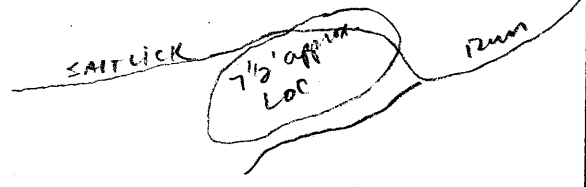

LONGITUDE 80°57'30"

7.5 OGIS topo location

7.5' loc \_\_\_\_\_ 15' loc \_\_\_\_\_  
 (calc.) \_\_\_\_\_

Company \_\_\_\_\_

Farm \_\_\_\_\_

Quad Paden City 7 1/2'

County Tyler

District Lincoln

WELL LOCATION MAP

File No. 095-70237

Lincoln District, Tyler County, W. Va.  
 Ingram, 171<sup>1</sup>/<sub>2</sub> Oak St., Parkersburg, W. Va.  
 Elevation, 875' B.

Gas well (abandoned)?

10" casing, 90'; 8<sup>1</sup>/<sub>4</sub>", 900'; 6-5/8", 1400'.

Original production, 10,000,000 cu. ft. (probably 7,000,000')  
 On Saltlick Run.

*no coal found*

	Top.	Bottom.
Coal, native (Washington "A")	25	
Gas Sand (Dunkard)	965	- 995
Salt Sand (water, 1310')	1290	
Maxton Sand	1430	
Big Linc	1600	- 1685
Keener Sand (gas, 1690')	1685	
Total depth		1698

(\*Pittsburgh Coal approx. 510')