

WW-7
8-30-06



West Virginia Department of Environmental Protection
Office of Oil and Gas

WELL LOCATION FORM: GPS

API: 47-103-00276 WELL NO.: 8190

FARM NAME: S. M. SHRIVER

RESPONSIBLE PARTY NAME: WEST VIRGINIA LAND RESOURCES INC.

COUNTY: WETZEL DISTRICT: CHURCH

QUADRANGLE: HUNDRED W.VA,PA

SURFACE OWNER: FRANCIS POSTLETHWAIT

ROYALTY OWNER: _____

UTM GPS NORTHING: 4,389,279 m (1289')

UTM GPS EASTING: 550,877 m GPS ELEVATION: 393 m

The Responsible Party named above has chosen to submit GPS coordinates in lieu of preparing a new well location plat for a plugging permit or assigned API number on the above well. The Office of Oil and Gas will not accept GPS coordinates that do not meet the following requirements:

- Datum: NAD 1983, Zone: 17 North, Coordinate Units: meters, Altitude: height above mean sea level (MSL) – meters.
- Accuracy to Datum – 3.05 meters
- Data Collection Method:

Survey grade GPS _____: Post Processed Differential _____

Real-Time Differential _____

Mapping Grade GPS X: Post Processed Differential X

Real-Time Differential _____

- Letter size copy of the topography map showing the well location.

I the undersigned, hereby certify this data is correct to the best of my knowledge and belief and shows all the information required by law and the regulations issued and prescribed by the Office of Oil and Gas.

Professional Surveyor

JUNE 4, 2021

Signature

Title

Date

RECEIVED
Office of Oil and Gas

JUL 26 2021

WV Department of
Environmental Protection

4710300276P



WELL #8190


OVERGAP 15 MI.
FAIRMONT 23 MI.



RECEIVED
Office of Oil and Gas

JUL 26 2021

WV Department of
Environmental Protection

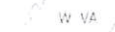

ROAD CLASSIFICATION

- Heavy duty
- Medium-duty
- Light-duty
- Unimproved dirt

U. S. Route
 State Route

HUNDRED, W. **10/29/2021**

NW/4 MANNINGTON 15' QUADRANGLE
N2027 E W8022 S/7 S

'Hundred; WV,PA' Scale: 1" = 0.379Mi 610Mt 2,000Ft, 1 Mi = 2.640" , 1 cm = 240Mt


491
40'
489
488000N
120 000 FEET (PA.)
39°37'30"
80°22'30"

MANNINGTON
4883 111 SE

Well# 8190

HUNDRED WV, PA 7.5' Quad

Scale: 1" = 2000'

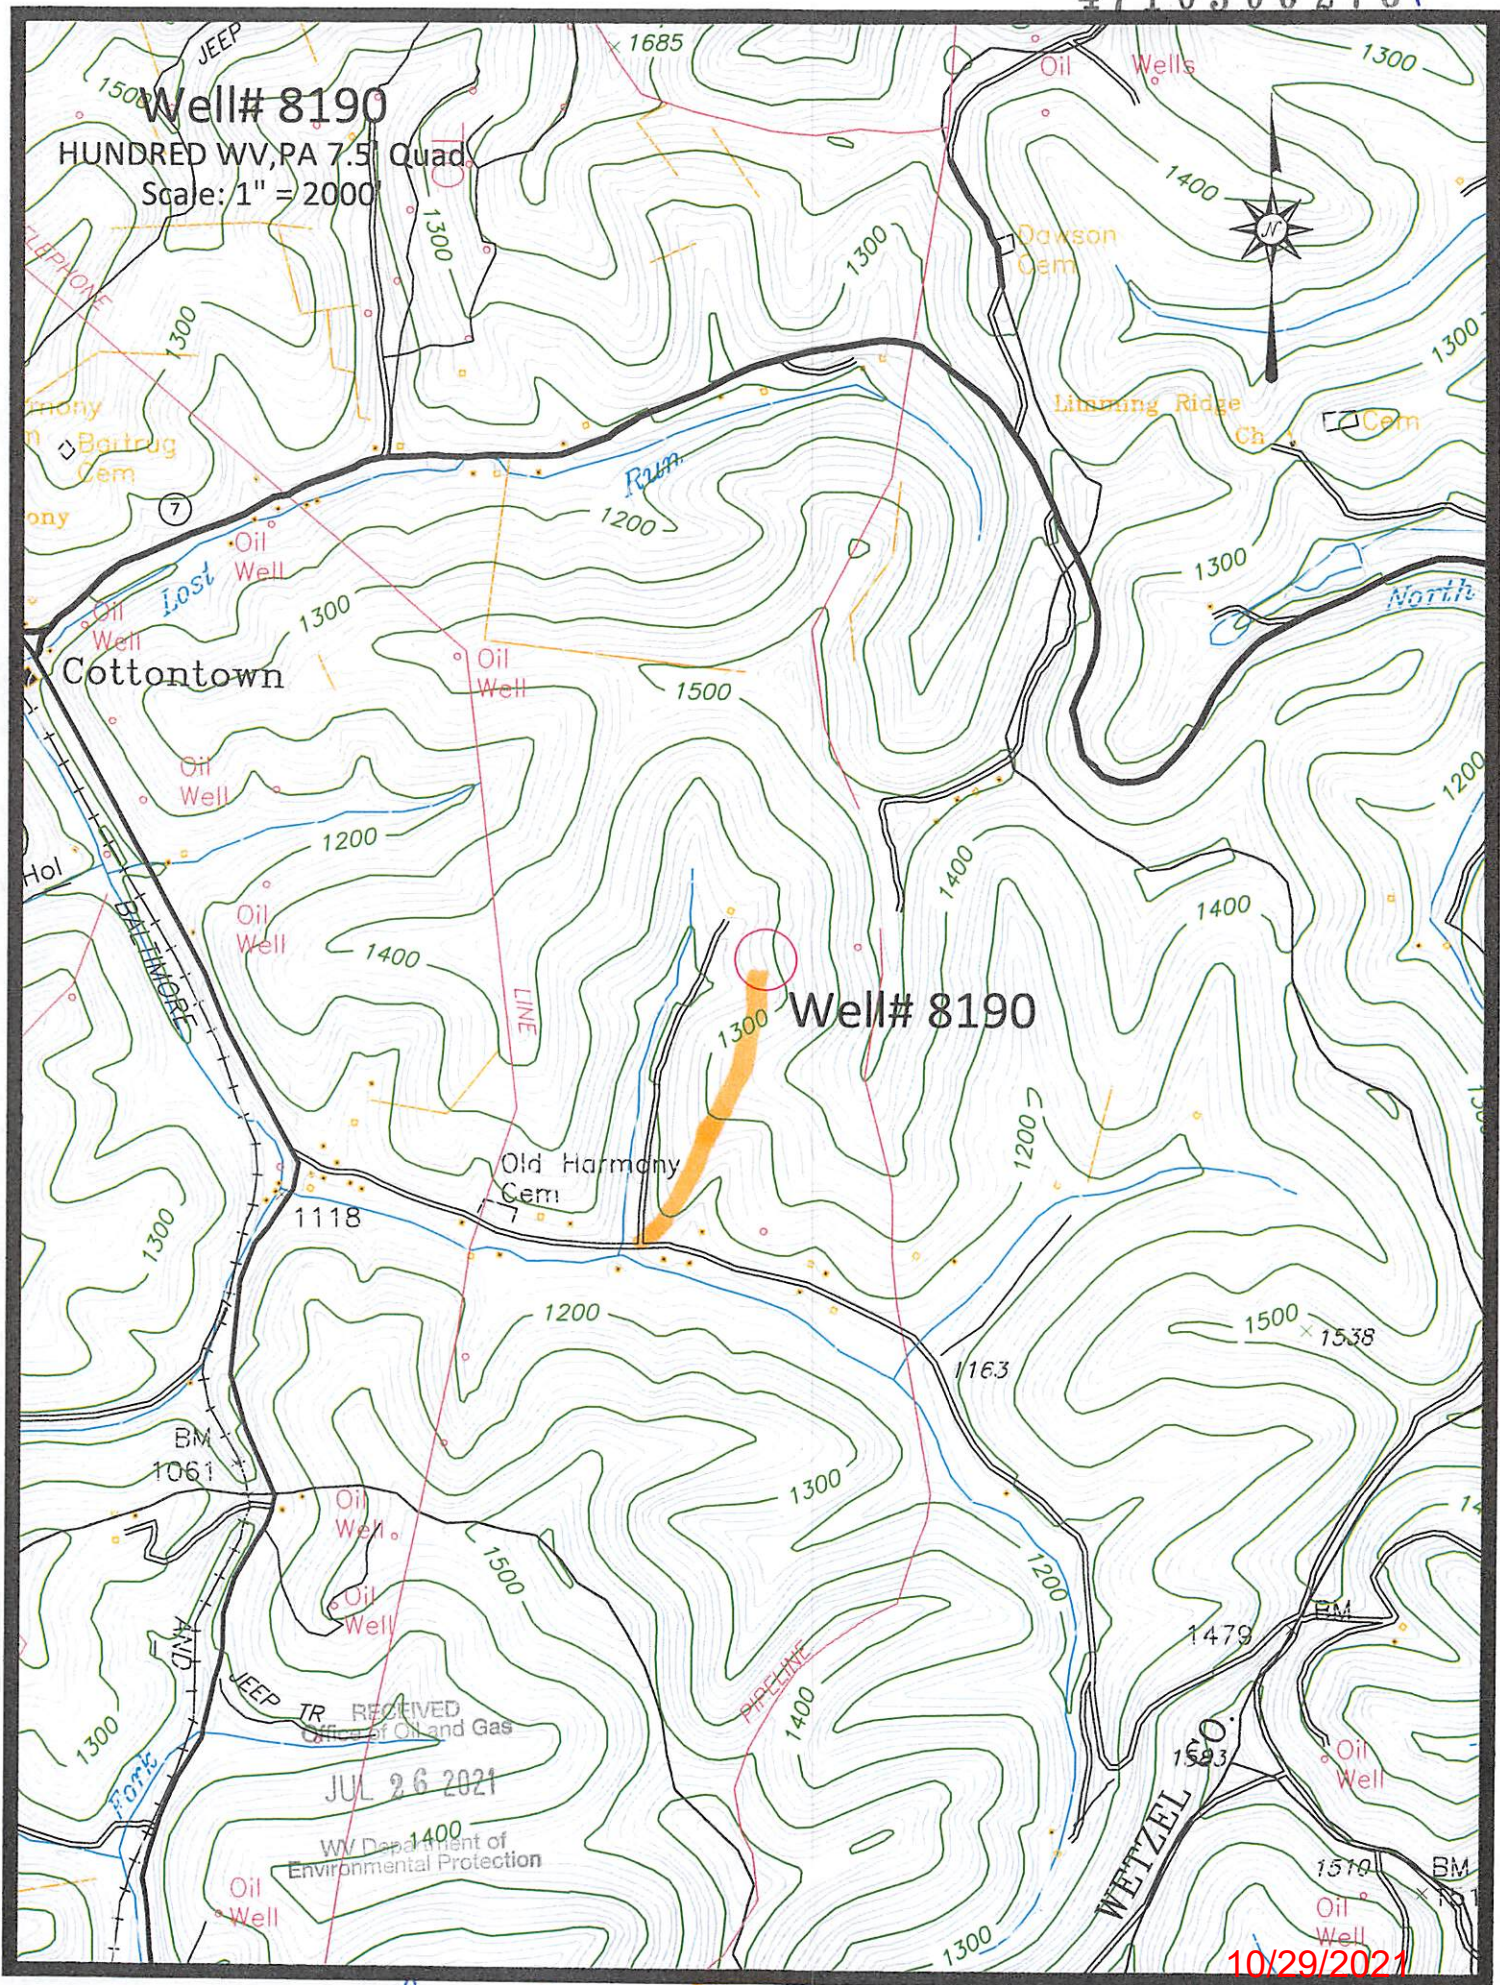

TR RECEIVED
Office of Oil and Gas
JUL 26 2021
WV Department of
Environmental Protection

10/29/2021


Well# 8190

HUNDRED WV, PA 7.5' Quad

Scale: 1" = 500'

Oil Well

1500



LINE

Well# 8190

1300

1400

Old Harmony Cem

1200

RECEIVED
Office of Oil and Gas

JUL 26 2021

WV Department of
Environmental Protection

10/29/2021

Access Road

