

RECEIVED
Office of Oil and Gas
FEB 09 2026
WV Department of Environmental Protection

Arrow Run

04/10/2026

Well# 7411
BIG RUN WV 7.5' Quad
Scale: 1" = 500'


Gas Well



TRAIL;

DEEP

Well# 7411

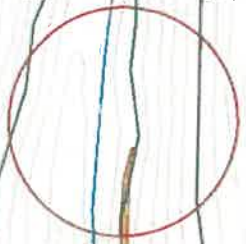

1100

1300

1300


1500

1500

RECEIVED
Office of Oil and Gas
FEB 09 2026
WV Department of
Environmental Protection

Access Road 

04/10/2026

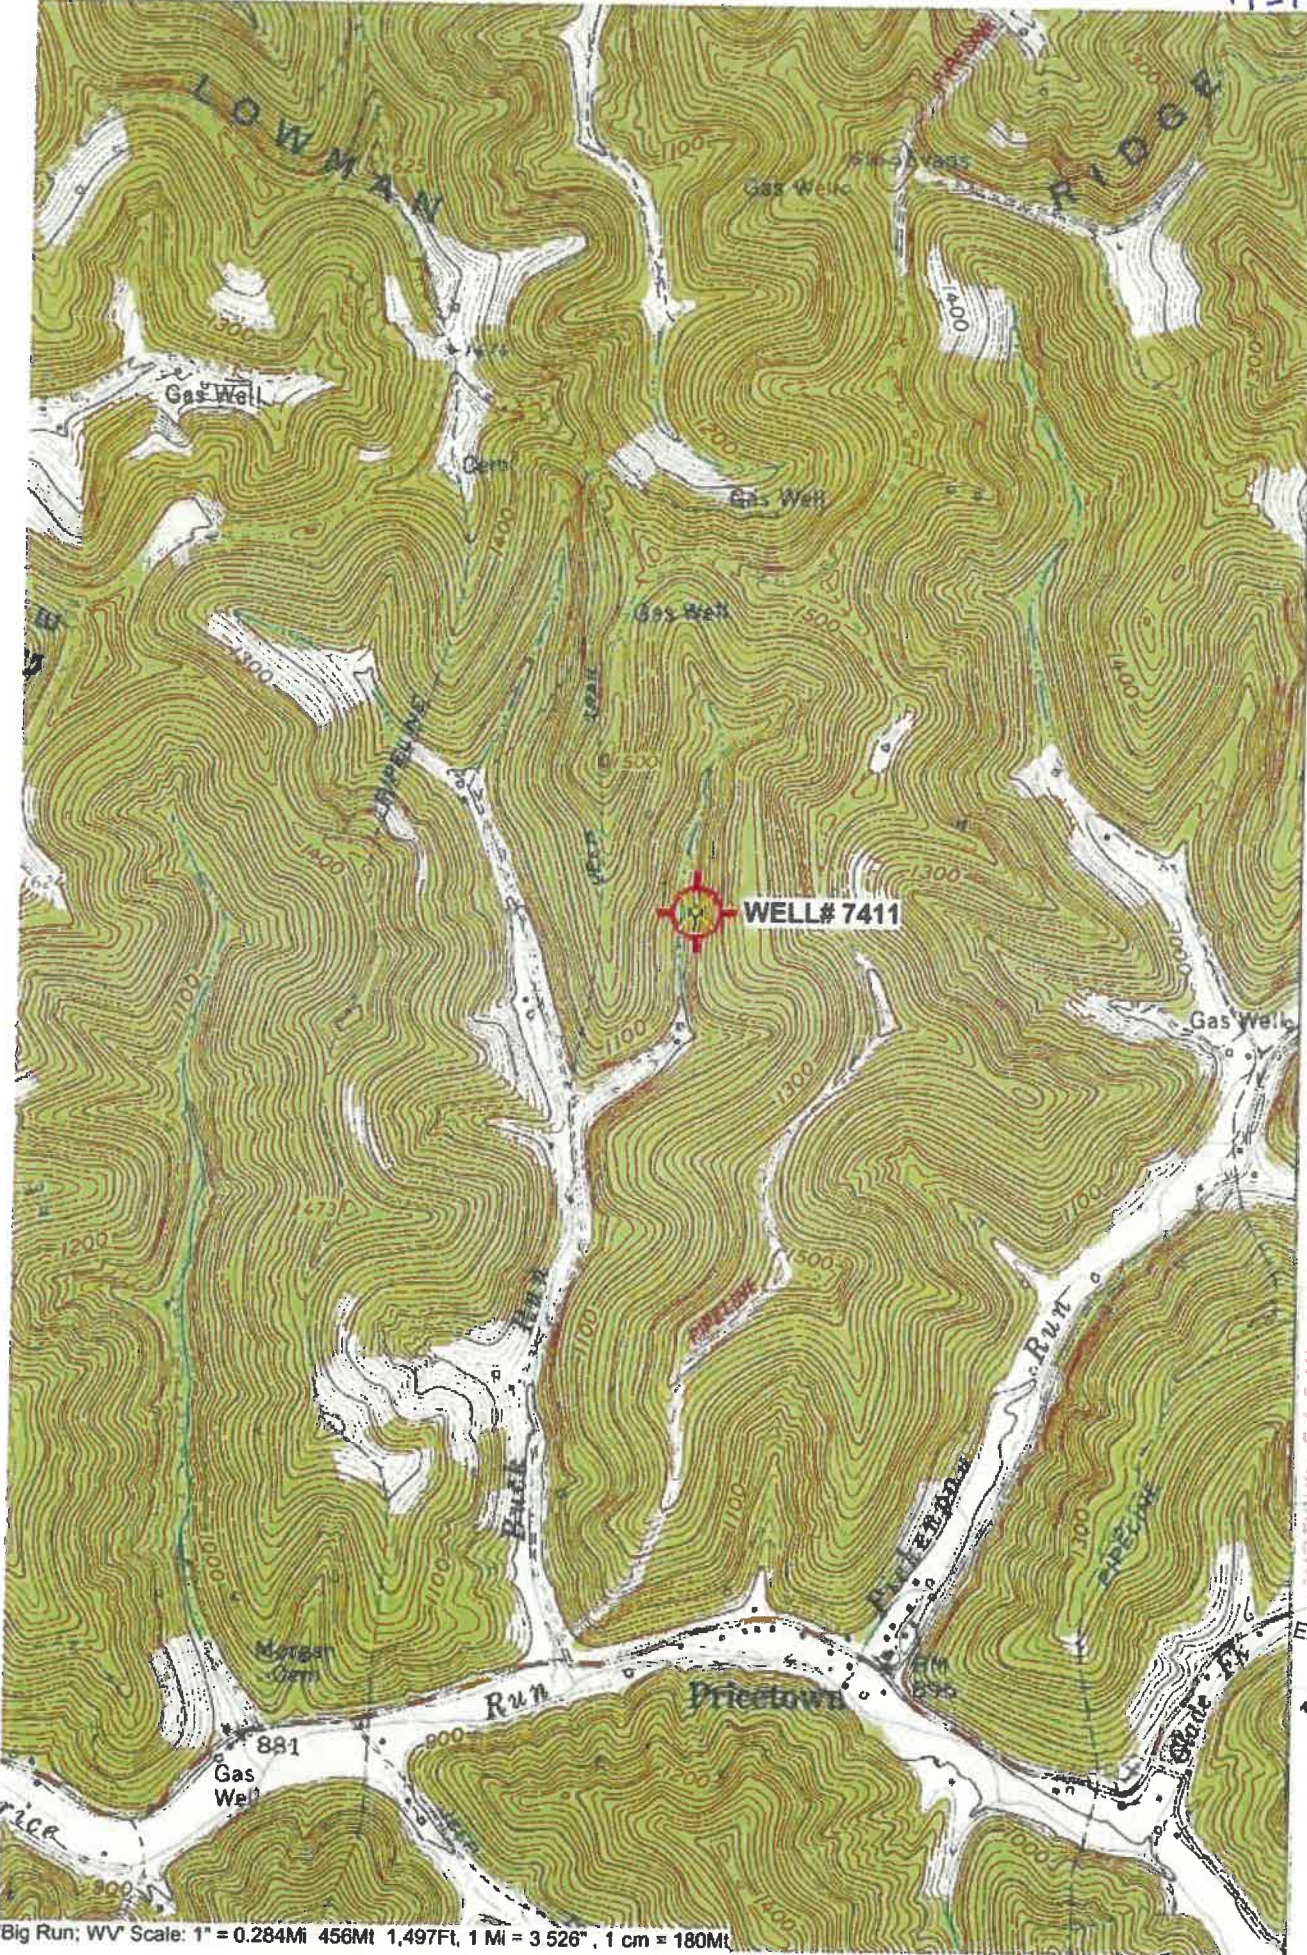

4377
32'30"

4375

4375

4374

CURTISVILLE 4.5 MI

RECEIVED
Office of Oil and Gas
FEB 09 2026
WV Department of
Environmental Protection

4373000N

'Big Run; WV Scale: 1" = 0.284Mi 456Ml 1,497Ft, 1 Mi = 3 526", 1 cm = 180Ml

WW-7
8-30-06



West Virginia Department of Environmental Protection
Office of Oil and Gas

WELL LOCATION FORM: GPS

API: 47-103-00446 WELL NO.: 7411

FARM NAME: JW NORRIS #8

RESPONSIBLE PARTY NAME: WEST VIRGINIA LAND RESOURCES INC.

COUNTY: WETZEL DISTRICT: GRANT

QUADRANGLE: BIG RUN WV

SURFACE OWNER: TALL TIMBER INC

ROYALTY OWNER: _____

UTM GPS NORTHING: 4,375,132 m (1092')

UTM GPS EASTING: 541,489 m GPS ELEVATION: 333 m

The Responsible Party named above has chosen to submit GPS coordinates in lieu of preparing a new well location plat for a plugging permit or assigned API number on the above well. The Office of Oil and Gas will not accept GPS coordinates that do not meet the following requirements:

- Datum: NAD 1983, Zone: 17 North, Coordinate Units: meters, Altitude: height above mean sea level (MSL) - meters.
- Accuracy to Datum - 3.05 meters
- Data Collection Method:
Survey grade GPS x : Post Processed Differential X

Real-Time Differential _____

Mapping Grade GPS _____ : Post Processed Differential _____

Real-Time Differential _____

- Letter size copy of the topography map showing the well location.**

I the undersigned, hereby certify this data is correct to the best of my knowledge and belief and shows all the information required by law and the regulations issued and prescribed by the Office of Oil and Gas.

Signature

PS 2002

Title

JANUARY 29, 2026

Date

RECEIVED
Office of Oil and Gas

FEB 09 2026

WV Department of
Environmental Protection