

WELL#7485  
GLOVER GAP WV 7.5' Quad  
Scale: 1" = 500'


PIPELINE

WELL#7485

WETZEL  
MARION

BM

980

1100

1300



Access Road


02/13/2026





 Access Road

02/13/2026

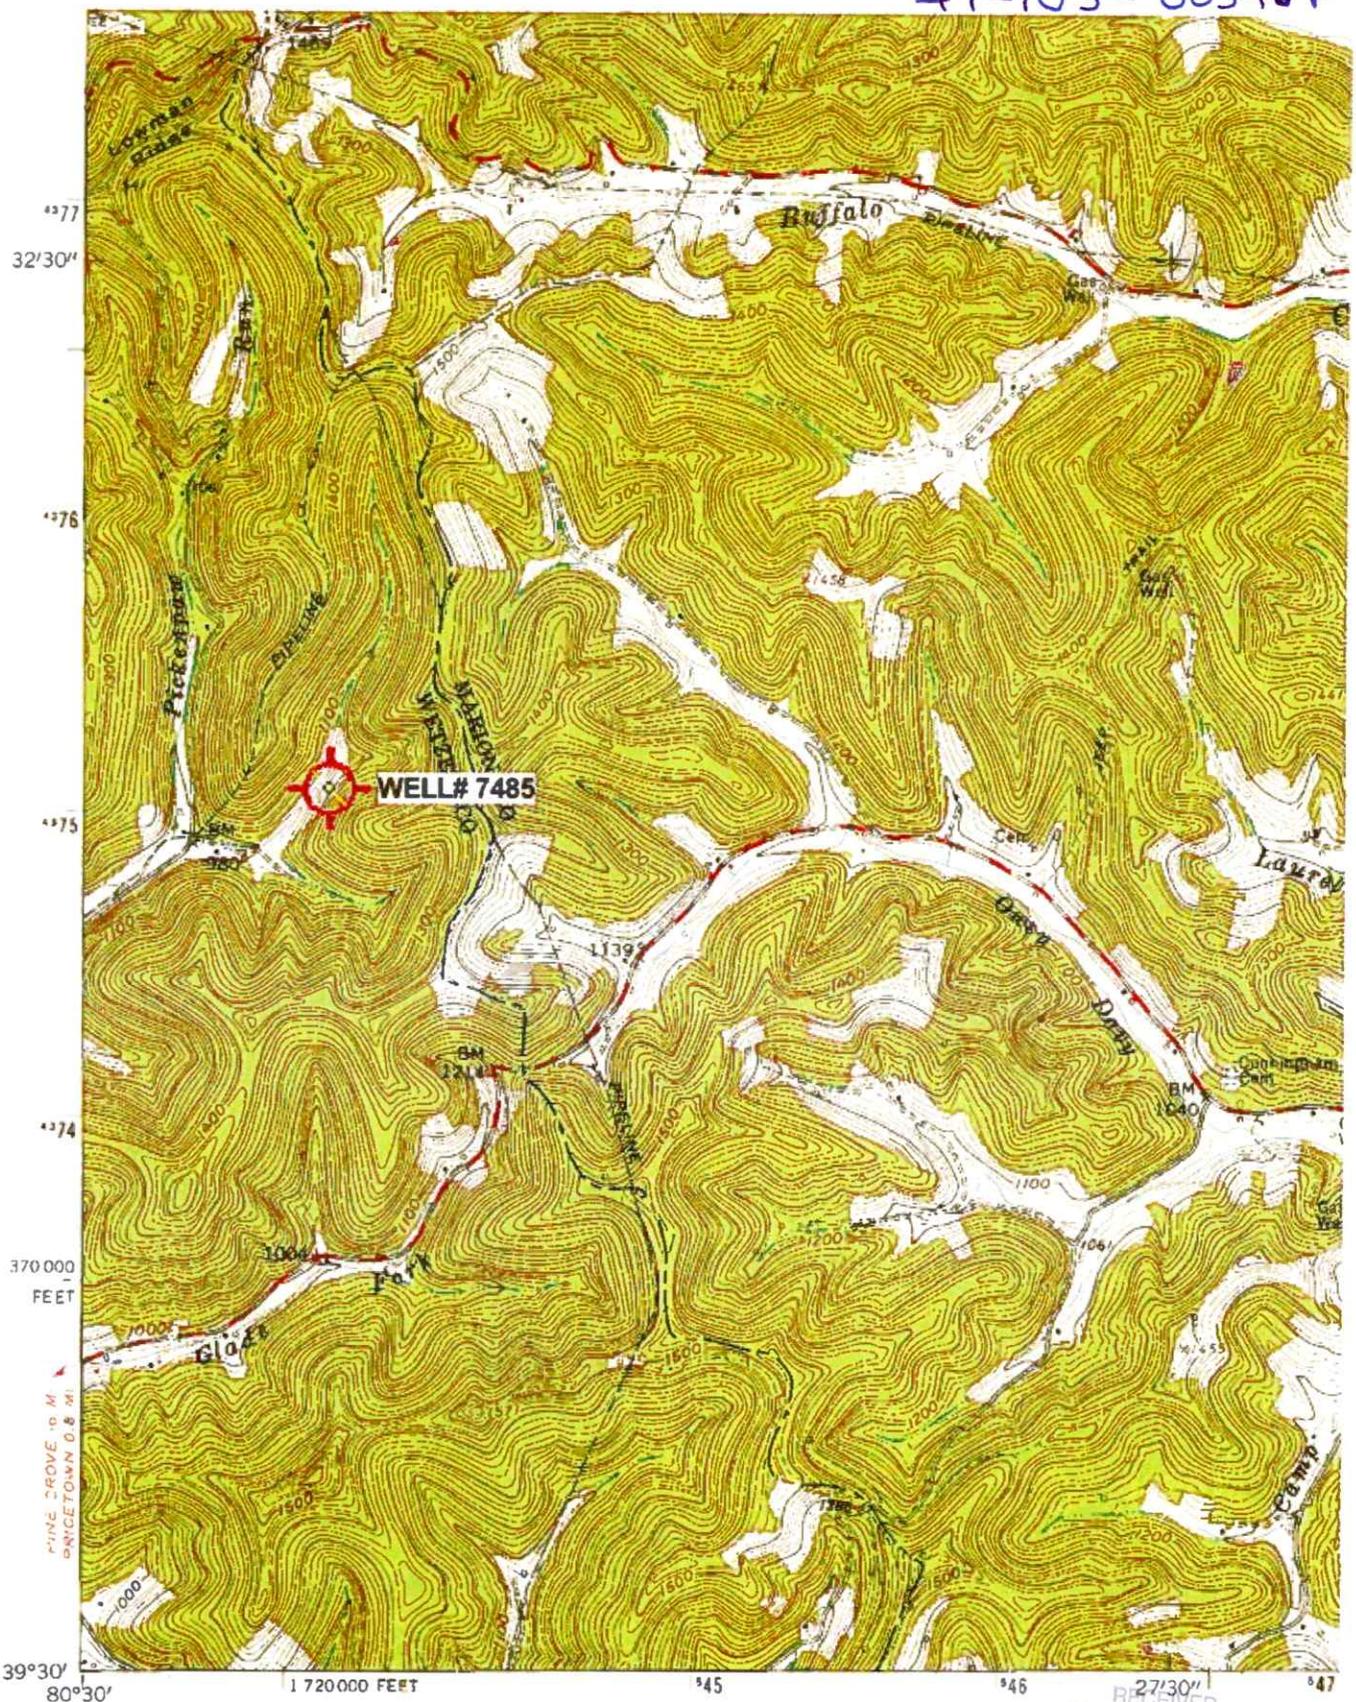

(FOL SOM)  
48821 NE

Mapped, edited, and published by the Geological Survey  
Control by USGS and USC&GS

Topography from aerial photographs by photogrammetric methods  
Aerial photographs taken 1957. Field check 1960

Polyconic projection. 1927 North American datum  
10,000-foot grid based on West Virginia coordinate system,  
north zone


1000-meter Universal Transverse Mercator grid ticks,

'Glover Gap; WV Scale: 1" = 0.379Mi 610Mt 2,000Ft, 1 Mi = 2.640", 1 cm = 240Mt

RECEIVED  
Office of Oil and Gas

DEC 05 2025

WV Department of  
Environmental Protection

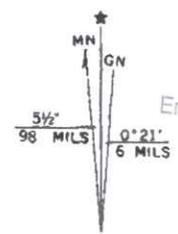

02/13/2026

WW-7  
8-30-06



West Virginia Department of Environmental Protection  
Office of Oil and Gas  
**WELL LOCATION FORM: GPS**

API: 47-103-00596 WELL NO.: 7485

FARM NAME: USBM-1

RESPONSIBLE PARTY NAME: WEST VIRGINIA LAND RESOURCES INC.

COUNTY: WETZEL DISTRICT: GRANT

QUADRANGLE: GLOVER GAP WV

SURFACE OWNER: COASTAL FOREST RESOURCES CO

ROYALTY OWNER: \_\_\_\_\_

UTM GPS NORTHING: 4,375,296 m

UTM GPS EASTING: 543,804 m GPS ELEVATION: 333 m

The Responsible Party named above has chosen to submit GPS coordinates in lieu of preparing a new well location plat for a plugging permit or assigned API number on the above well. The Office of Oil and Gas will not accept GPS coordinates that do not meet the following requirements:

- Datum: NAD 1983, Zone: 17 North, Coordinate Units: meters, Altitude: height above mean sea level (MSL) – meters.
- Accuracy to Datum – 3.05 meters
- Data Collection Method:

Survey grade GPS  : Post Processed Differential


Real-Time Differential \_\_\_\_\_

Mapping Grade GPS \_\_\_\_\_ : Post Processed Differential \_\_\_\_\_

Real-Time Differential \_\_\_\_\_

- Letter size copy of the topography map showing the well location.**

I the undersigned, hereby certify this data is correct to the best of my knowledge and belief and shows all the information required by law and the regulations issued and prescribed by the Office of Oil and Gas.

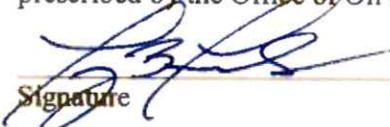  
Signature

PS 2002  
Title

NOVEMBER 18, 2025  
Date

RECEIVED  
Office of Oil and Gas  
DEC 05 2025  
WV Department of  
Environmental Protection