


FILE NO. 86
 MAP N69 S09 N8 E4
 SCALE 1" = 800'
 MINIMUM DEGREE OF ACCURACY 1 in 200
 PROVEN SOURCE OF ELEVATION Barr Tract No. 20
El. = 895.61'

I THE UNDERSIGNED, HEREBY CERTIFY THAT THIS PLAT IS CORRECT TO THE BEST OF MY KNOWLEDGE AND BELIEF AND SHOWS ALL THE INFORMATION REQUIRED BY LAW AND THE REGULATIONS ISSUED AND PRESCRIBED BY THE DEPARTMENT OF MINES.
 (SIGNED) Curtis A. Lucas
CURTIS A. LUCAS LLS 275

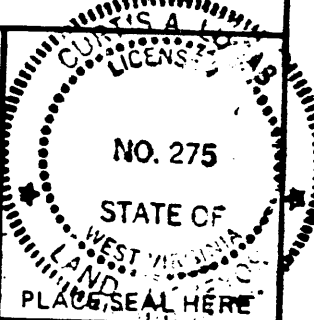

(+) DENOTES LOCATION OF WELL ON UNITED STATES TOPOGRAPHIC MAPS
 FORM IV-6 (8-78)



DATE 7-24 1981
 FARM BARR TRACT NO. 15
 API WELL NO. 47-103-0925-P
 STATE 47 COUNTY 103 PERMIT 0925-P

STATE OF WEST VIRGINIA
 DEPARTMENT OF MINES
 OIL AND GAS DIVISION

WELL TYPE: OIL GAS LIQUID INJECTION WASTE DISPOSAL
 (IF "GAS,") PRODUCTION STORAGE DEEP SHALLOW
 LOCATION: ELEVATION 873.08' WATER SHED North Fork of Fishing Creek
 DISTRICT Grant COUNTY Wetzel
 QUADRANGLE Big Run 75'
 SURFACE OWNER Wm. Kilcoyne ACREAGE _____
 OIL & GAS ROYALTY OWNER Pennzoil Co. LEASE ACREAGE 1003.75 ac.
 LEASE NO. Fee 2676
 PROPOSED WORK: DRILL CONVERT DRILL DEEPER REDRILL FRACTURE OR STIMULATE PLUG OFF OLD FORMATION PERFORATE NEW FORMATION OTHER PHYSICAL CHANGE IN WELL (SPECIFY) _____

PLUG AND ABANDON CLEAN OUT AND REPLUG
 TARGET FORMATION Injun ESTIMATED DEPTH 1995'
 WELL OPERATOR PENNZOIL COMPANY DESIGNATED AGENT JAMES A. CREWS
 ADDRESS P. O. BOX 1588 ADDRESS P. O. BOX 1588
PARKERSBURG, W. V. 26101 PARKERSBURG, W. V. 26101

OCT 08 1981

STATE OF WEST VIRGINIA
DEPARTMENT OF MINES
OIL AND GAS WELLS DIVISION

RECEIVED

DEC 24 1981

OIL AND GAS DIVISION
WV DEPARTMENT OF MINES

AFFIDAVIT OF PLUGGING AND FILLING WELL

AFFIDAVIT SHOULD BE MADE IN TRIPPLICATE, ONE COPY MAILED TO THE DEPARTMENT, ONE COPY TO BE RETAINED BY THE WELL OPERATOR AND THE THIRD COPY (AND EXTRA COPIES IF REQUIRED) SHOULD BE MAILED TO EACH COAL OPERATOR AT THEIR RESPECTIVE ADDRESSES.

Consolidated Coal Company

 6451 Pleasant Street, 2nd Floor
 Library, PA

 ADDRESS

 COAL OPERATOR OR OWNER

 ADDRESS

 LEASE OR PROPERTY OWNER

 ADDRESS

PENNZOIL COMPANY

 NAME OF WELL OPERATOR
 P. O. Box 1588, Parkersburg, WV 26102-1588

 COMPLETE ADDRESS
 December 14, 19 81

 WELL AND LOCATION
 Grant District

 Wetzel County

 Well No. 15

 Barr Tract Farm

STATE INSPECTOR SUPERVISING PLUGGING.....

AFFIDAVIT

STATE OF WEST VIRGINIA,

County of Wetzel

SS:

Michael McCown and C. K. Echard

being first duly sworn according to law depose and say that they are experienced in the work of plugging and filling oil and gas wells and were employed by PENNZOIL COMPANY, well operator, and participated in the work of plugging and filling the above well, that said work was commenced on the 28th day of November, 1981, and that the well was plugged and filled in the following manner:

SAND OR ZONE RECORD FORMATION	FILLING MATERIAL	PLUGS USED		CASING	
		SIZE & KIND	CSG PULLED	CSG LEFT IN	
Total Depth 1995	Gell 1995 - 1798		5 1/2" 1709'	161'	
Big Injun 1895-1995	Cement (50 Sks.)-----	1798 - 1578	7" 793'	901'	
Big Lime 1840-1895	Gell 1578 - 665				
Third Salt 1500-1640	Cement (125 Sks.)-----	665 - 400			
Cow Run 1160-1180	Gell 400 - 347				
	Cement (50 Sks.)-----	347 - 300			
	Gell 300 - 50				
	Cement (50 Sks.)-----	50 - 0			
COAL SEAMS	Pittsburgh Coal 600 -	DESCRIPTION OF MONUMENT			
(NAME)		7" Pipe ---2 1/2' in height filled with			
(NAME)		cement with proper well identification			
(NAME)		on monument.			
(NAME)					

and that the work of plugging and filling said well was completed on the 4th day of December, 19 81.

And further deponents saith not.

Michael McCown
C. K. Echard

Sworn to and subscribed before me this _____ day of _____, 19 _____.

My commission expires: _____

Notary Public.

Permit No. 77-103-092