

477  
32'30"  
476  
475  
474  
473  
39° 30'  
80° 30'

39 32'30" 40

RECEIVED  
Office of Oil and Gas

JAN 28 2026

WV Department of Environmental Protection  
Heavy-duty  
Medium duty

ROAD CLASSIFICATION

Light-duty  
Unimproved dirt  
Slate Route

(WALLACE)  
2002/11/10



QUADRANGLE LOCATION

BIG RUN, W. VA.

SF/4 LITTLETON 15' QUADRANGLE  
N3930—W8030/7.5

03/06/2026

Well # 7389  
BIG RUN W/ 7.5' Quad  
Scale 1" = 2000'

Well # 7389

RECEIVED  
Office of Oil and Gas  
JAN 28 2004

Department of Environmental Protection


03/06/2026

Big Run

Well# 7389

BIG RUN WV 7 04

Scale: 1" = 500

Well

TRAIL;

SEEP



Well# 7389

1300

1100

RECEIVED  
Office of Oil and Gas

JAN 28 2026

WV Dept  
Environment

03/06/2026

WW-7  
8-30-06



West Virginia Department of Environmental Protection  
Office of Oil and Gas

**WELL LOCATION FORM: GPS**

API: 47-103-01075 WELL NO.: 7389

FARM NAME: E.V. NORRIS

RESPONSIBLE PARTY NAME: WEST VIRGINIA LAND RESOURCES INC.

COUNTY: WETZEL DISTRICT: GRANT

QUADRANGLE: BIG RUN W.VA

SURFACE OWNER: ELIZABETH ALVA ELINE ETAL(JOAN E. GROTTENDICK L/E)

ROYALTY OWNER: \_\_\_\_\_

UTM GPS NORTHING: 4,375,342 m

UTM GPS EASTING: 541,694 m GPS ELEVATION: 425 m

The Responsible Party named above has chosen to submit GPS coordinates in lieu of preparing a new well location plat for a plugging permit or assigned API number on the above well. The Office of Oil and Gas will not accept GPS coordinates that do not meet the following requirements:

1. Datum: NAD 1983, Zone: 17 North, Coordinate Units: meters, Altitude: height above mean sea level (MSL) meters.
2. Accuracy to Datum 3.05 meters
3. Data Collection Method:

Survey grade GPS  : Post Processed Differential \_\_\_\_\_

Real-Time Differential

Mapping Grade GPS : Post Processed Differential \_\_\_\_\_

Real-Time Differential \_\_\_\_\_

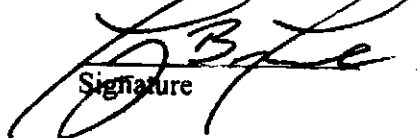
RECEIVED  
Office of Oil and Gas

JAN 28 2026

WV Department of  
Environmental Protection

4. Letter size copy of the topography map showing the well location.

I the undersigned, hereby certify this data is correct to the best of my knowledge and belief and shows all the information required by law and the regulations issued and prescribed by the Office of Oil and Gas.

  
Signature

PS2002  
Title

JANUARY 9, 2026

Date

03/06/2026