



DIVERSIFIED
energy

47-103-01076
Well Plugging Map


Legend

- Well
- Pits
- Pad
- Access Road
- Public Roads

RECEIVED
Office of Oil and Gas

FEB 25 2026

WV Department of
Environmental Protection

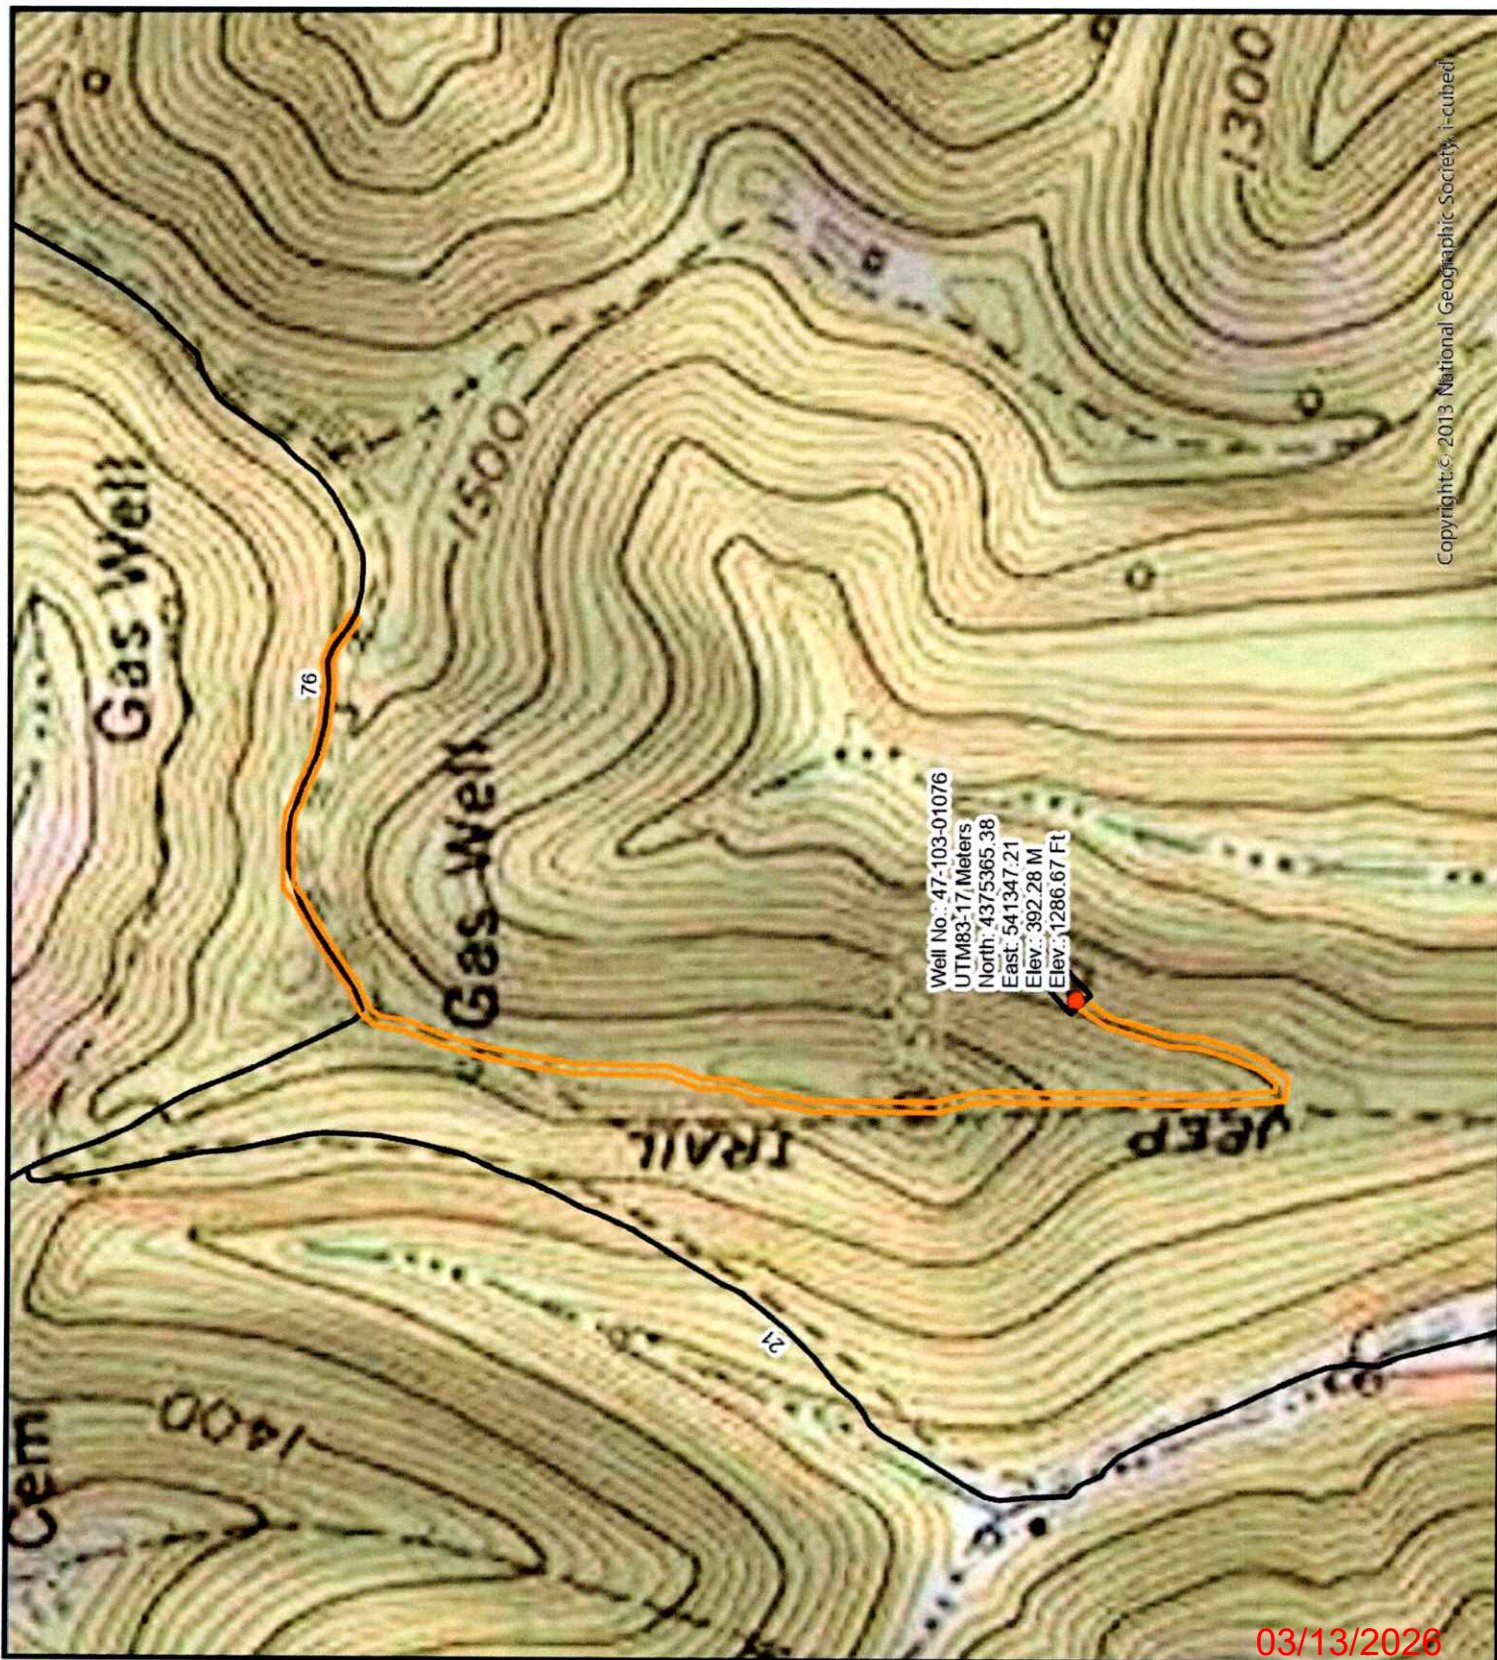

03/13/2026



DIVERSIFIED
energy

47-103-01076

Well Plugging Map



Legend

-  Well
-  Pad
-  Access Road
-  Public Roads

RECEIVED
Office of Oil and Gas

FEB 25 2026

WV Department of
Environmental Protection

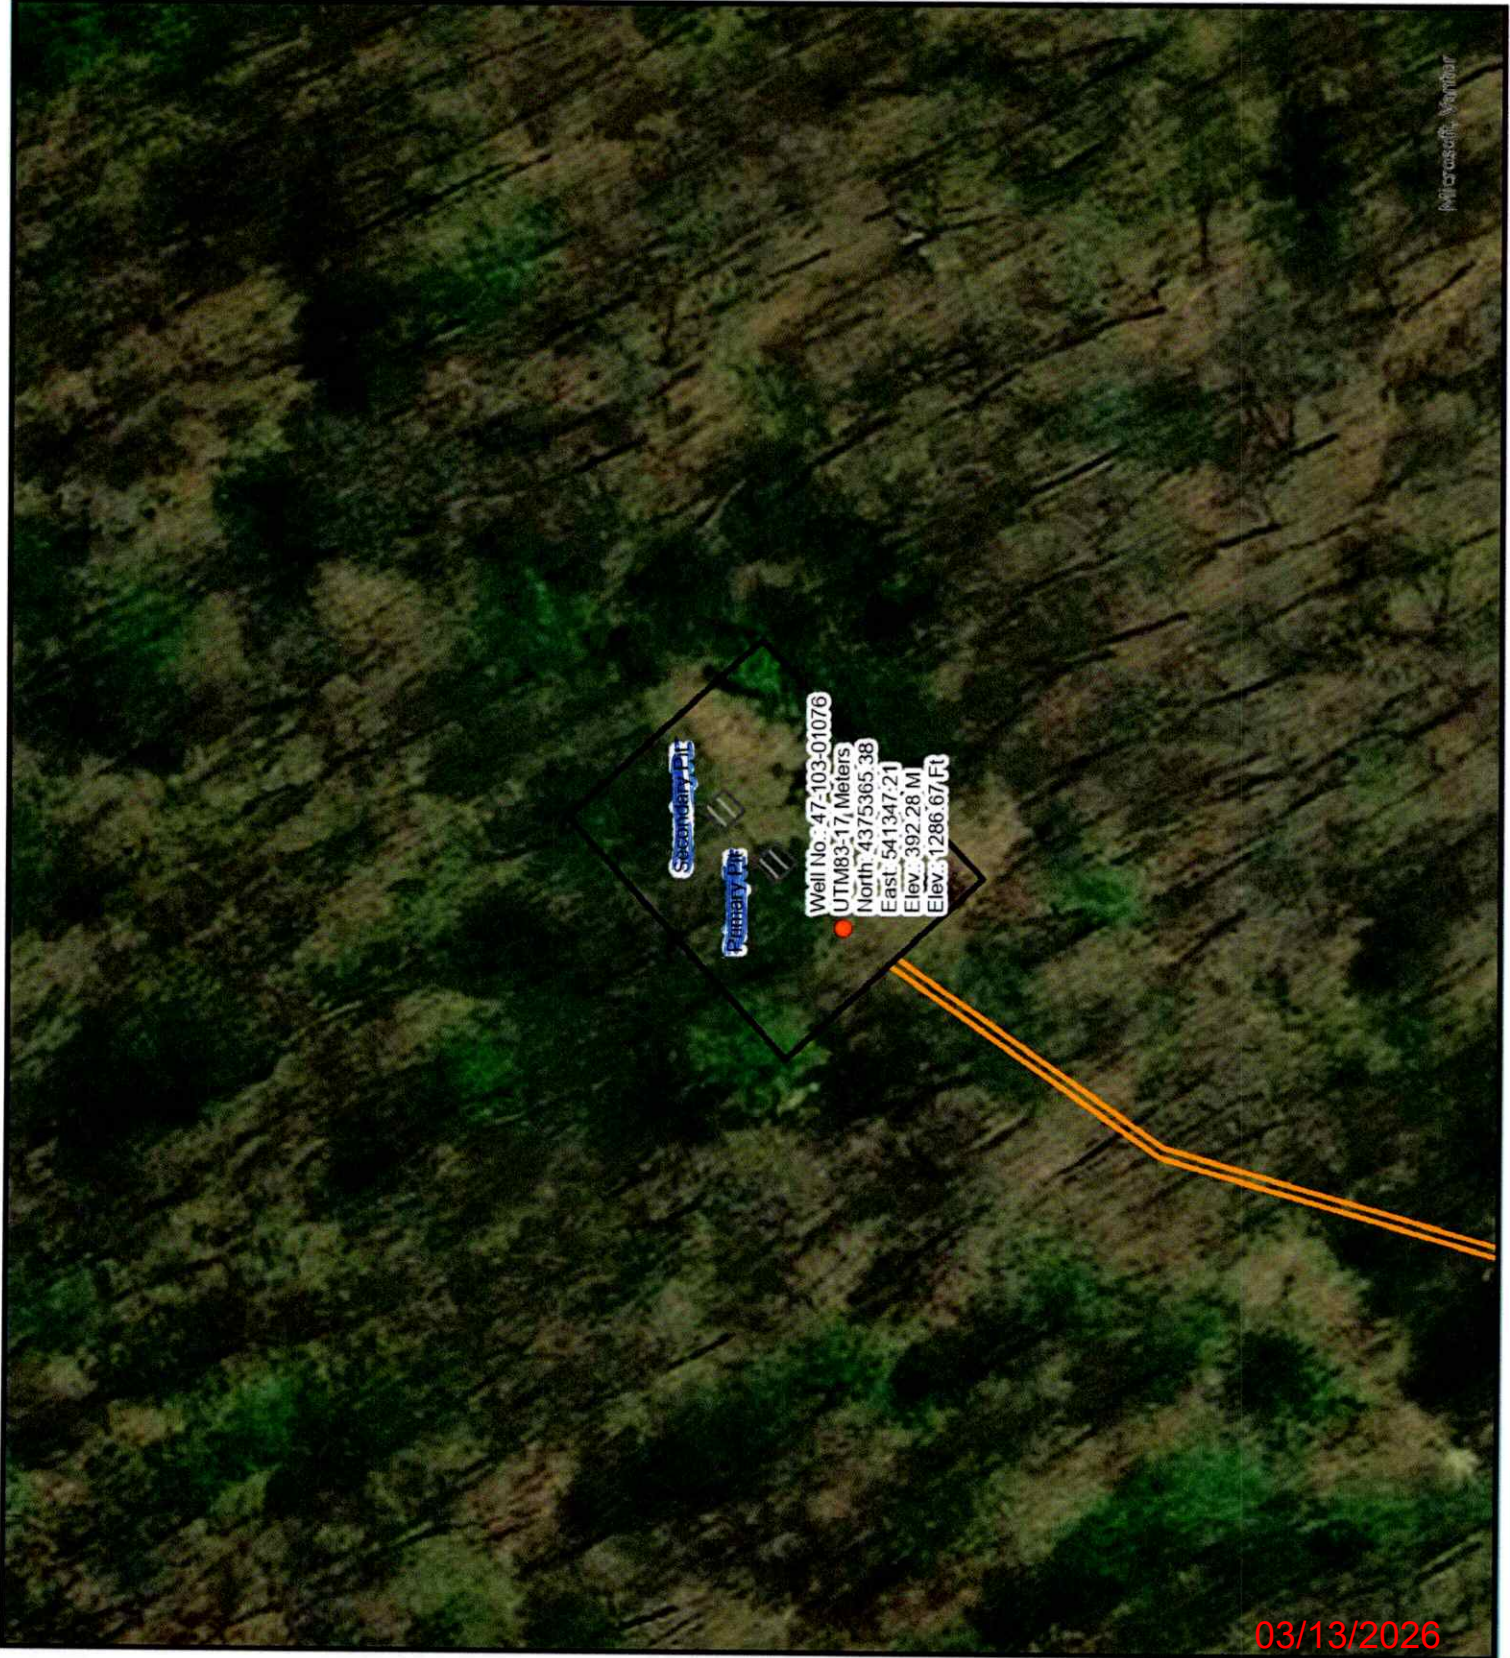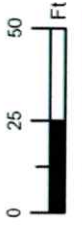

Microsoft, Windows

03/13/2026

WW-7
8-30-06



West Virginia Department of Environmental Protection
Office of Oil and Gas
WELL LOCATION FORM: GPS

API: 4710301076 WELL NO.: ACNR EV Norris #5

FARM NAME: Ensminger

RESPONSIBLE PARTY NAME: Diversified Production, LLC

COUNTY: Wetzel DISTRICT: Grant

QUADRANGLE: Big Run 7.5'

SURFACE OWNER: Joan E. Grottendick, L/E

ROYALTY OWNER: Deborah Knisely & Douglas Newman

UTM GPS NORTHING: 4375365.38


UTM GPS EASTING: 541347.21 GPS ELEVATION: 1286.67'

The Responsible Party named above has chosen to submit GPS coordinates in lieu of preparing a new well location plat for a plugging permit or assigned API number on the above well. The Office of Oil and Gas will not accept GPS coordinates that do not meet the following requirements:

- Datum: NAD 1983, Zone: 17 North, Coordinate Units: meters, Altitude height above mean sea level (MSL) – meters.
- Accuracy to Datum – 3.05 meters
- Data Collection Method:
Survey grade GPS ____: Post Processed Differential ____
Real-Time Differential ____
Mapping Grade GPS X: Post Processed Differential X
Real-Time Differential ____

4. **Letter size copy of the topography map showing the well location.**

I the undersigned, hereby certify this data is correct to the best of my knowledge and belief and shows all the information required by law and the regulations issued and prescribed by the Office of Oil and Gas.


Nicholas Bumgardner (Feb. 19, 2026 11:03:20 EST)
Signature

Nick Bumgardner- Supervisor Plugging Operations
Title

2/19/26
Date

RECEIVED
Office of Oil and Gas
FEB 25 2026
WV Department of
Environmental Protection

03/13/2026