



1 MILE  
 7000 FEET  
 1 METER

RECEIVED  
 Office of Oil and Gas

JAN 28 2026



Revisions shown in purple compiled in cooperation with State of West Virginia agencies from aerial photographs

'Big Run; WV' Scale: 1" = 0.379Mi 610Mt 2,000Ft, 1 Mi = 2.640" , 1 cm = 240Mt

ROAD CLASSIFICATION

- Heavy-duty —————
- Med um duty —————
- Lght duty —————
- Un mproved dirt - - - - -
- State Route —————

BIG RUN, W. VA.

SE/4 LITTLETON 15' QUADRANGLE  
 N3930—W8030/7.5

1960  
 PHOTOREVISED 1976

03/06/2026

(WALLACE)  
 4882 N/NN

Well# 7391

BIG RUN WY 7.5' Quad

Scale: 1" = 2000'

Gas Well

Gas Well

1500

1400

TRAIL

1500

DEEP

1300

Well #7391

1100

1300

1100

PIPELINE

1500

Run

1100

Run

RECEIVED  
Office of Oil and Gas

JAN 28 2026

WV Department of  
Environmental Protection

 Access Road

03/06/2026

Well# 7391

BIG RUN WV 7.5' Quad

Scale: 1" = 500'

Gas Well

1500

1400

TRAIL;  
DEEP

1500

1300

Well# 7391

1100

1300

1100

1500

PIPELINE

Run

1100

Run


RECEIVED  
Office of Oil and Gas

JAN 28 2026

WV Department of  
Environmental Protection

03/06/2026

Access Road

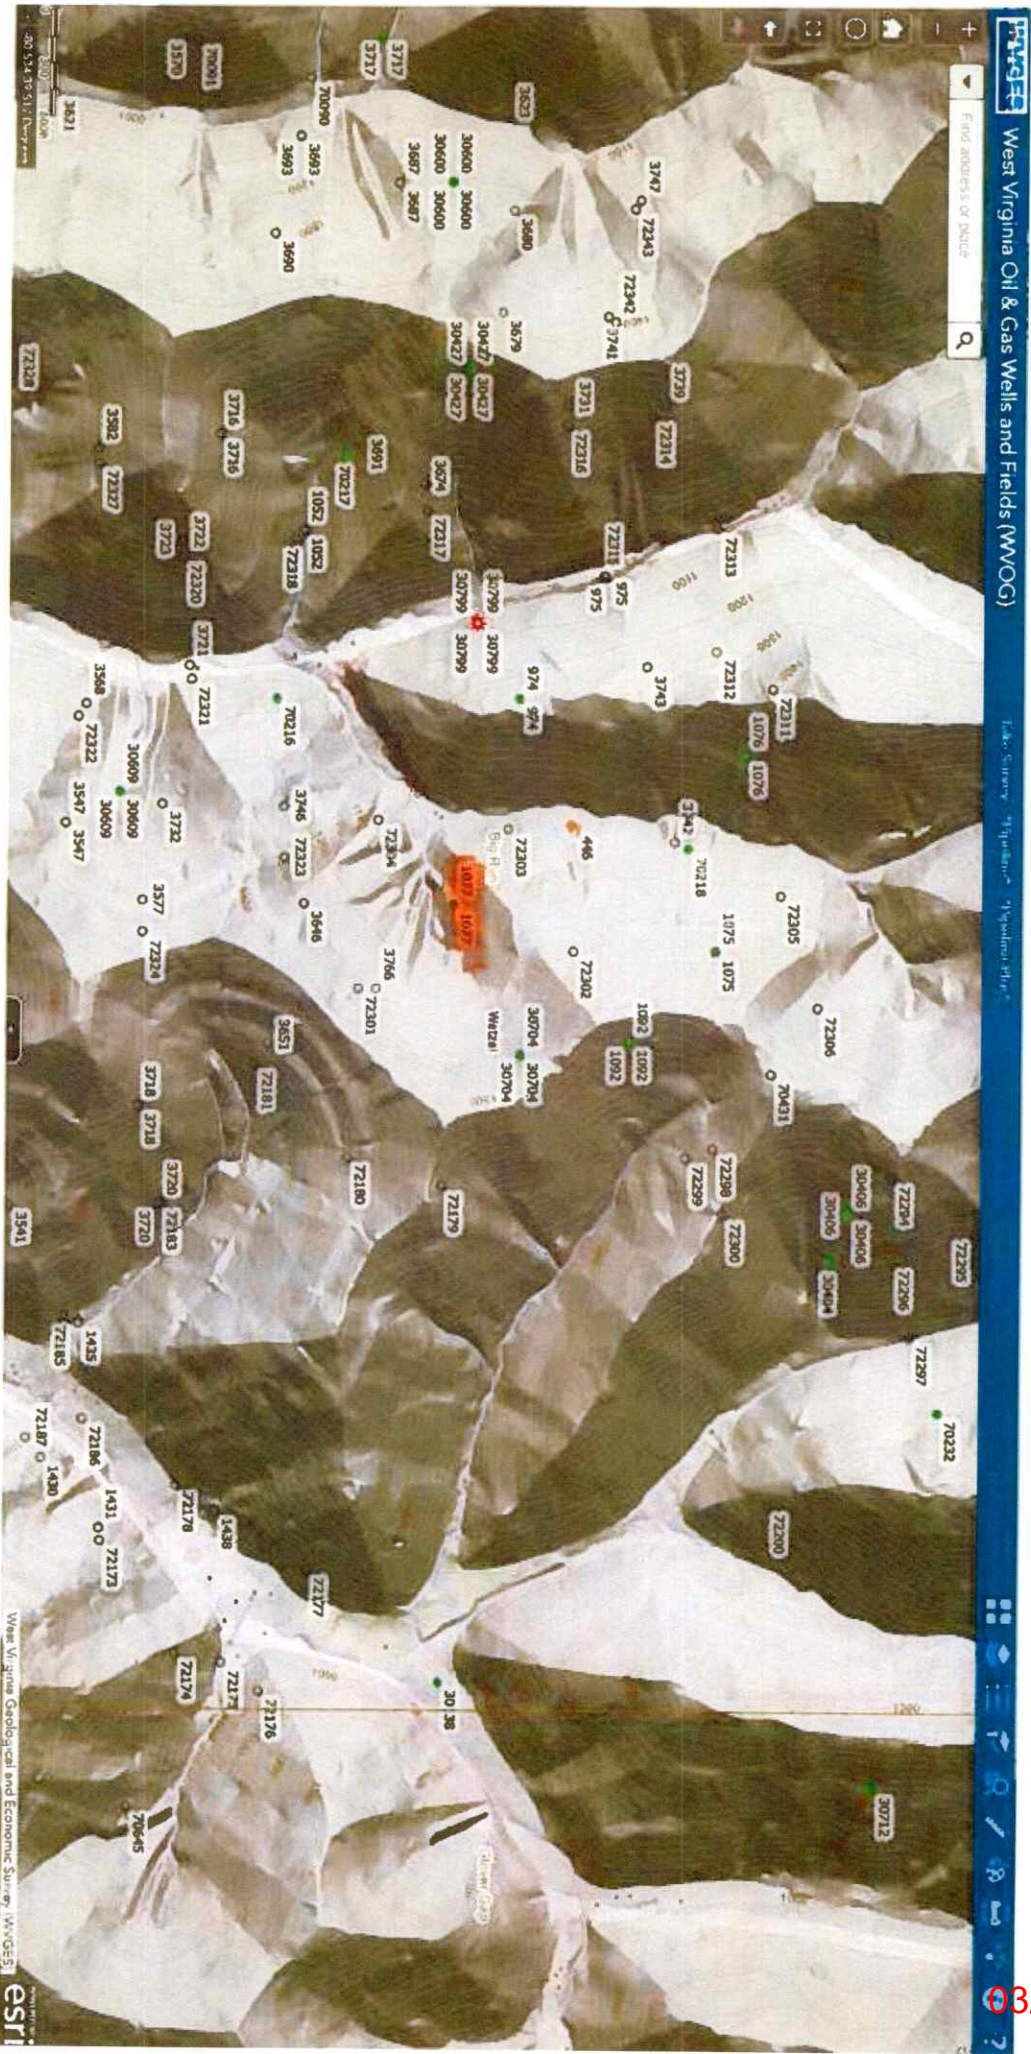

RECEIVED  
Office of Oil and Gas

JAN 28 2026

WV Department of  
Environmental Protection

03/06/2026

WW-7  
8-30-06



West Virginia Department of Environmental Protection  
Office of Oil and Gas  
**WELL LOCATION FORM: GPS**

API: 47-103-01077 WELL NO.: 7391

FARM NAME: J.W NORRIS #4

RESPONSIBLE PARTY NAME: WEST VIRGINIA LAND RESOURCES INC.

COUNTY: WETZEL DISTRICT: GRANT

QUADRANGLE: BIG RUN WV

SURFACE OWNER: TALL TIMBER INC

ROYALTY OWNER: \_\_\_\_\_

UTM GPS NORTHING: 4,374,897 m

UTM GPS EASTING: 541,628 m GPS ELEVATION: 354 m

The Responsible Party named above has chosen to submit GPS coordinates in lieu of preparing a new well location plat for a plugging permit or assigned API number on the above well. The Office of Oil and Gas will not accept GPS coordinates that do not meet the following requirements:


- Datum: NAD 1983, Zone: 17 North, Coordinate Units: meters, Altitude: height above mean sea level (MSL) – meters.
- Accuracy to Datum – 3.05 meters
- Data Collection Method:

Survey grade GPS  : Post Processed Differential   
Real-Time Differential \_\_\_\_\_

Mapping Grade GPS \_\_\_\_\_ : Post Processed Differential \_\_\_\_\_  
Real-Time Differential \_\_\_\_\_

- Letter size copy of the topography map showing the well location.

I the undersigned, hereby certify this data is correct to the best of my knowledge and belief and shows all the information required by law and the regulations issued and prescribed by the Office of Oil and Gas.

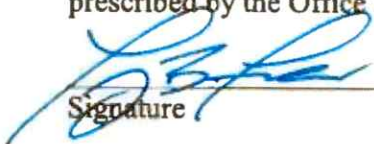  
Signature

PS 2002

Title

JANUARY 7, 2026

Date

RECEIVED  
Office of Oil and Gas

JAN 28 2026

WV Department of  
Environmental Protection

03/06/2026