


WVDEP Reclamation Plan Site Overview / Detail
 Victory B 4317 (API 47-103-01472-00-00)

- BMPs and erosion control devices to be utilized per WVDEP guidelines and Columbia's WV Environmental Construction Standards.
- Existing drainage, culverts, and road ditches to be maintained.
- Minor grading and surface material to be applied as needed.

Legend


- Victory B - 04317
- Victory B 4317 LOD
- 🚚 Victory B Access Route

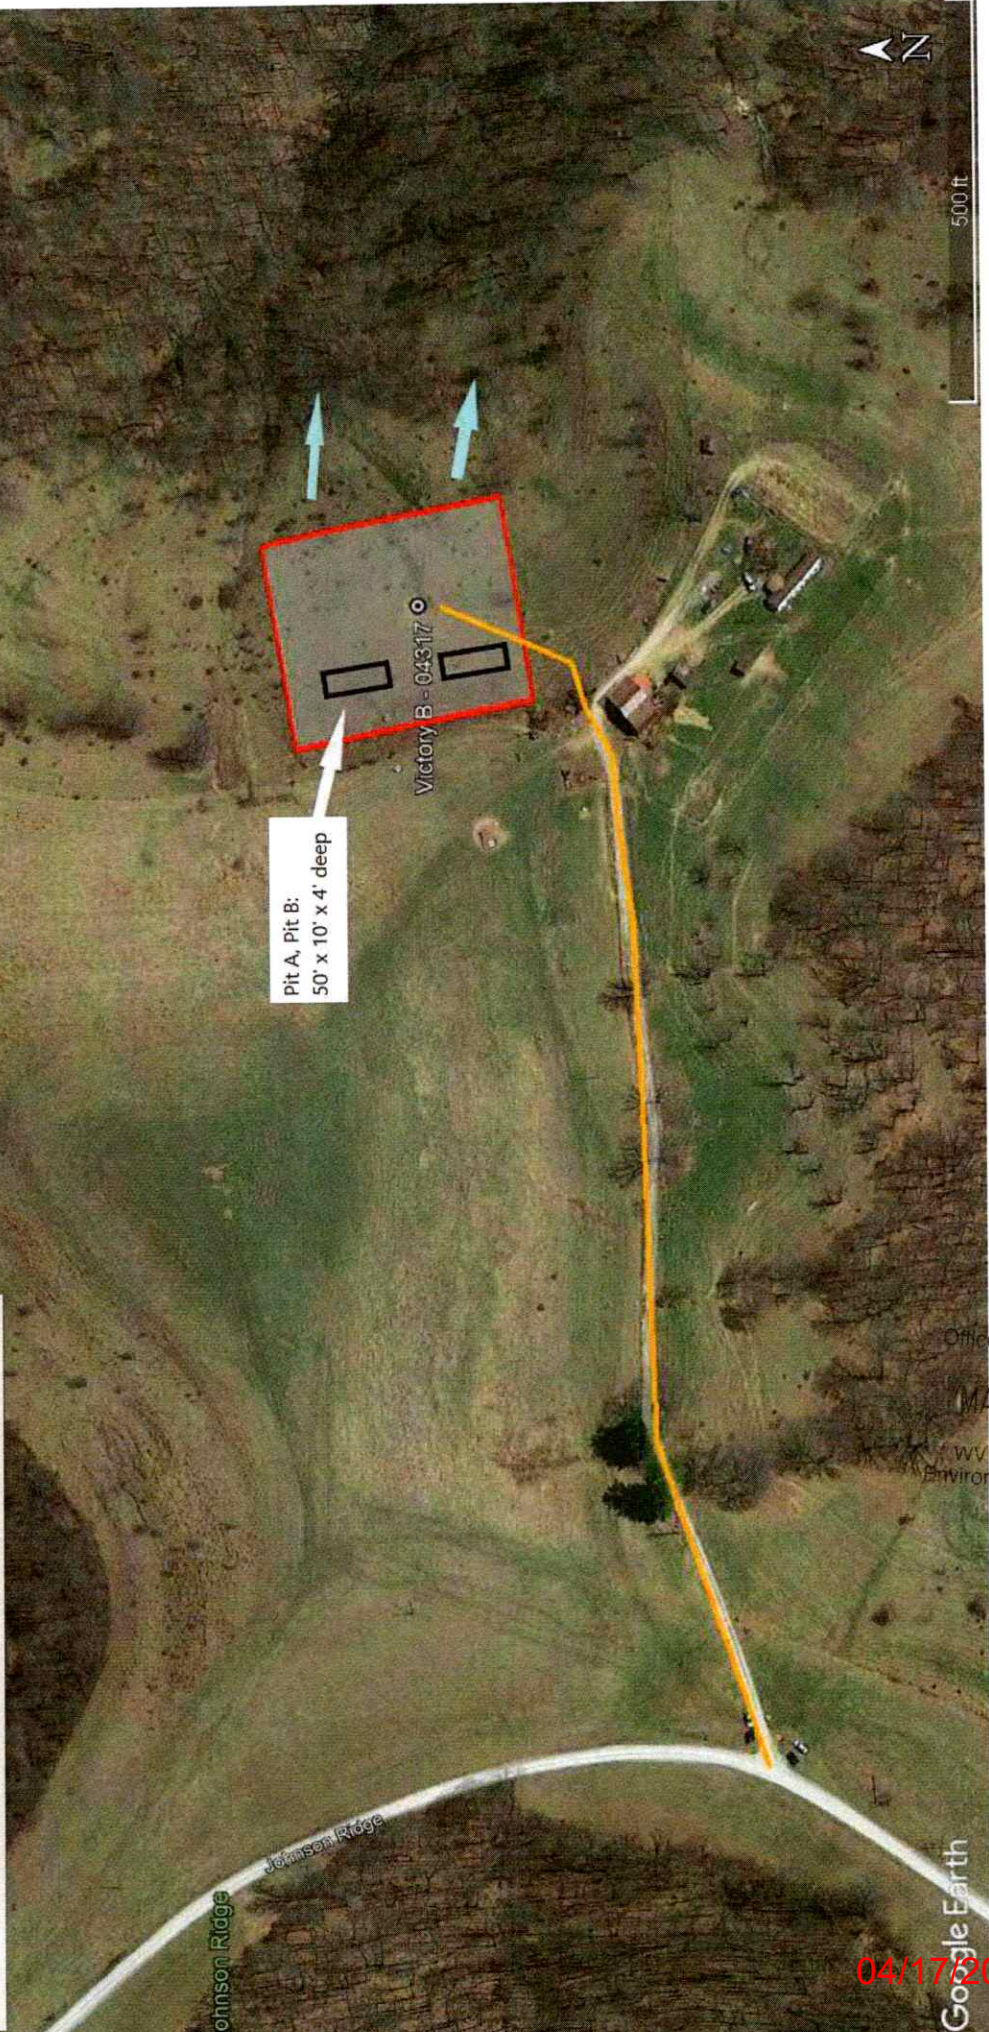

RECEIVED
 Office of Oil and Gas
 MAR 09 2026
 WV Department of Environmental Protection

04/17/2026

Google Earth



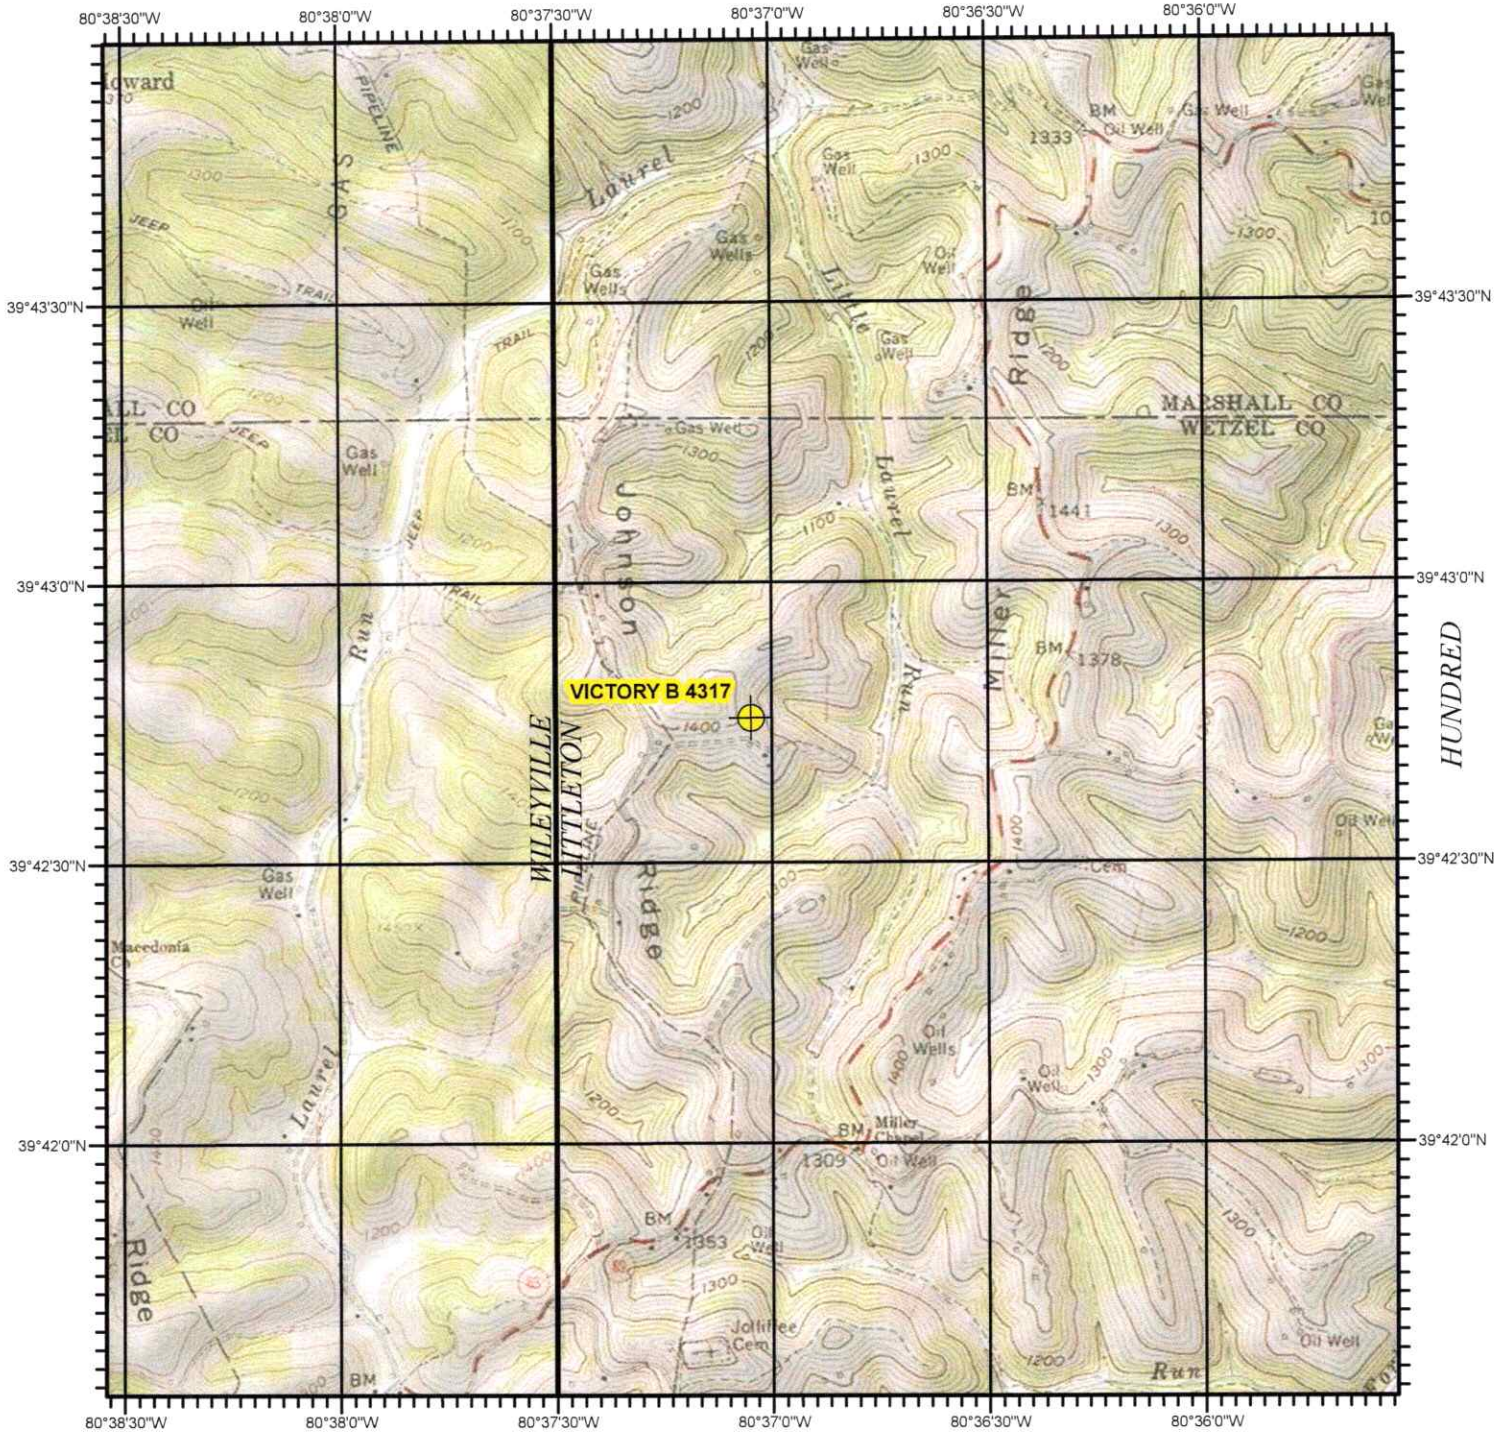


PINE GROVE

BIG RUN

RECEIVED GLOVER GAP
Office of Oil and Gas

VICTORY B 4317
WETZEL COUNTY, WV

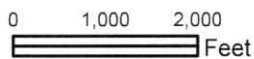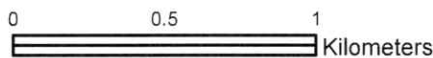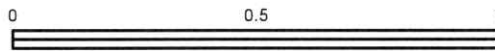

MAR 09 2026

WV Department of
Environmental Protection



WW-7
8-30-06



West Virginia Department of Environmental Protection
Office of Oil and Gas
WELL LOCATION FORM: GPS

API: 47-103-01472-00-00 WELL NO.: Victory B 4317

FARM NAME: CAIN, EUNICE R.

RESPONSIBLE PARTY NAME: Columbia Gas Transmission, LLC

COUNTY: Wetzel DISTRICT: Center

QUADRANGLE: Littleton

SURFACE OWNER: Martin R. & Lisa K. Whiteman

ROYALTY OWNER: Julia A. Cain; John C. Richards; PikeWood Energy Corporation

UTM GPS NORTHING: 4,395,933.959

UTM GPS EASTING: 532,790.033 GPS ELEVATION: 1,370'

The Responsible Party named above has chosen to submit GPS coordinates in lieu of preparing a new well location plat for a plugging permit or assigned API number on the above well. The Office of Oil and Gas will not accept GPS coordinates that do not meet the following requirements:

1. Datum: NAD 1983, Zone: 17 North, Coordinate Units: meters, Altitude: height above mean sea level (MSL) – meters.
2. Accuracy to Datum – 3.05 meters
3. Data Collection Method:
Survey grade GPS : Post Processed Differential

Real-Time Differential

Mapping Grade GPS : Post Processed Differential

Real-Time Differential

4. **Letter size copy of the topography map showing the well location.**

I the undersigned, hereby certify this data is correct to the best of my knowledge and belief and shows all the information required by law and the regulations issued and prescribed by the Office of Oil and Gas.

Bruce Nelson
Signature

Storage Engineer
Title

2/19/2026
Date

RECEIVED
Office of Oil and Gas
MAR 09 2026
WV Department of
Environmental Protection

04/17/2026