



Diversified Gas & Oil Corporation
 100 Diversified Way
 Pikeville KY, 41051

47-103-01524

Well Plugging Map

Legend

- Well
- Pits
- Pad
- Access Road
- Public Roads

RECEIVED
 Office of Oil and Gas
 OCT 08 2025
 WV Department of
 Environmental Protection




1" = 50'

0 25 50

0 25 50

0 25 50

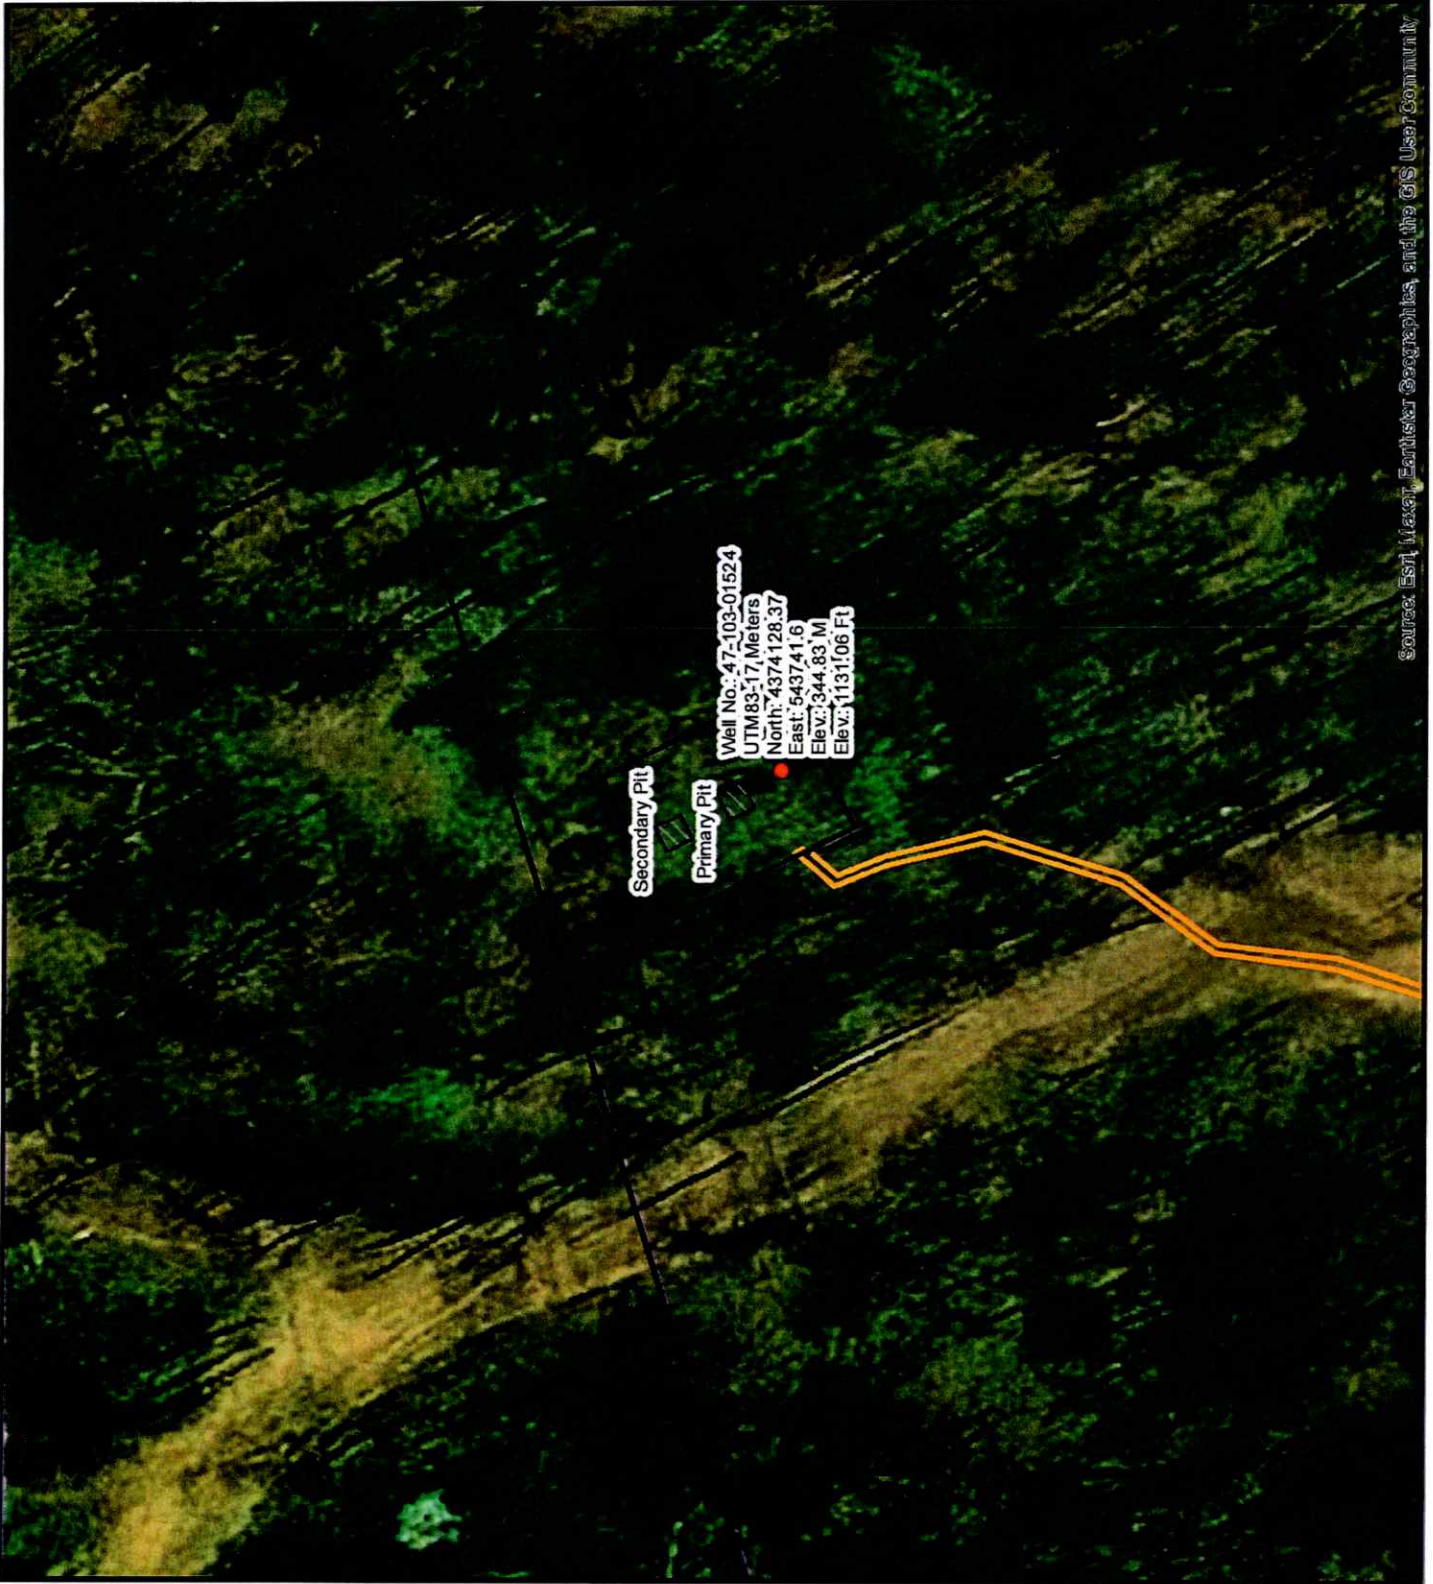



Diversified Gas & Oil
Corporation
100 Diversified Way
Pikeville KY, 41051

47-103-01524

Well Plugging Map



Legend

- Well
- Pits
- Pad
- Access Road
- Public Roads

RECEIVED
Office of Oil and Gas

OCT 08 2025

WV Department of
Environmental Protection

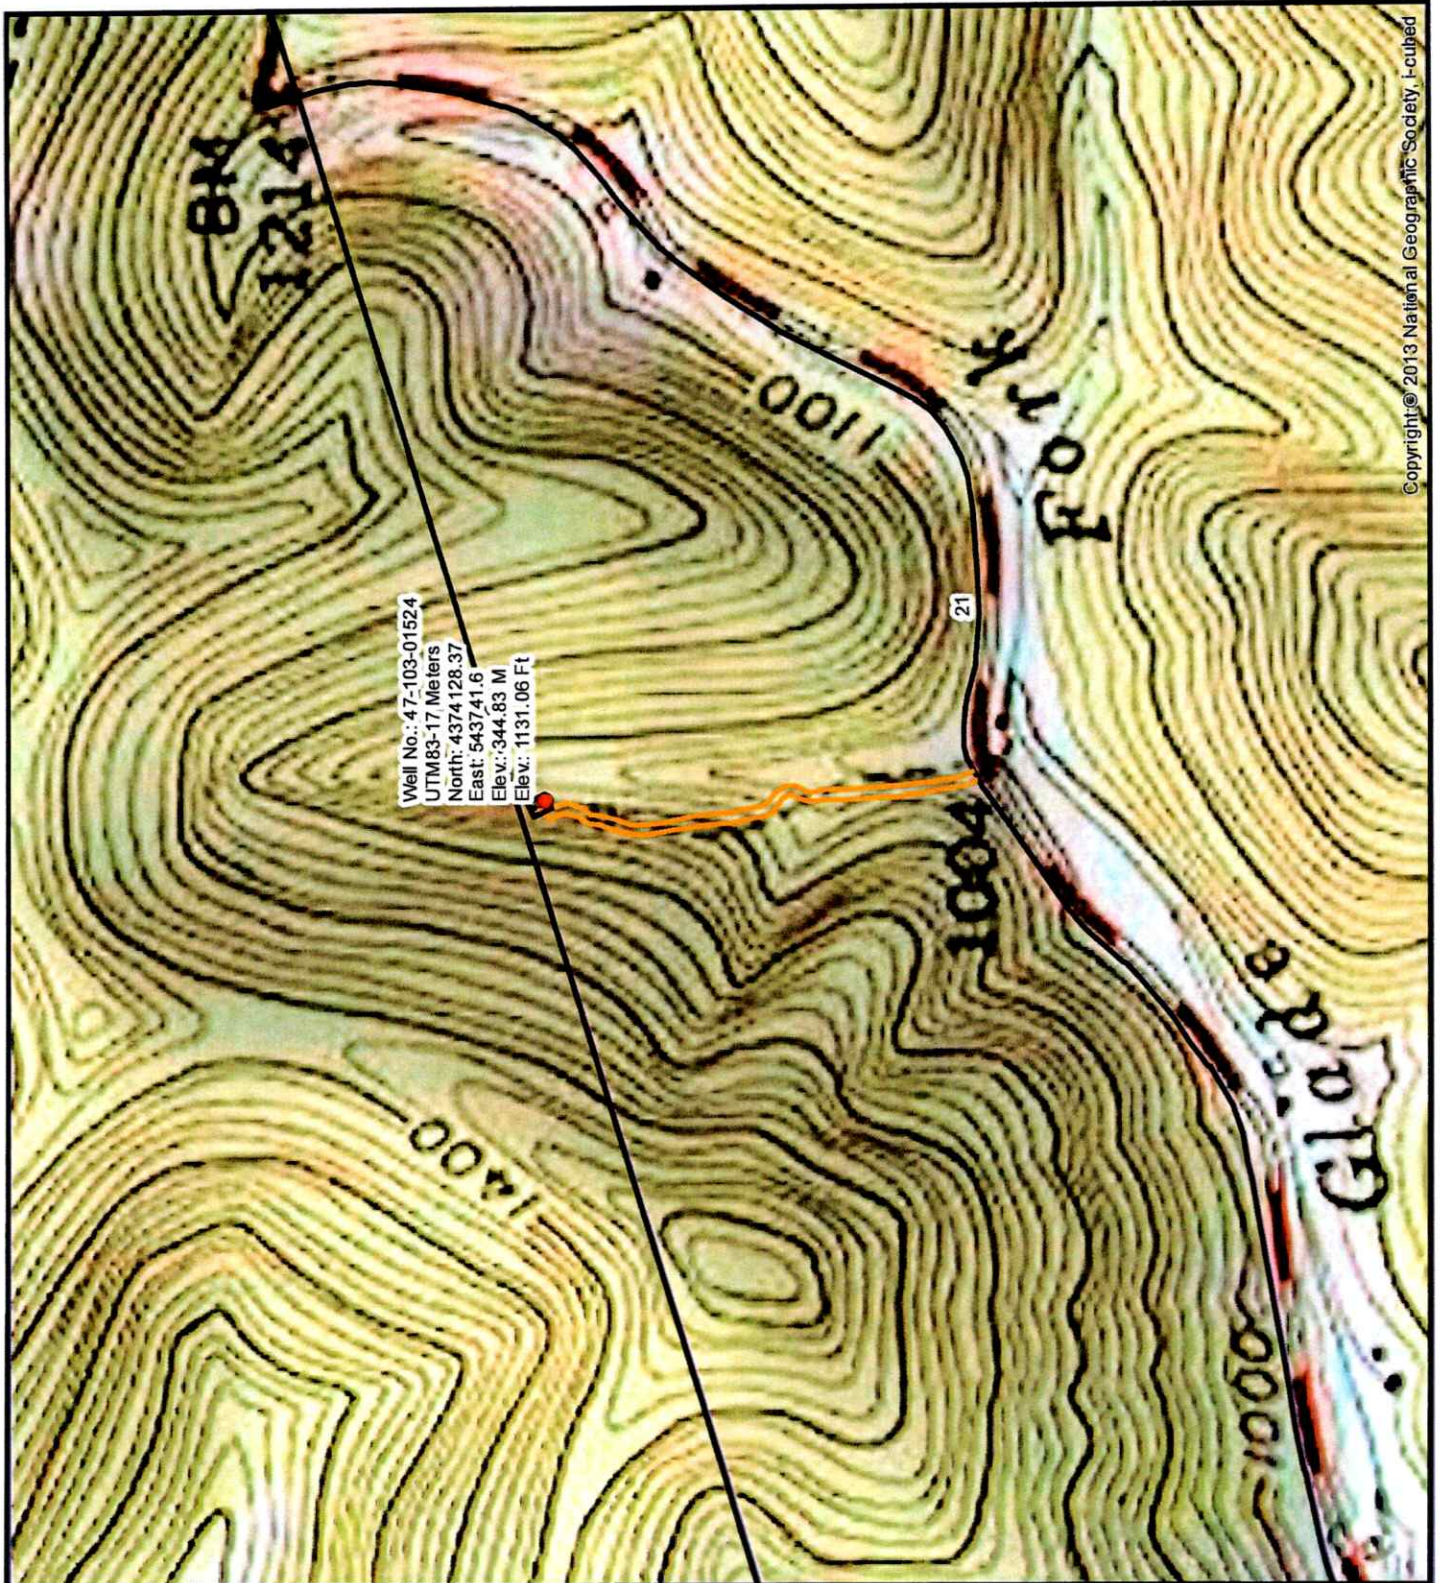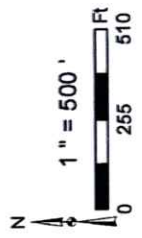

Copyright © 2013 National Geographic Society, Inc.

11/07/2025

WW-7
8-30-06



West Virginia Department of Environmental Protection
Office of Oil and Gas
WELL LOCATION FORM: GPS

API: 4710301524 WELL NO.: WJ Price #1

FARM NAME: Price

RESPONSIBLE PARTY NAME: Diversified Production, LLC

COUNTY: Wetzel DISTRICT: Grant

RECEIVED
Office of Oil and Gas

QUADRANGLE: Glover Gap 7.5'

OCT 08 2025

SURFACE OWNER: Joseph Rex Smith

WV Department of
Environmental Protection

ROYALTY OWNER: Unknown Royalty Owners

UTM GPS NORTHING: 4374128.37

UTM GPS EASTING: 543741.6 GPS ELEVATION: 1131.06'

The Responsible Party named above has chosen to submit GPS coordinates in lieu of preparing a new well location plat for a plugging permit or assigned API number on the above well. The Office of Oil and Gas will not accept GPS coordinates that do not meet the following requirements:

1. Datum: NAD 1983, Zone: 17 North, Coordinate Units: meters, Altitude: height above mean sea level (MSL) – meters.
2. Accuracy to Datum – 3.05 meters
3. Data Collection Method:

Survey grade GPS ____ : Post Processed Differential ____


Real-Time Differential ____

Mapping Grade GPS X : Post Processed Differential X

Real-Time Differential ____

4. Letter size copy of the topography map showing the well location.

I the undersigned, hereby certify this data is correct to the best of my knowledge and belief and shows all the information required by law and the regulations issued and prescribed by the Office of Oil and Gas.

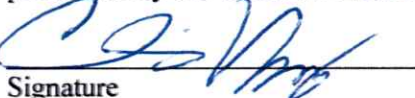
Signature

Chris Veazey - Director of Administration

Title

10/01/2025
Date

11/07/2025